


LEHIGH & WILKES BARRE COAL CO

STANTON COLIERIES

AGREEMENT BARRIER PILLAR FEB. 1917

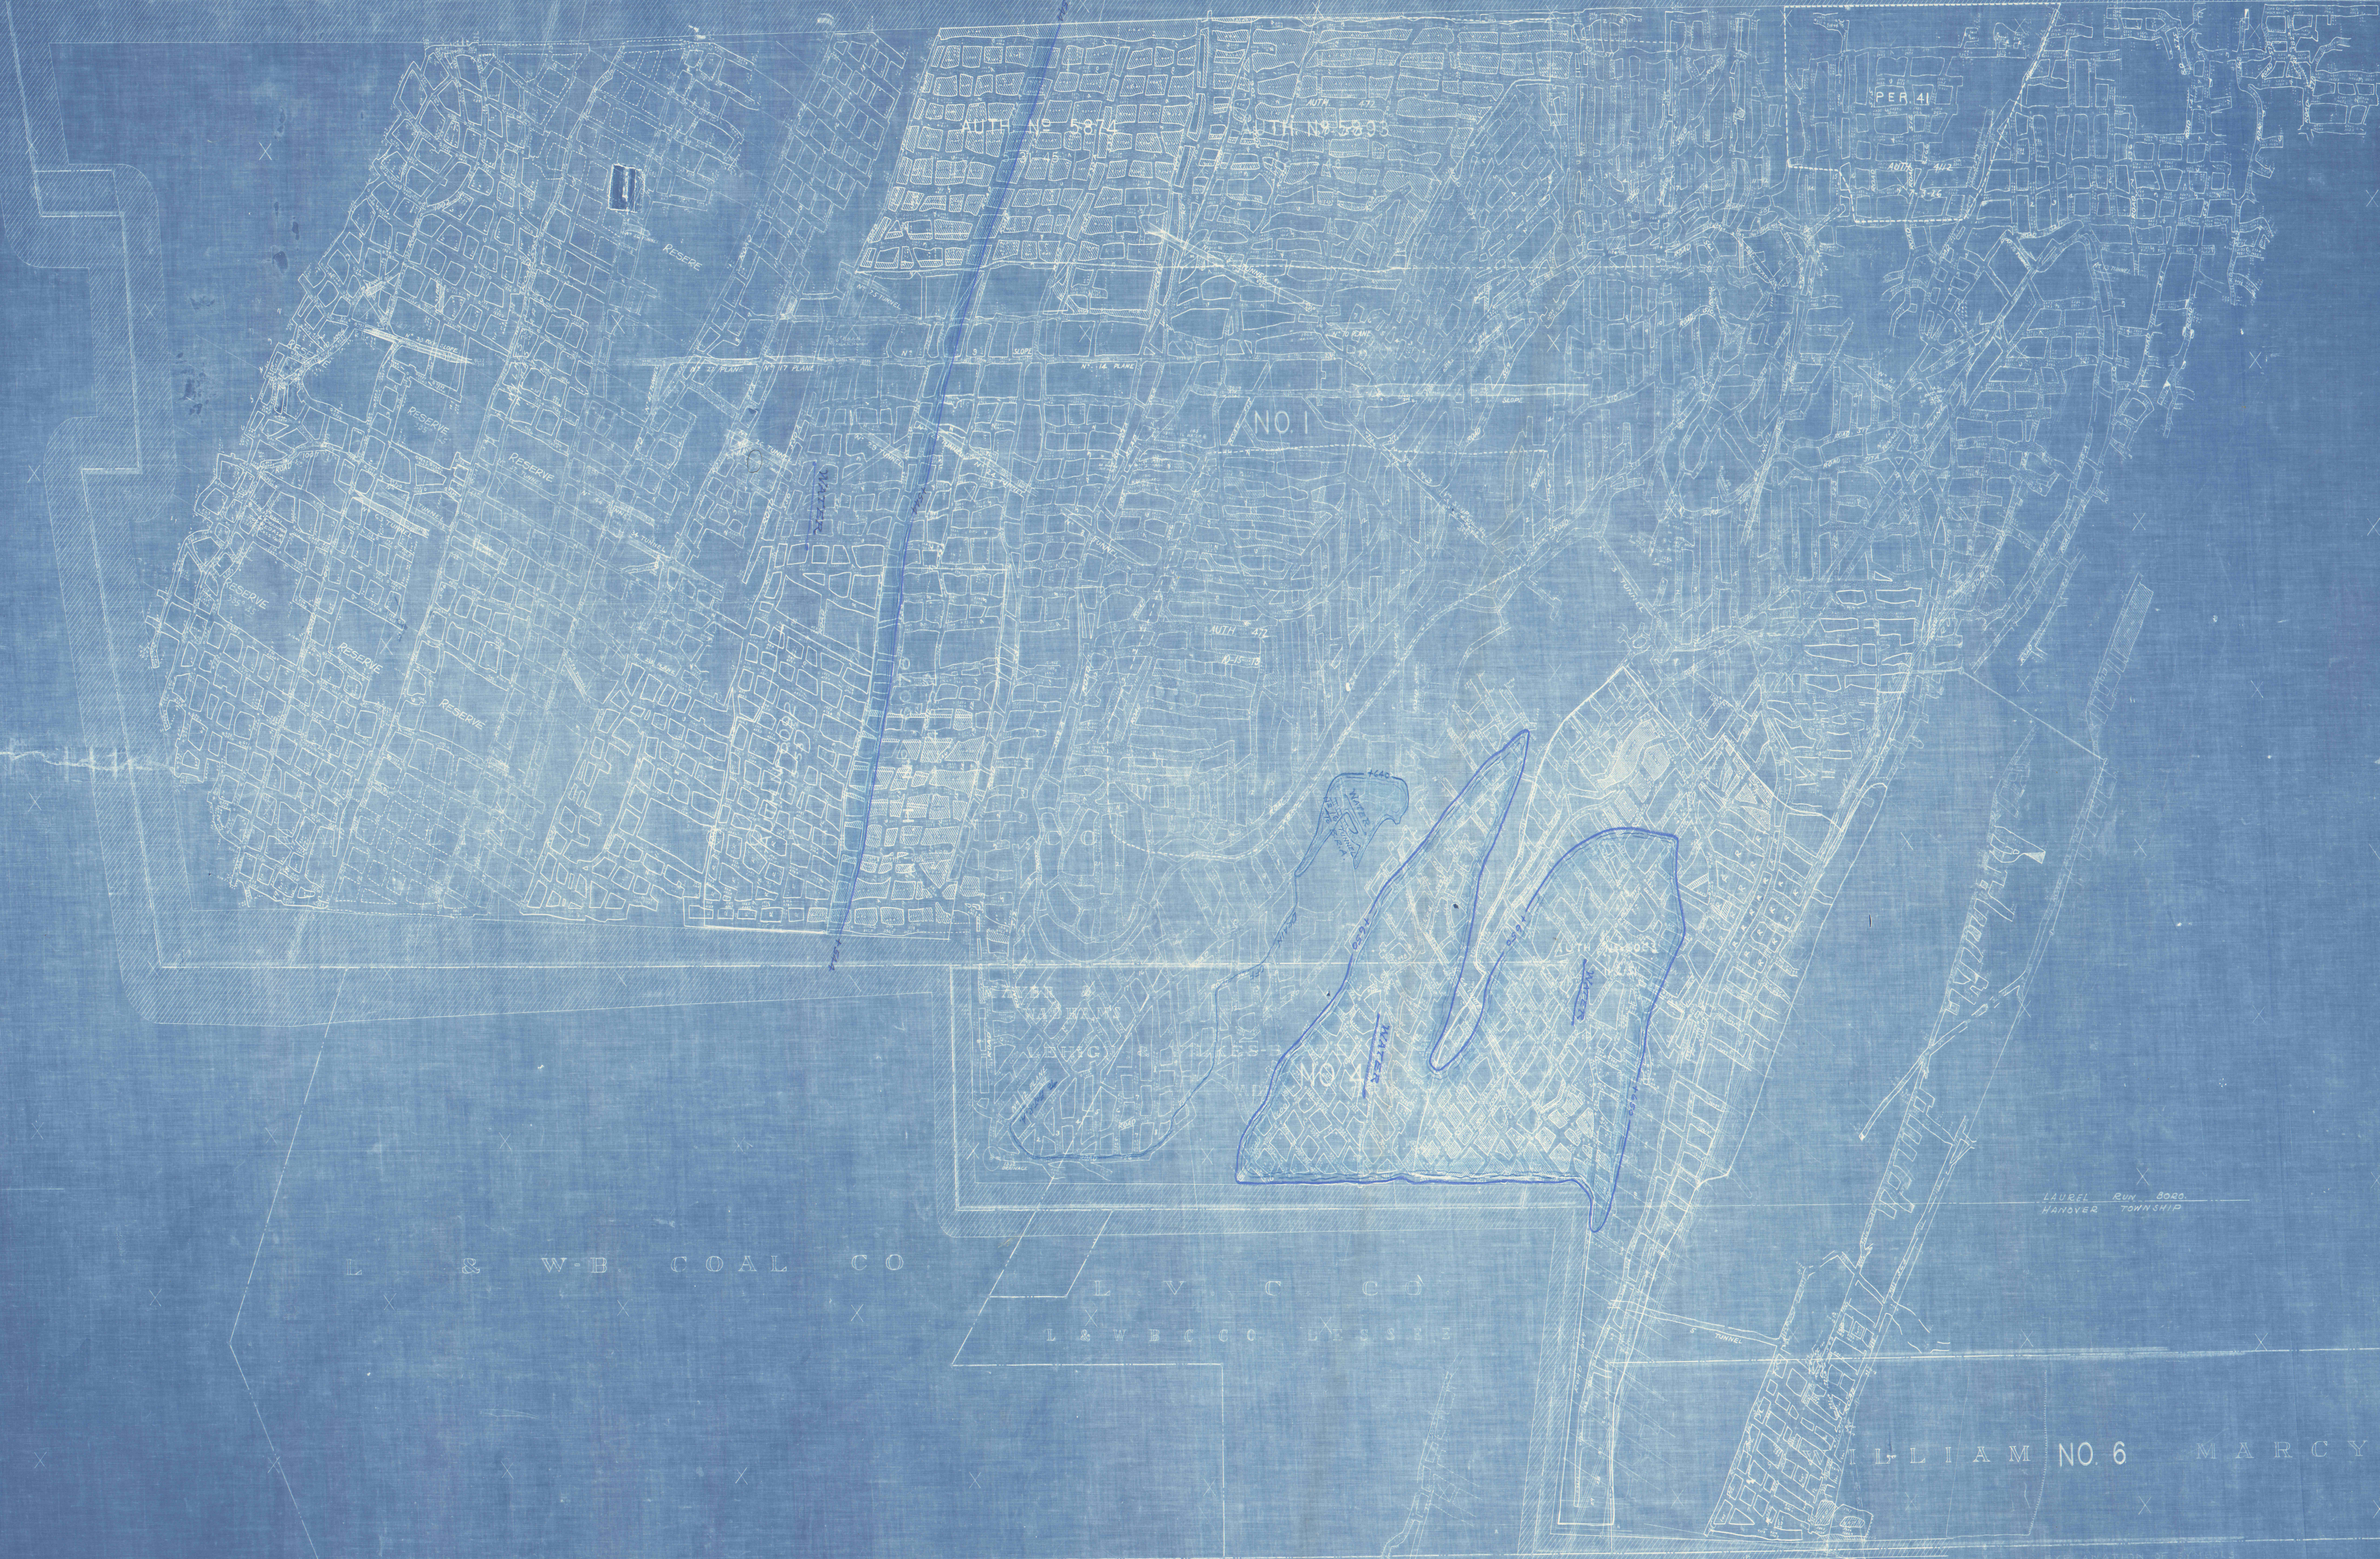

L & W-B COAL CO

L & W-B COAL CO

L & W-B COAL CO

WILLIAM NO. 6 MARCY

LEHIGH & WILKES BARRE COAL CO

MAXWELL COLIERIES

NORTHERN COAL FIELD
FRANKLIN COLLIERY
LUZERNE COUNTY, WILKES-BARRE TWP., HANOVER TWP.,
WILKES-BARRE, PA.

TOP RED ASH VEIN

SCALE 100 FT. = 1 IN. DATUM 500 FT. BELOW TIDE.

MF
DEC 12 1917