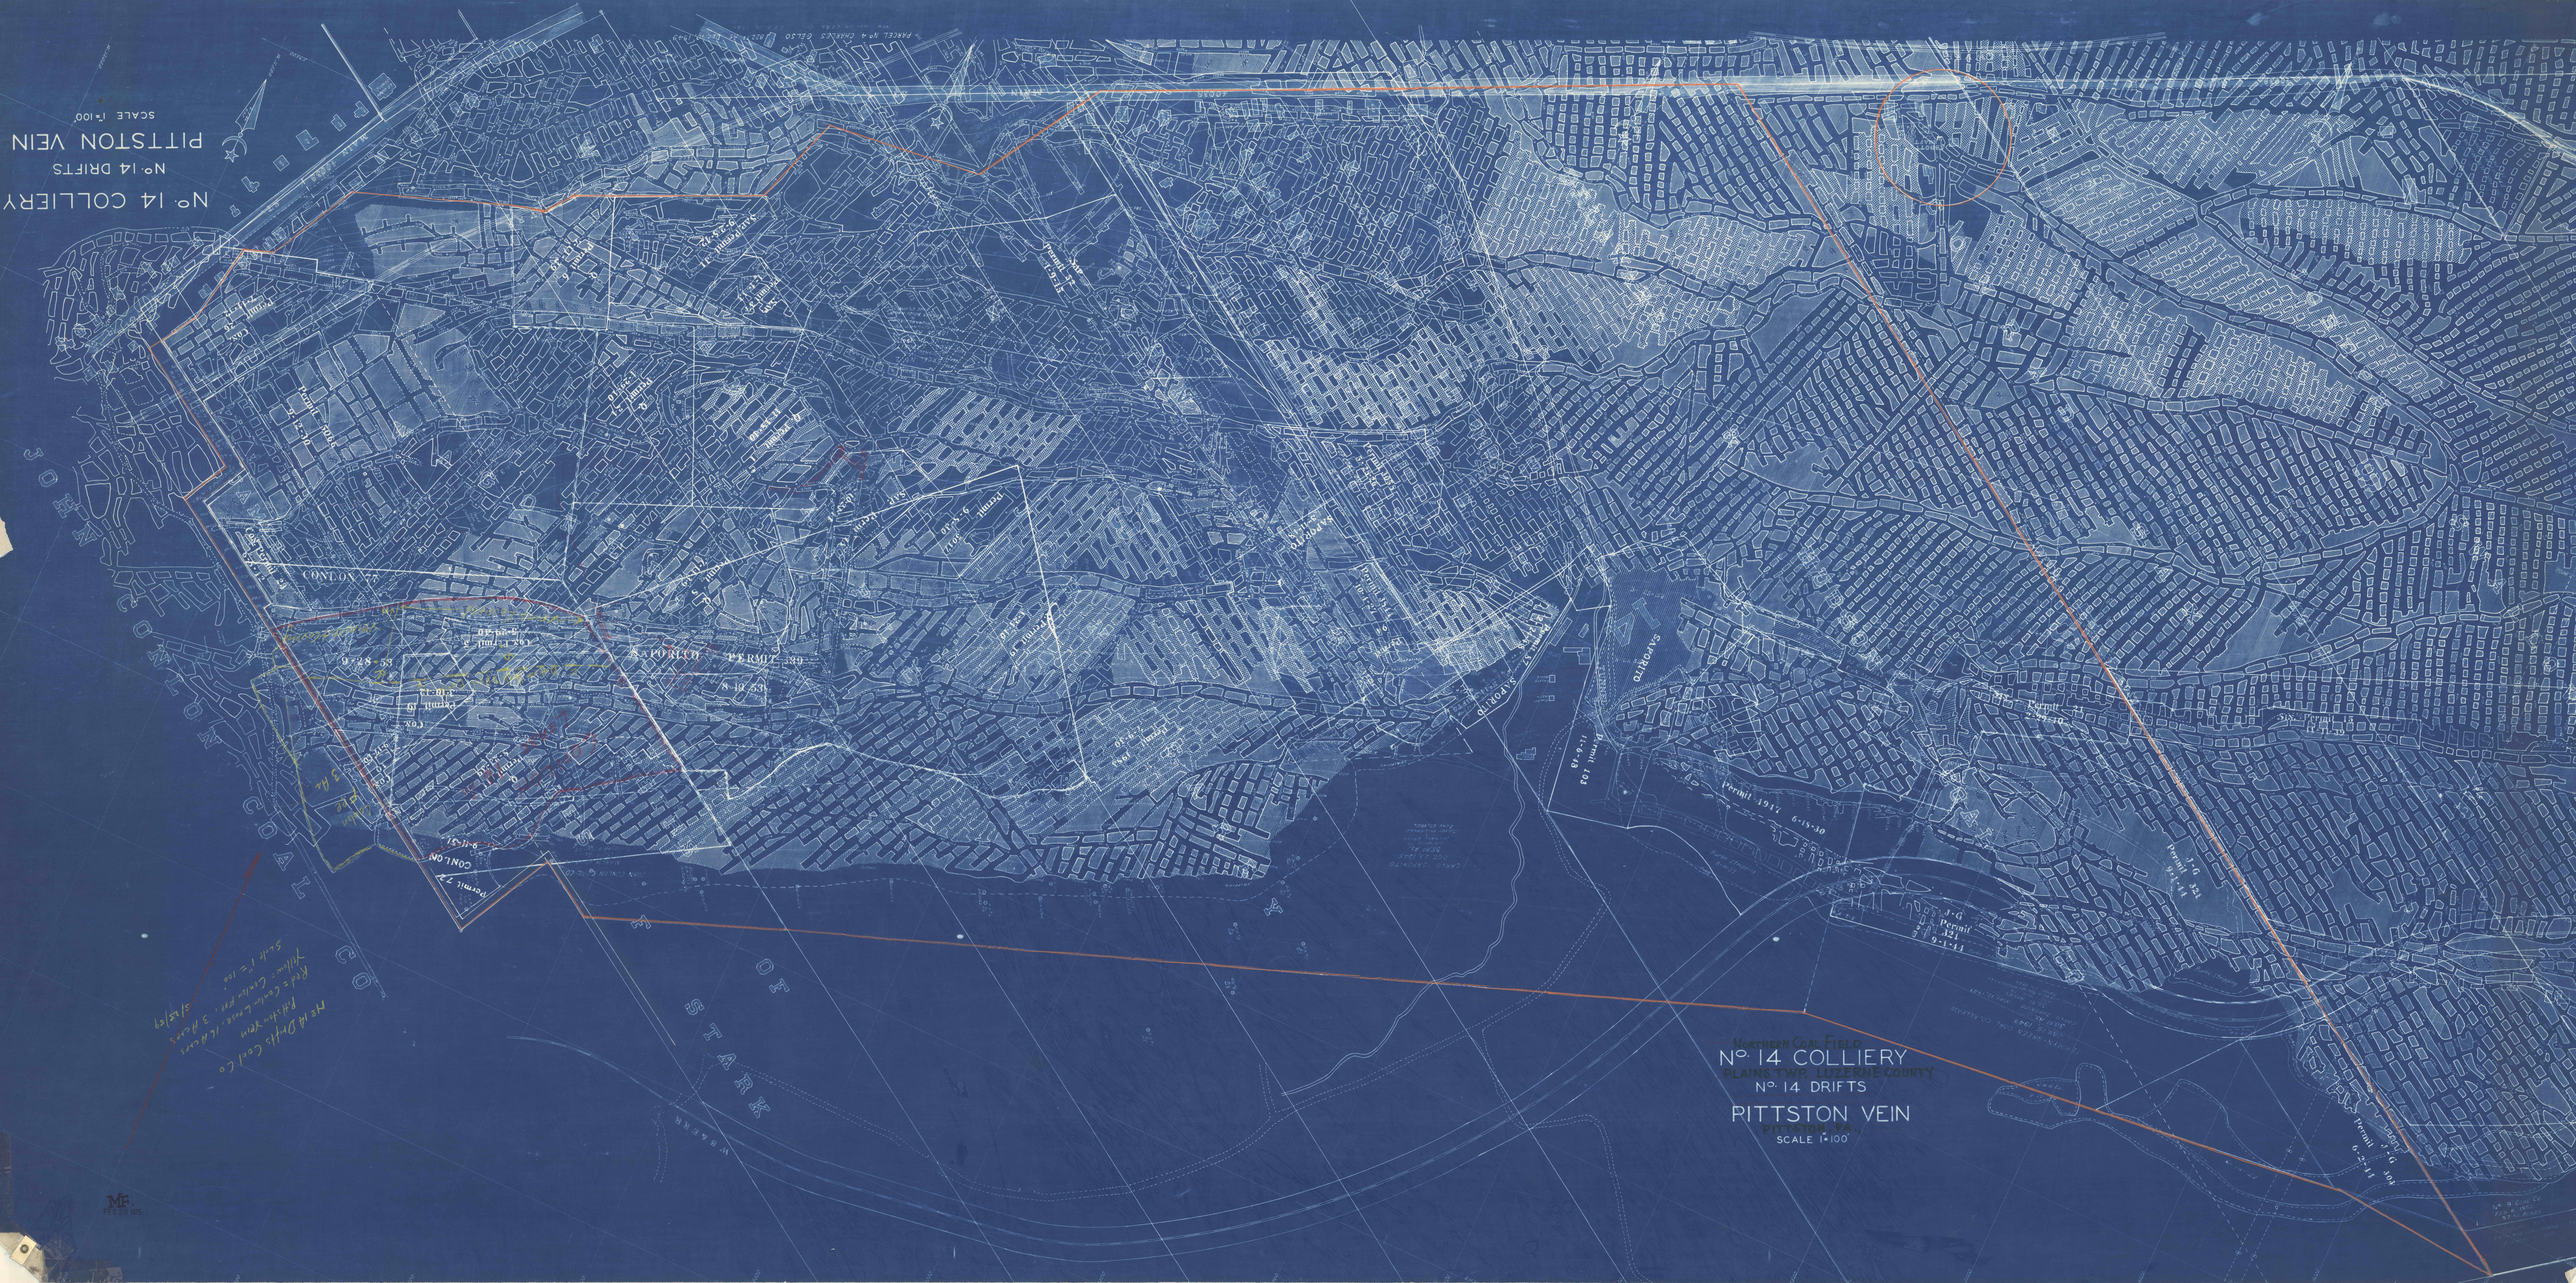

No. 14 COLLIERY
No. 14 DRIFTS
PITTSTON VEIN
SCALE 1"=100'
NORTHERN COAL FIELD
No. 14 COLLIERY
PLAINS TWP. LUZERNE COUNTY
No. 14 DRIFTS
PITTSTON VEIN
PITTSTON, PA.
SCALE 1"=100'
CONLON
PERMIT 339
Permit 1911
Permit 1912
Permit