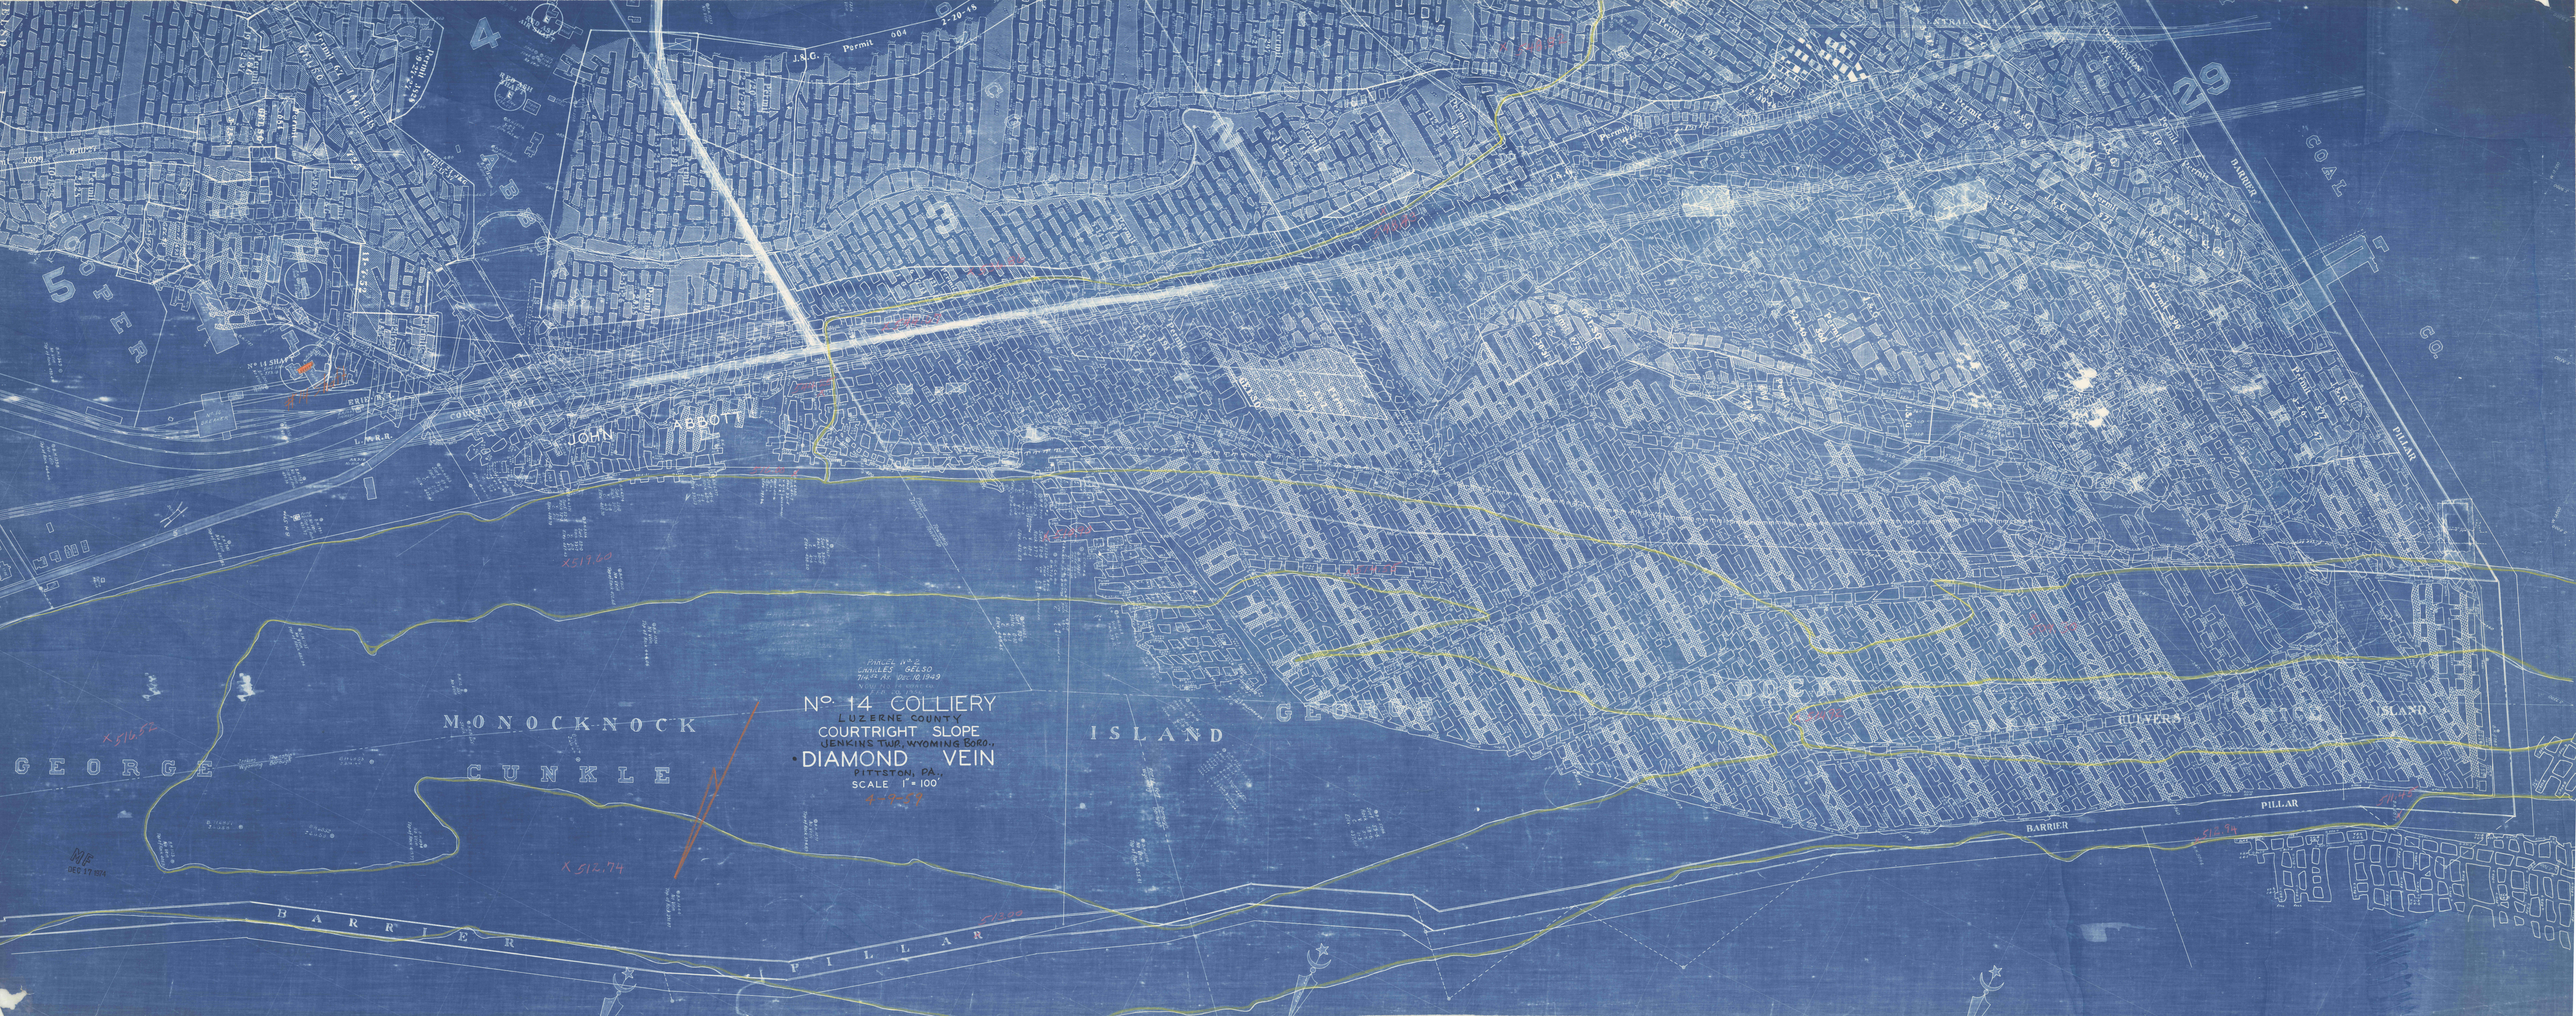

29
COAL CO.
BARRIER PILLAR
BARRIER
PILLAR
ISLAND
CULVERS
RICE
DOCK
GEORGE
ISLAND
MONOCKNOCK
CUNKLE
GEORGE
JOHN ABBOTT
L.W.R.R.
ERIE R.R.
COUNTY ROAD
No 14 SHAFT
No 14 BREAKER
RED ASH SHAFT
RED ASH AIR SHAFT
2
3
4
5
X 512.74
X 516.52
X 519.60
513.00
B.H. 1071 No Vein Top of Rock 394.89
B.H. 1022 Surf. 83-0 Slate 0-10 V. 4-1 C. 4-0 Elev. 449.45
PARCEL No. 1 JERMYN & M^c GREEN ASSIGNED TO JERMYN GREEN COAL CO. 5-29-37
J.&G. Permit 604 2-20-48

PARCEL No. 2
CHARLES GELSO
714.52 As. DEC. 10, 1949
NOW NO. 14 COAL CO.
FEB. 20, 1956.

No. 14 COLLIERY
LUZERNE COUNTY
COURTRIGHT SLOPE
JENKINS TWP., WYOMING BORO.,
DIAMOND VEIN
PITTSTON, PA.,
SCALE 1" = 100'

4-9-59

MF
DEC 17 1974