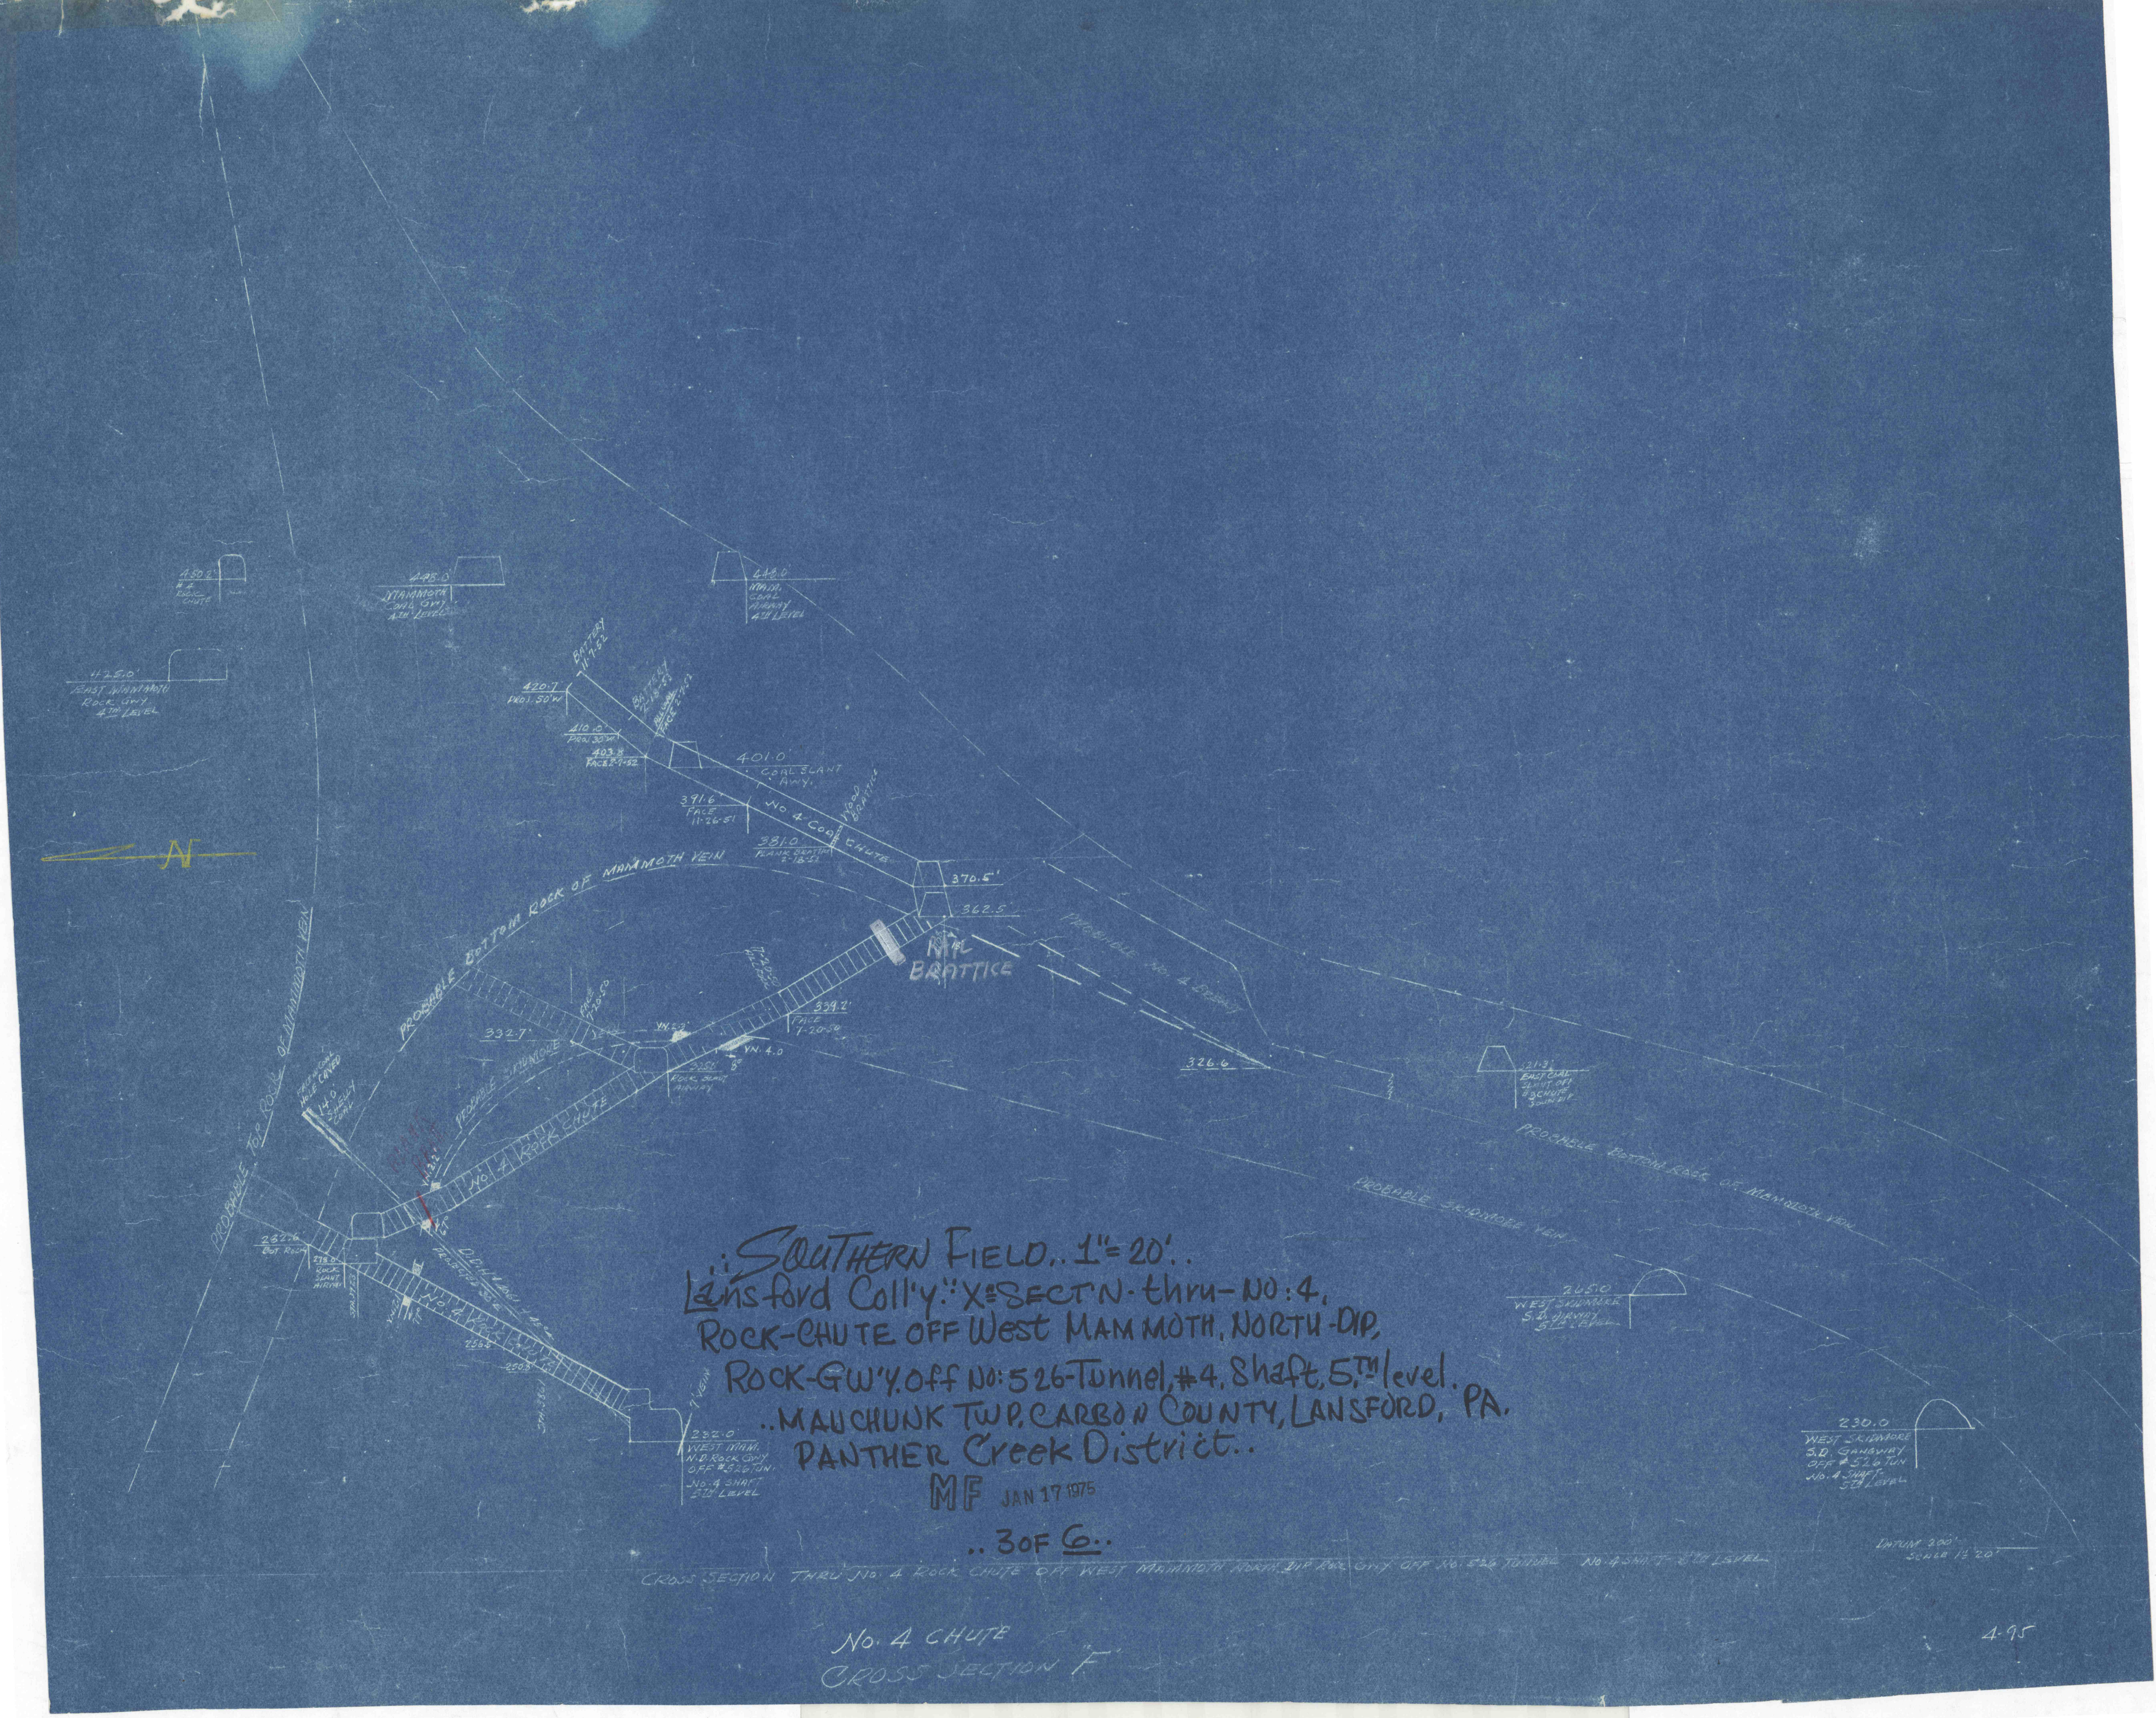

..SOUTHERN FIELD.. 1" = 20'..
Lansford Coll'y.: X-SECT'N-thru-NO: 4.
ROCK-CHUTE OFF West MAMMOTH, NORTH-DIP,
ROCK-GW'Y. Off NO: 526-Tunnel, #4. Shaft, 5th level.
..MAUCHUNK TWP. CARBON COUNTY, LANSFORD, PA.
PANTHER Creek District..
MF JAN 17 1975
..3 OF 6..
PROBABLE BOTTOM ROCK OF MAMMOTH VEIN
PROBABLE TOP ROCK OF MAMMOTH VEIN
PROBABLE SKIDMORE VEIN
NO. 4 COAL CHUTE
NO. 4 ROCK CHUTE
BRATTICE
401.0'
COAL SLANT AWY.
370.5'
362.5'
326.6
332.7'
232.0
WEST MAM.
N.D. ROCK GWY
OFF #526 TUN.
NO. 4 SHAFT
5TH LEVEL
265.0
230.0
WEST SKIDMORE
S.D. GANGWAY
CROSS SECTION THRU NO. 4 ROCK CHUTE OFF WEST MAMMOTH NORTH DIP ROCK GWY OFF NO. 526 TUNNEL NO. 4 SHAFT 5TH LEVEL
NO. 4 CHUTE
CROSS SECTION "F"
4.95