


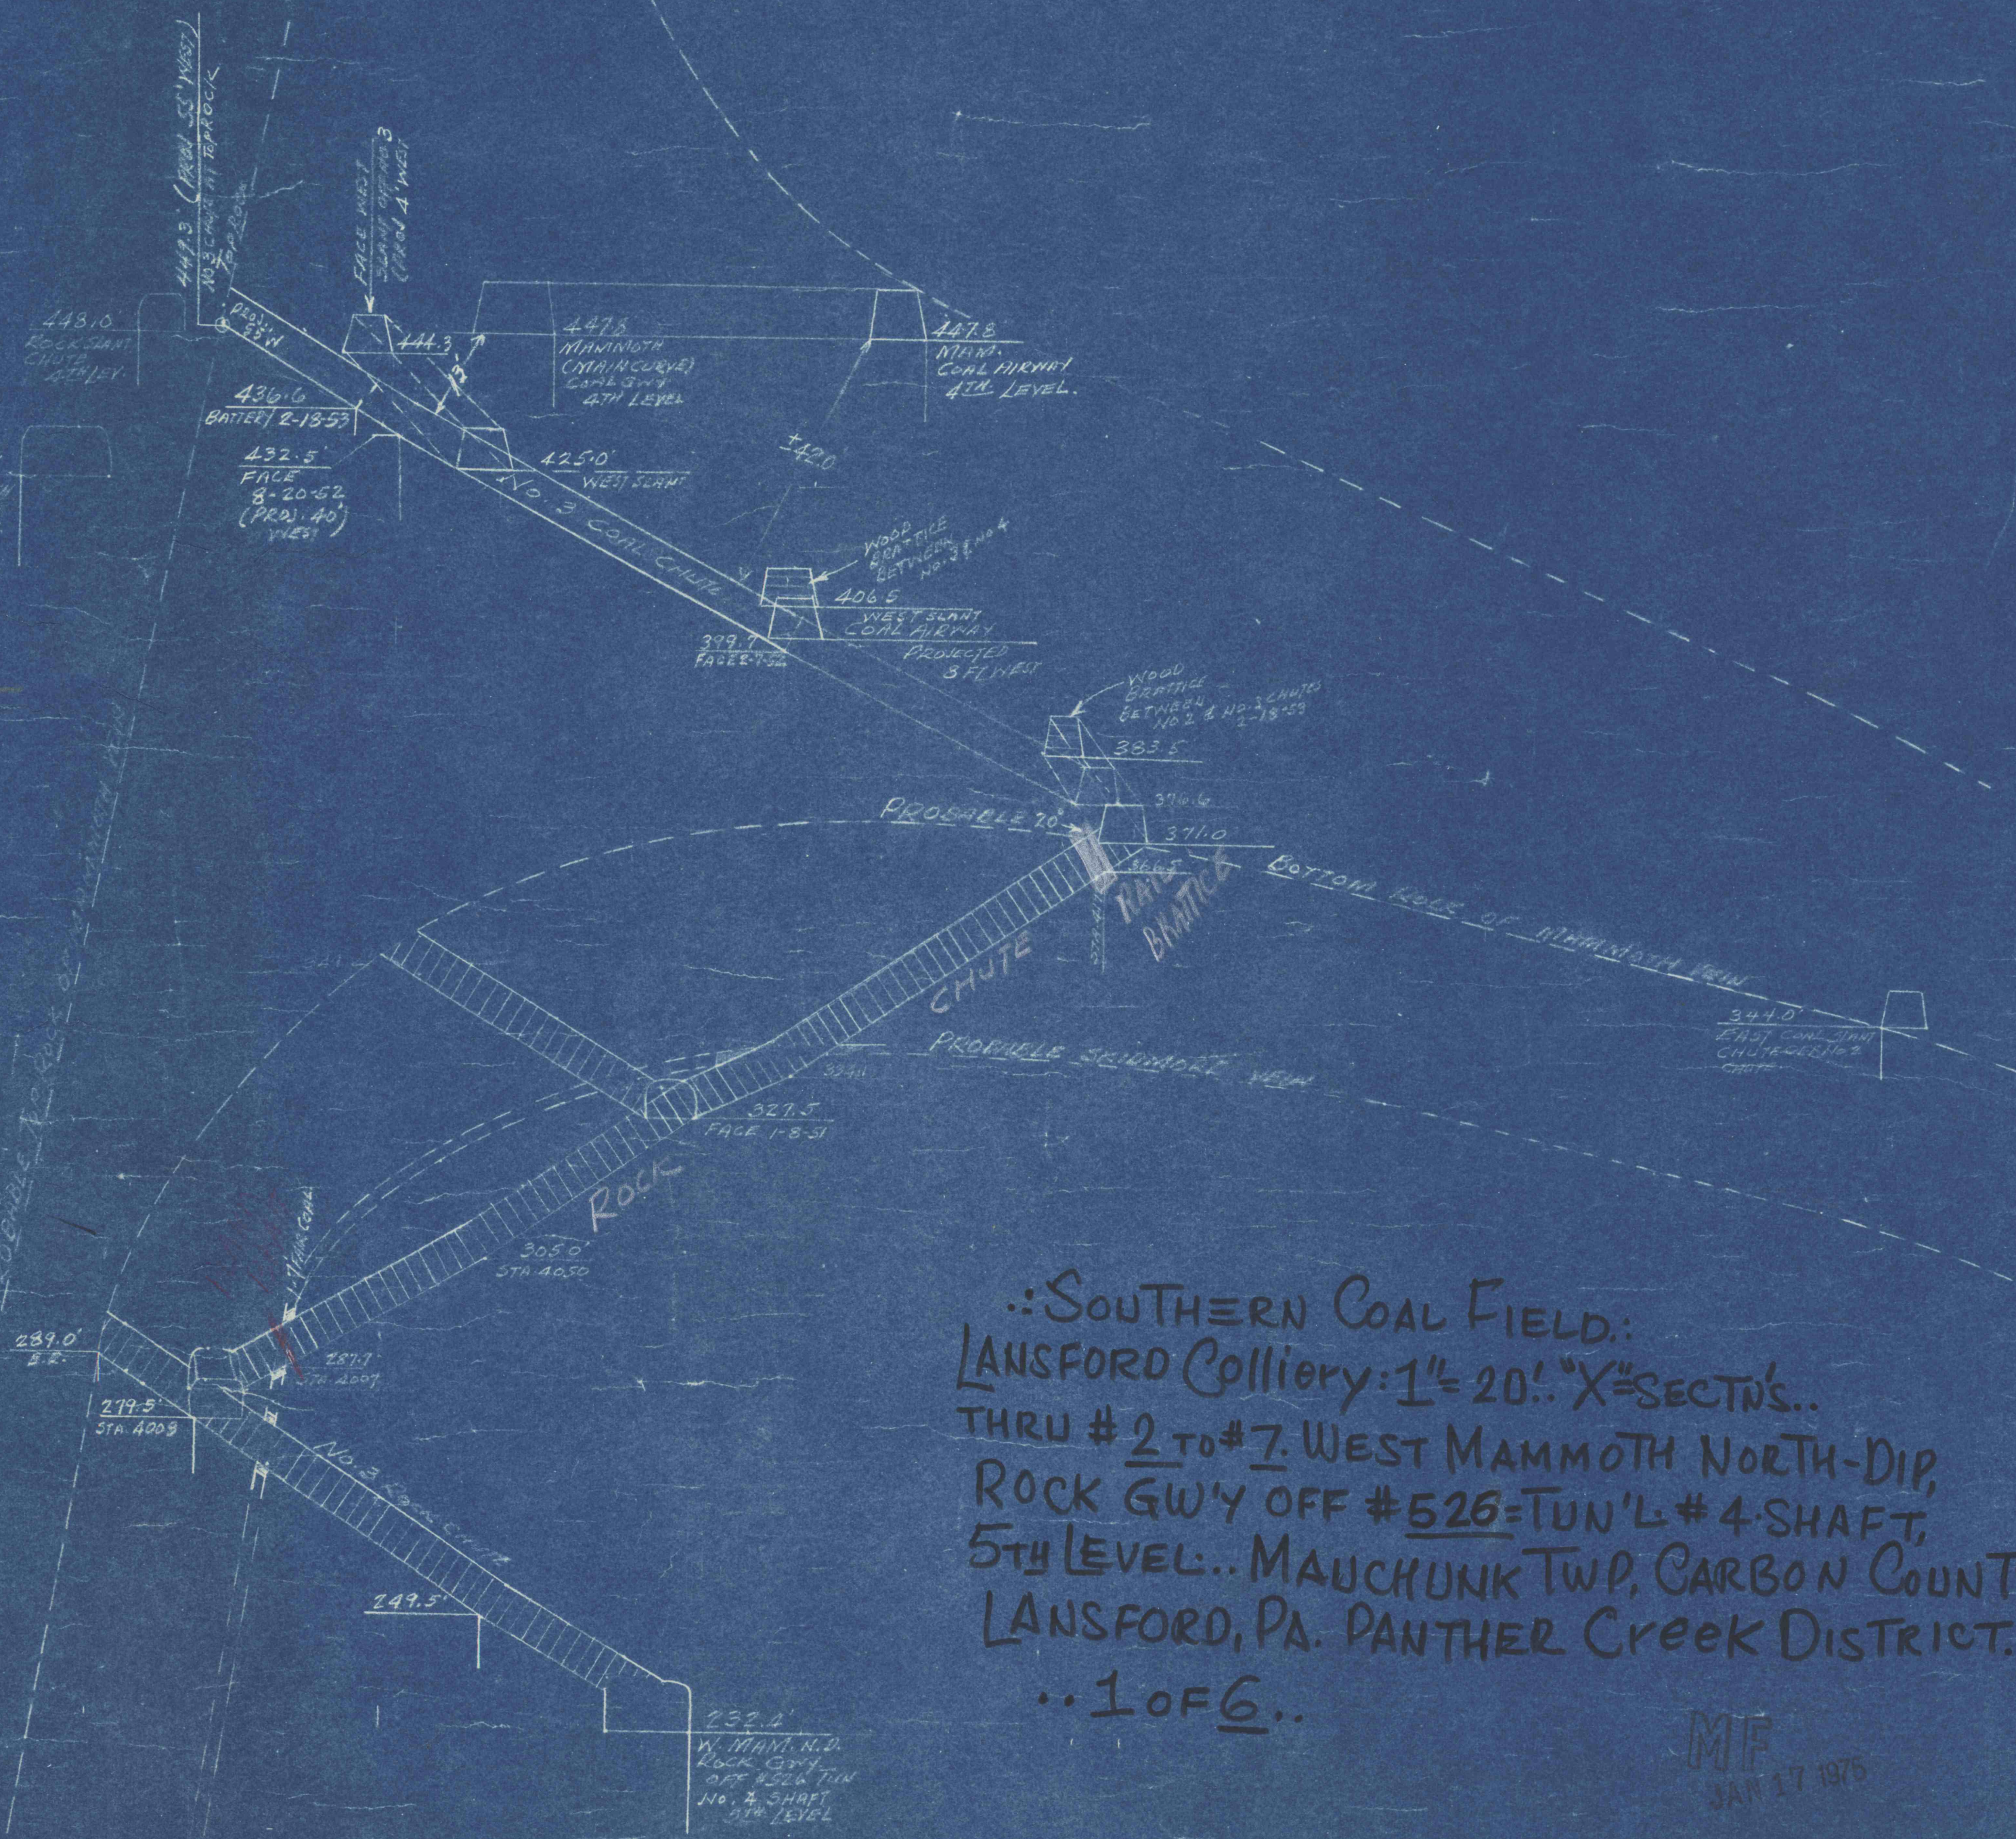

:: SOUTHERN COAL FIELD:
 LANSFORD Colliery: 1" = 20' "X" = SECT'NS..
 THRU # 2 TO # 7. WEST MAMMOTH NORTH-DIP,
 ROCK GW'Y OFF # 526 = TUN'L # 4-SHAFT,
 5TH LEVEL.. MAUCHUNK TWP, CARBON COUNTY, PA.
 LANSFORD, PA. PANTHER CREEK DISTRICT. 13.
 .. 1 OF 6..

MF
 JAN 17 1975

CROSS SECTION THRU NO 3 ROCK CHUTE OFF WEST MAMMOTH NORTH DIP ROCK GUAHWAY OFF NO. 526 TUNNEL NO. 4 SHAFT 5TH LEVEL

No. 3 CHUTE
 SECTION G

DATUM 200.0'
 SCALE 1"=20'