


2800
2800
880

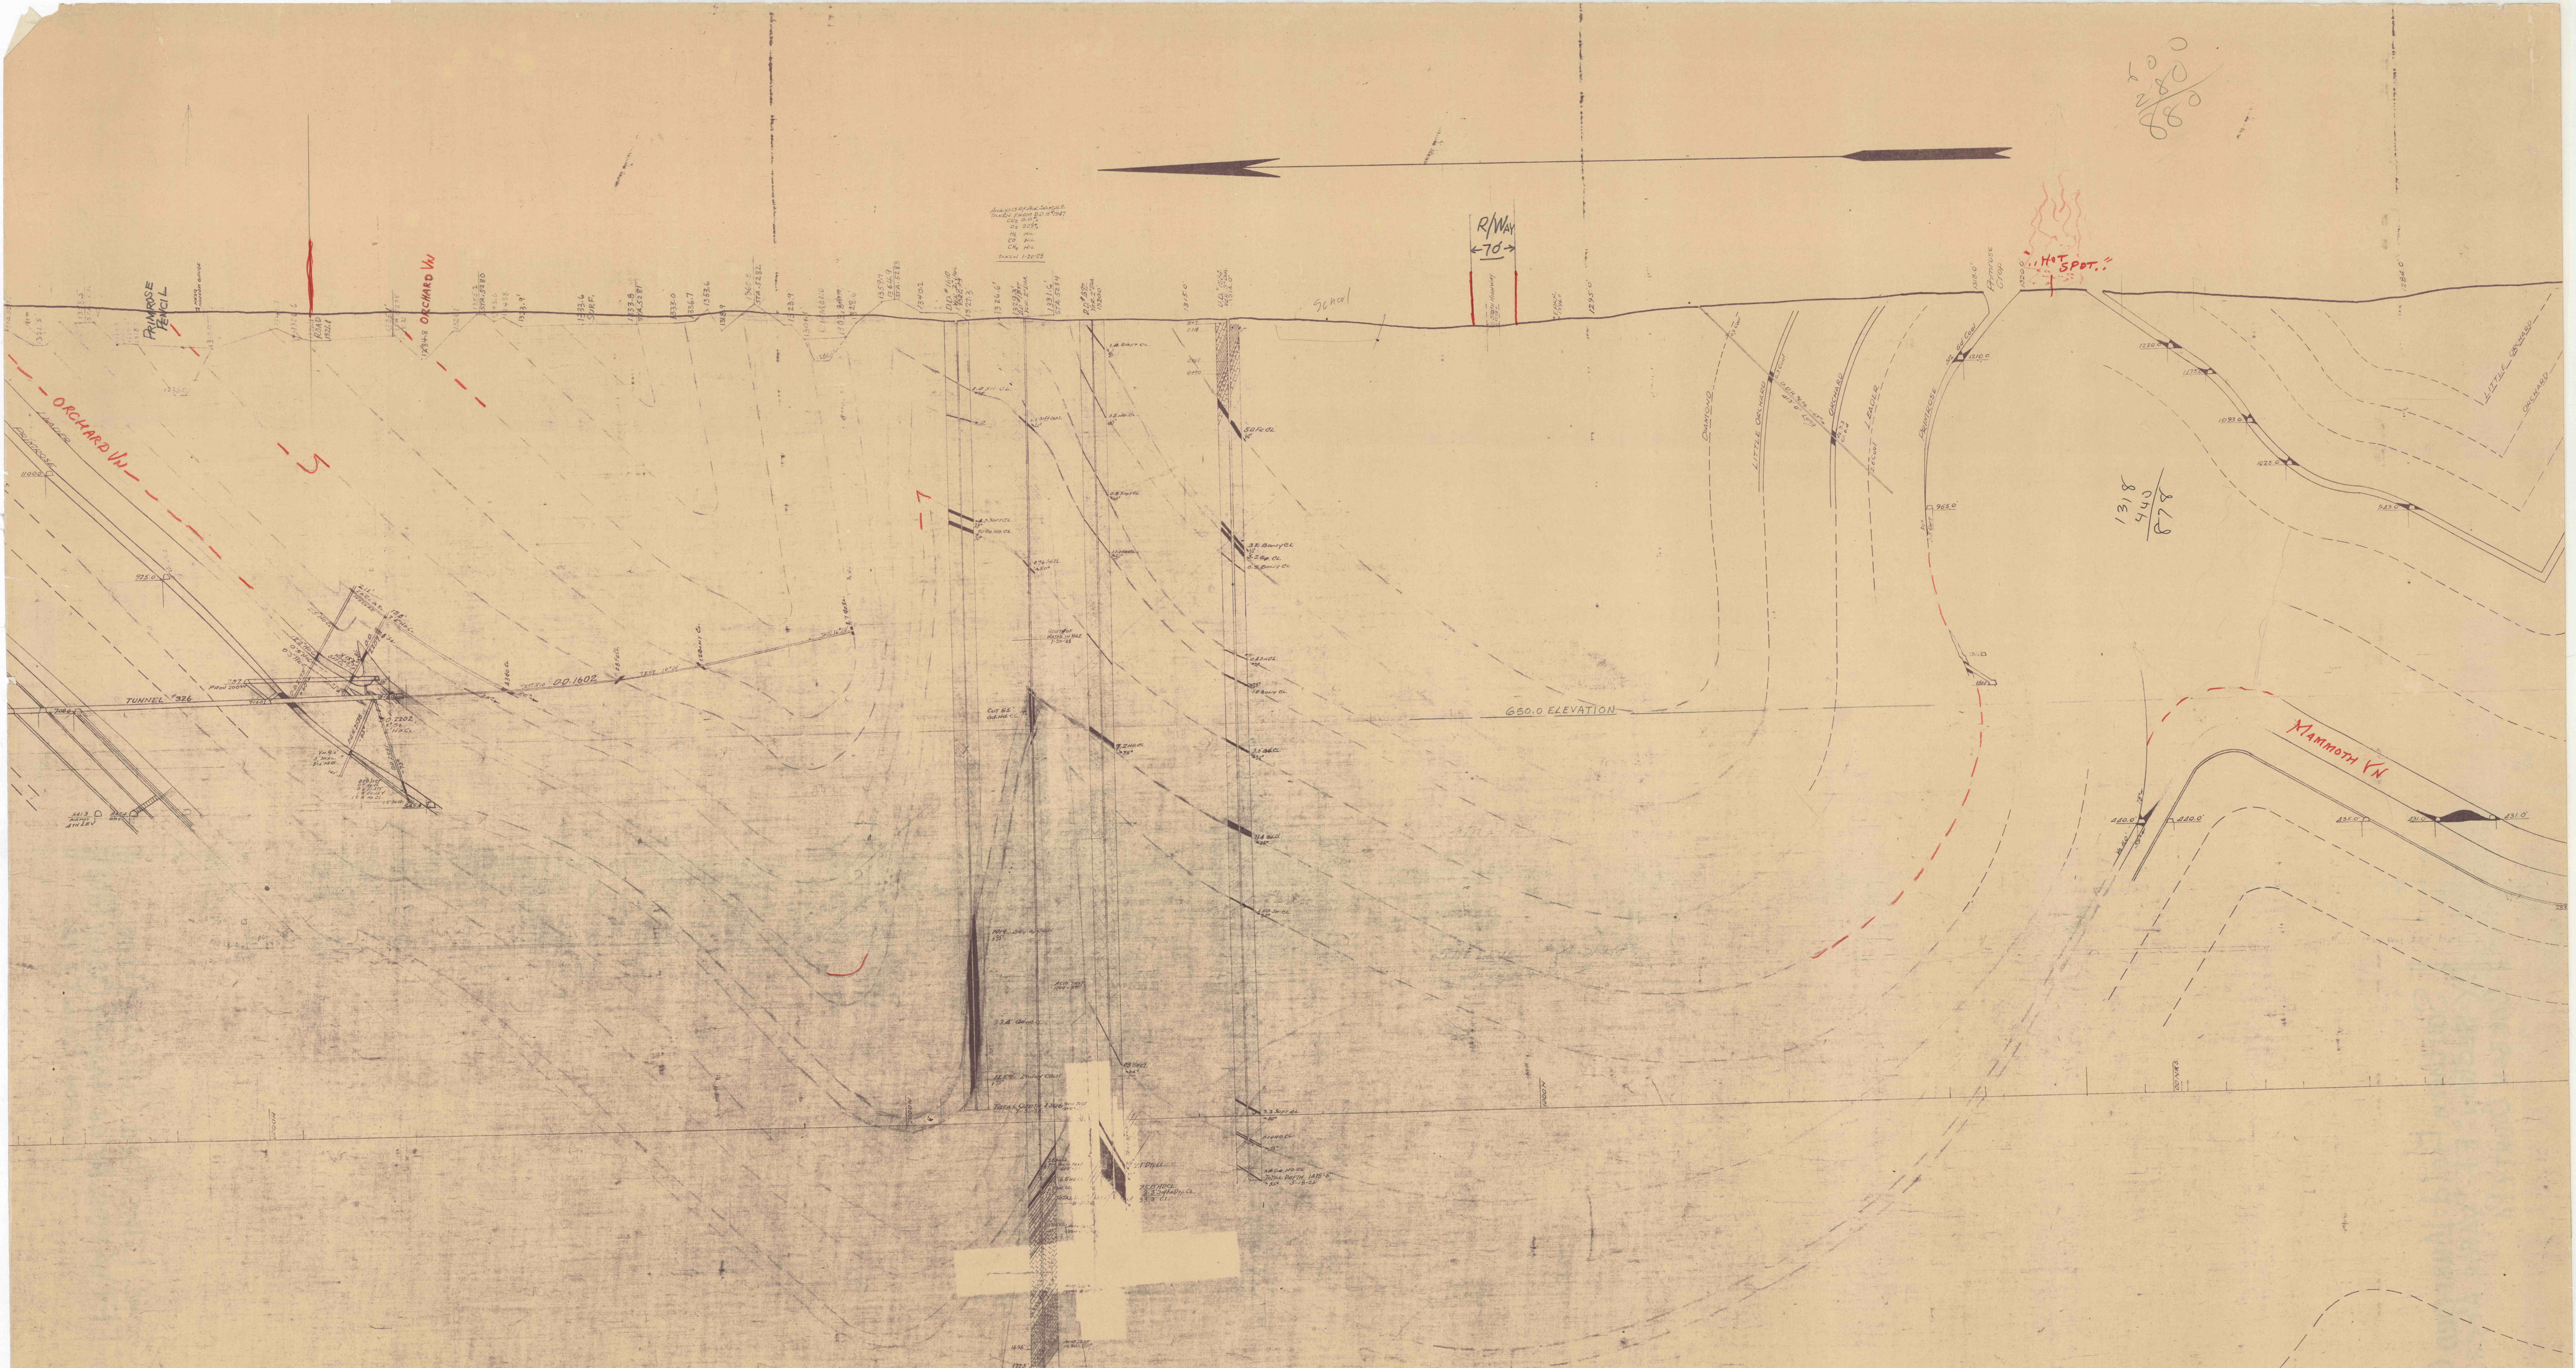

SOUTHERN FIELD..1"=100'.
LANSFORD COLLIERY SECTION "F-F" VAPOR AREA..
MAUCH CHUK TWP. CARBON COUNTY, PA..
...BLACK CREEK DISTRICT...

SEC. F F
1"=100'