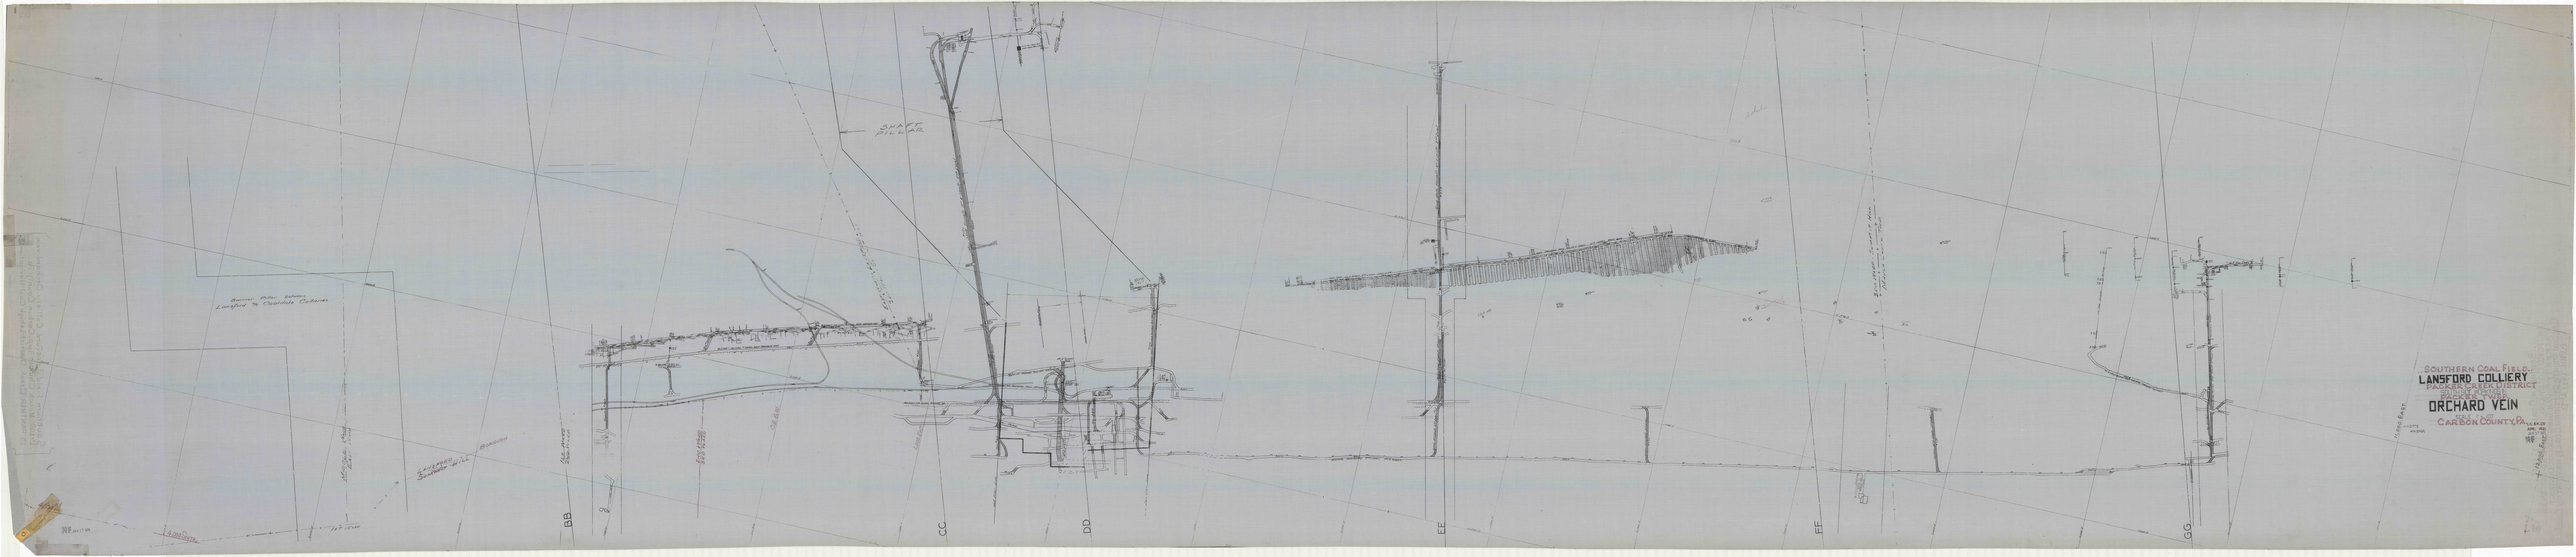

BB
CC
DD
EE
FF
GG
LANSFORD COLLIERY
PANTHER CREEK DISTRICT
SECTIONS ON
ORCHARD VEIN
CARBON COUNTY, PA.