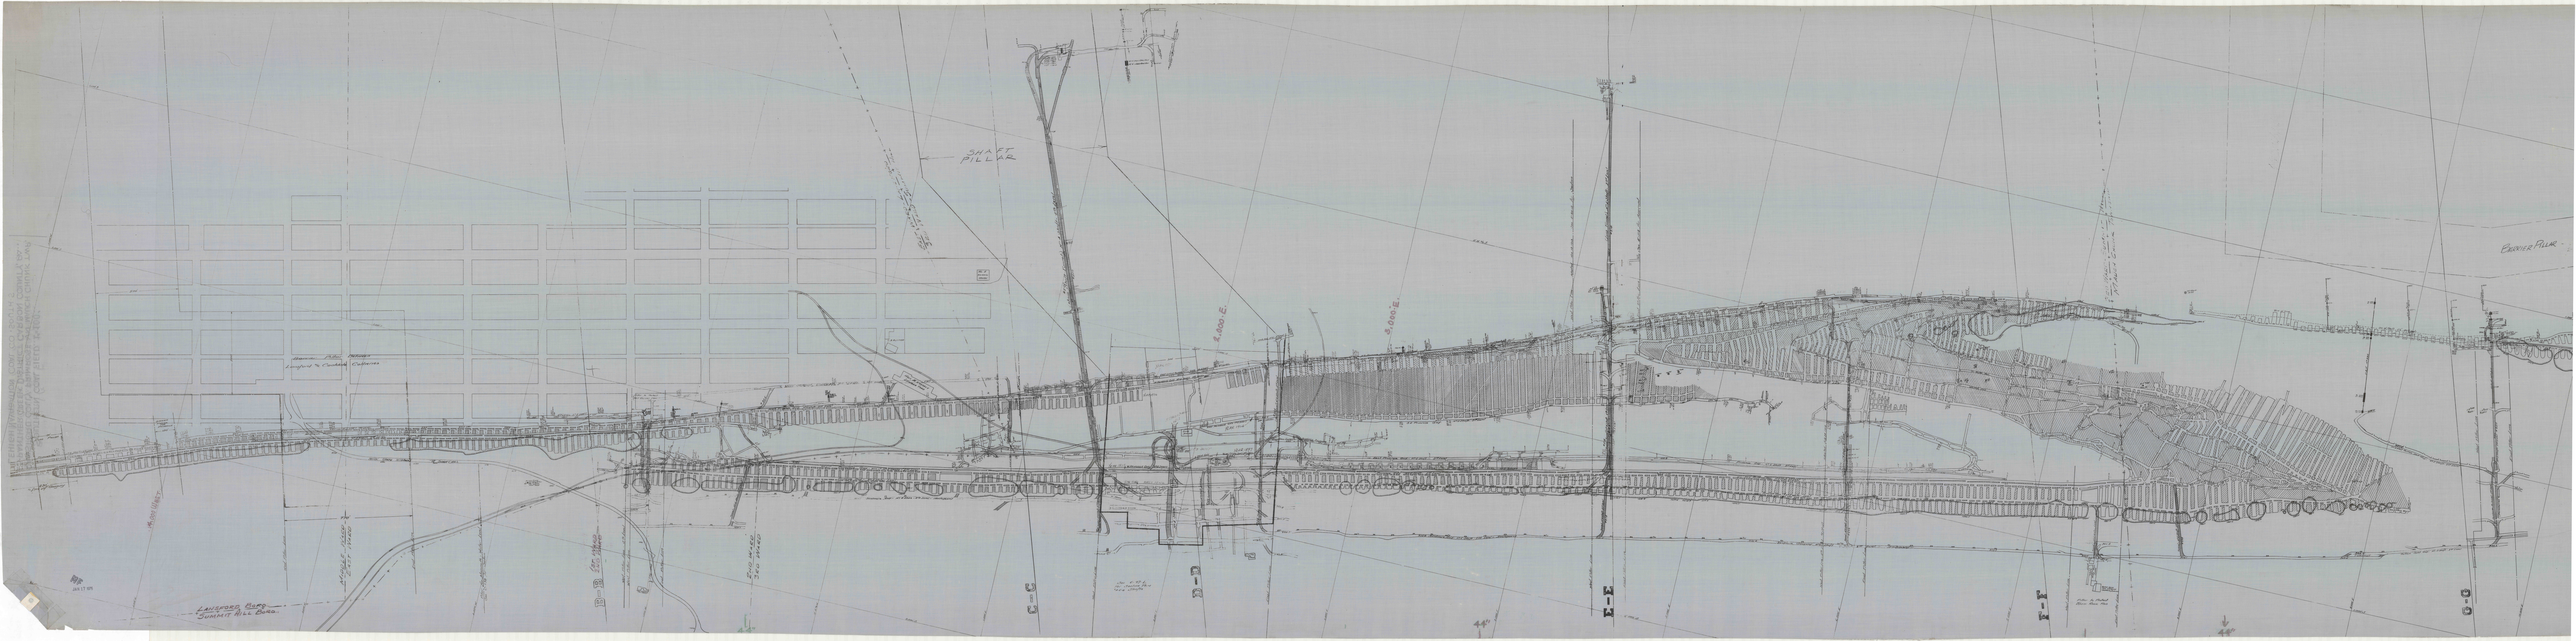

SHAFT PILLAR
4,000 E.
5,000 E.
A-A
B-B
C-C
D-D
E-E
F-F
G-G
