


DRAGON-TH' BOSS' LMB. BY
GLEN ALDEN COAL CO. PA.
VENUE NO. 11 COL. A.
1, P. 100.

EXTENDED	
MAY 1932	
MARCH 1933	
JUNE 1934	
JAN. 1935	
MAY 1936	
NOV. 1937	
SEPTEMBER 1938	

..NORTHERN FIELD..

LANCE N°11 COLLIERY

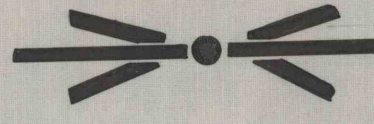

PLYMOUTH TWP, BOROUGH

KIDNEY - VEIN 1"=100'. LUZERNE COUNTY PA.,

5-PLYMOUTH DISTRICT. GLEN ALDEN COAL CO.,



LANCE N°11 COL. KIDNEY V. 1"=100'. 5-PLYMOUTH DIST. GLEN ALDEN COAL CO. PA.
BORO. PLYMOUTH TWP.