


RECORD BOOK
Plymouth Boro.
1919-1920

Extended 12/1/1921
Mar 1919
" Mar 1920
" August 1921
" May 1922
" Nov 1922
" April 1923
" Jan 1924
" Nov 1924
" Feb 1925
" Sep 1925
" Nov 1925
" Feb 1926
" Jan 1927
" Mar 1928
" March 1929

Larksville Boro.
Plymouth Boro.

Larksville Boro.
Plymouth Boro.

Larksville Boro.
Plymouth Boro.

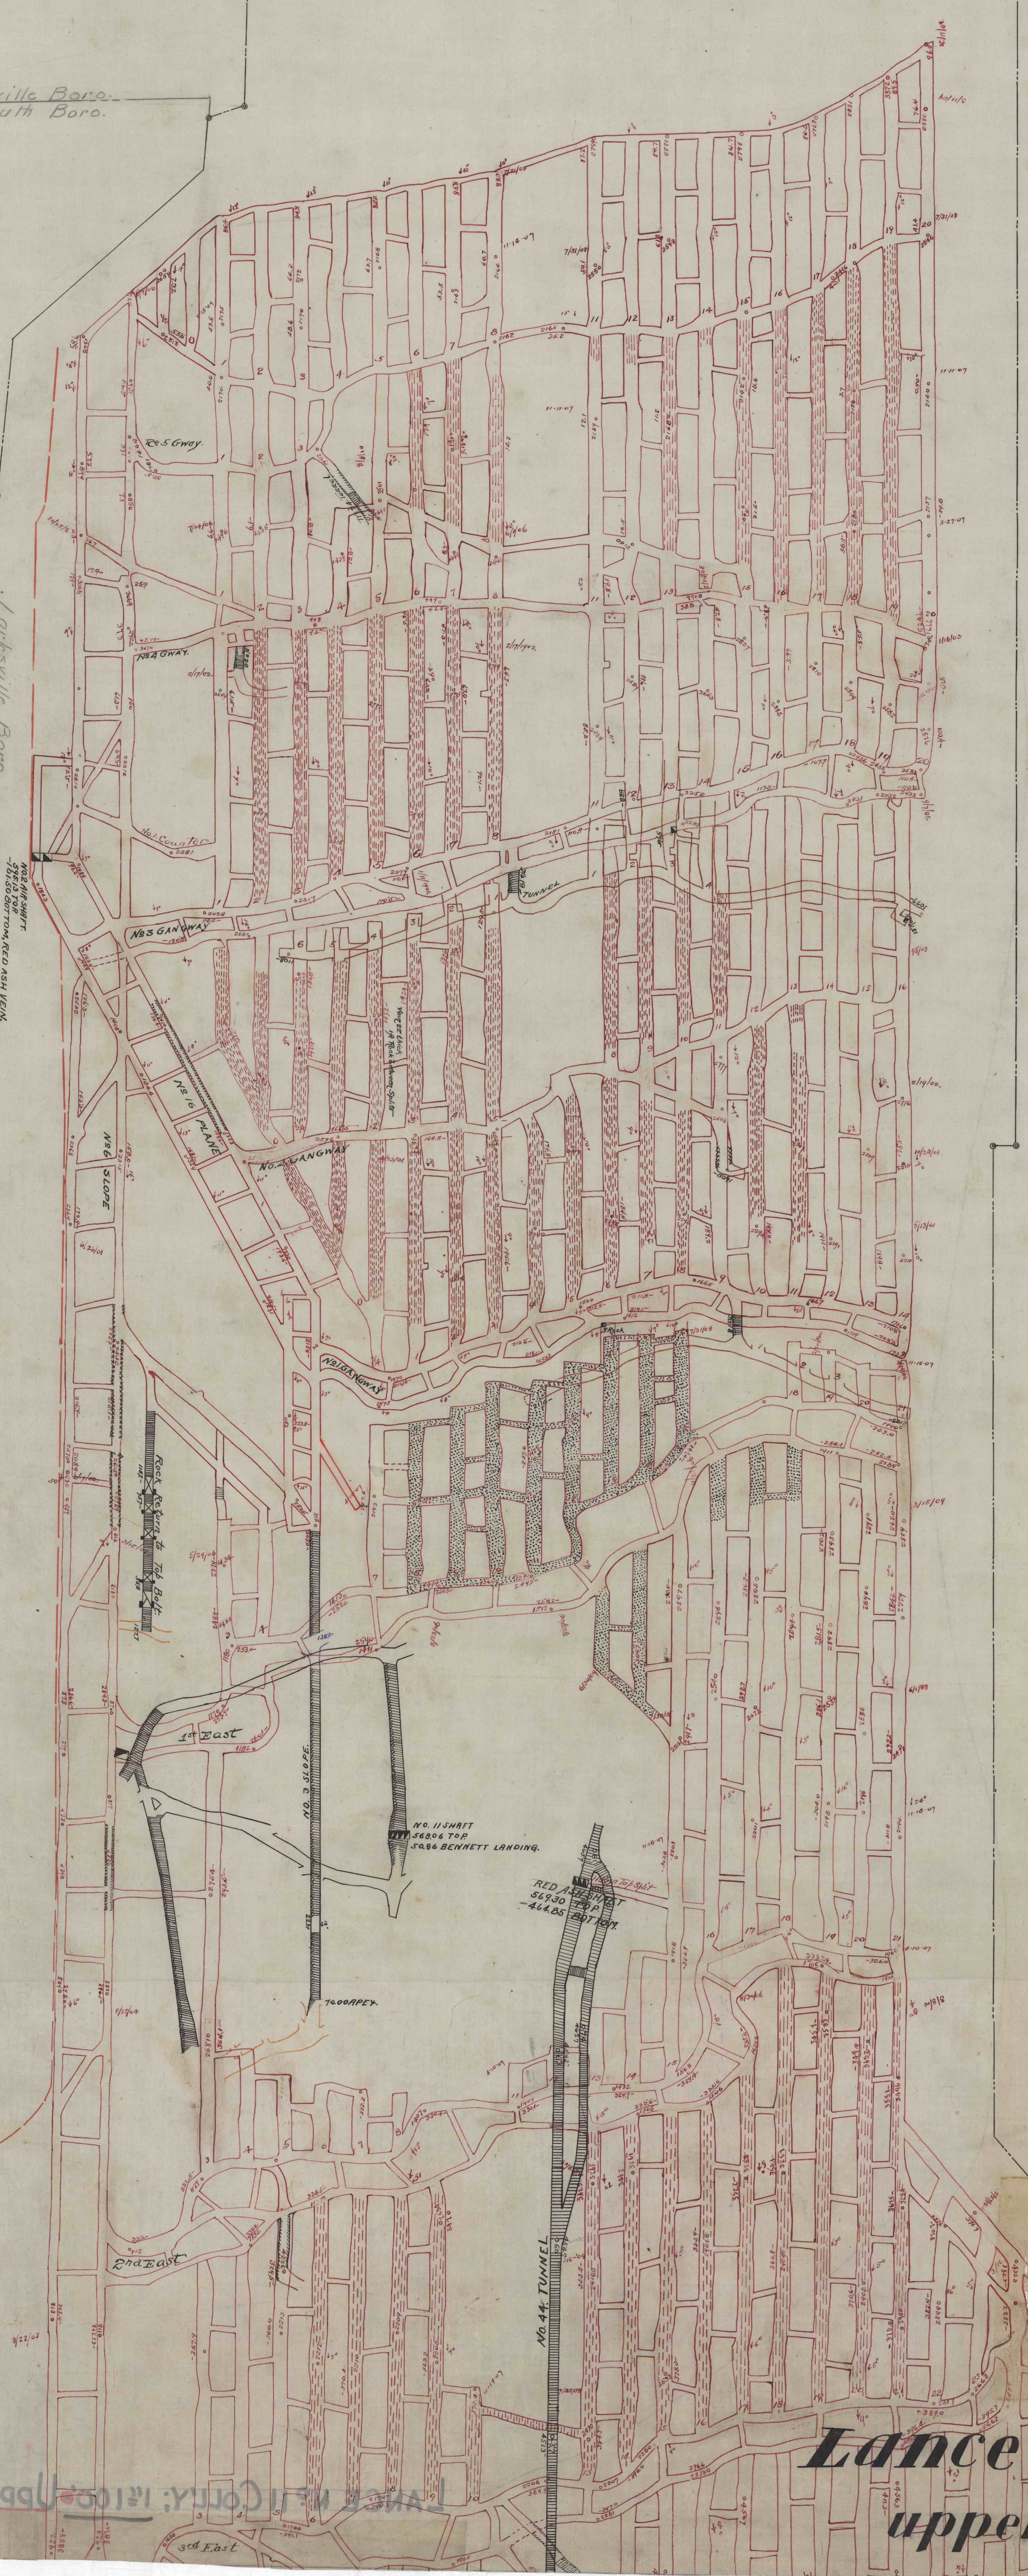

Lance Colly No. 11
upper red Ash
Scale 1/2" = 100 feet

3-11-20
Lab. 4-11-20
C. H. M. 11/18

MI B. R. A.