


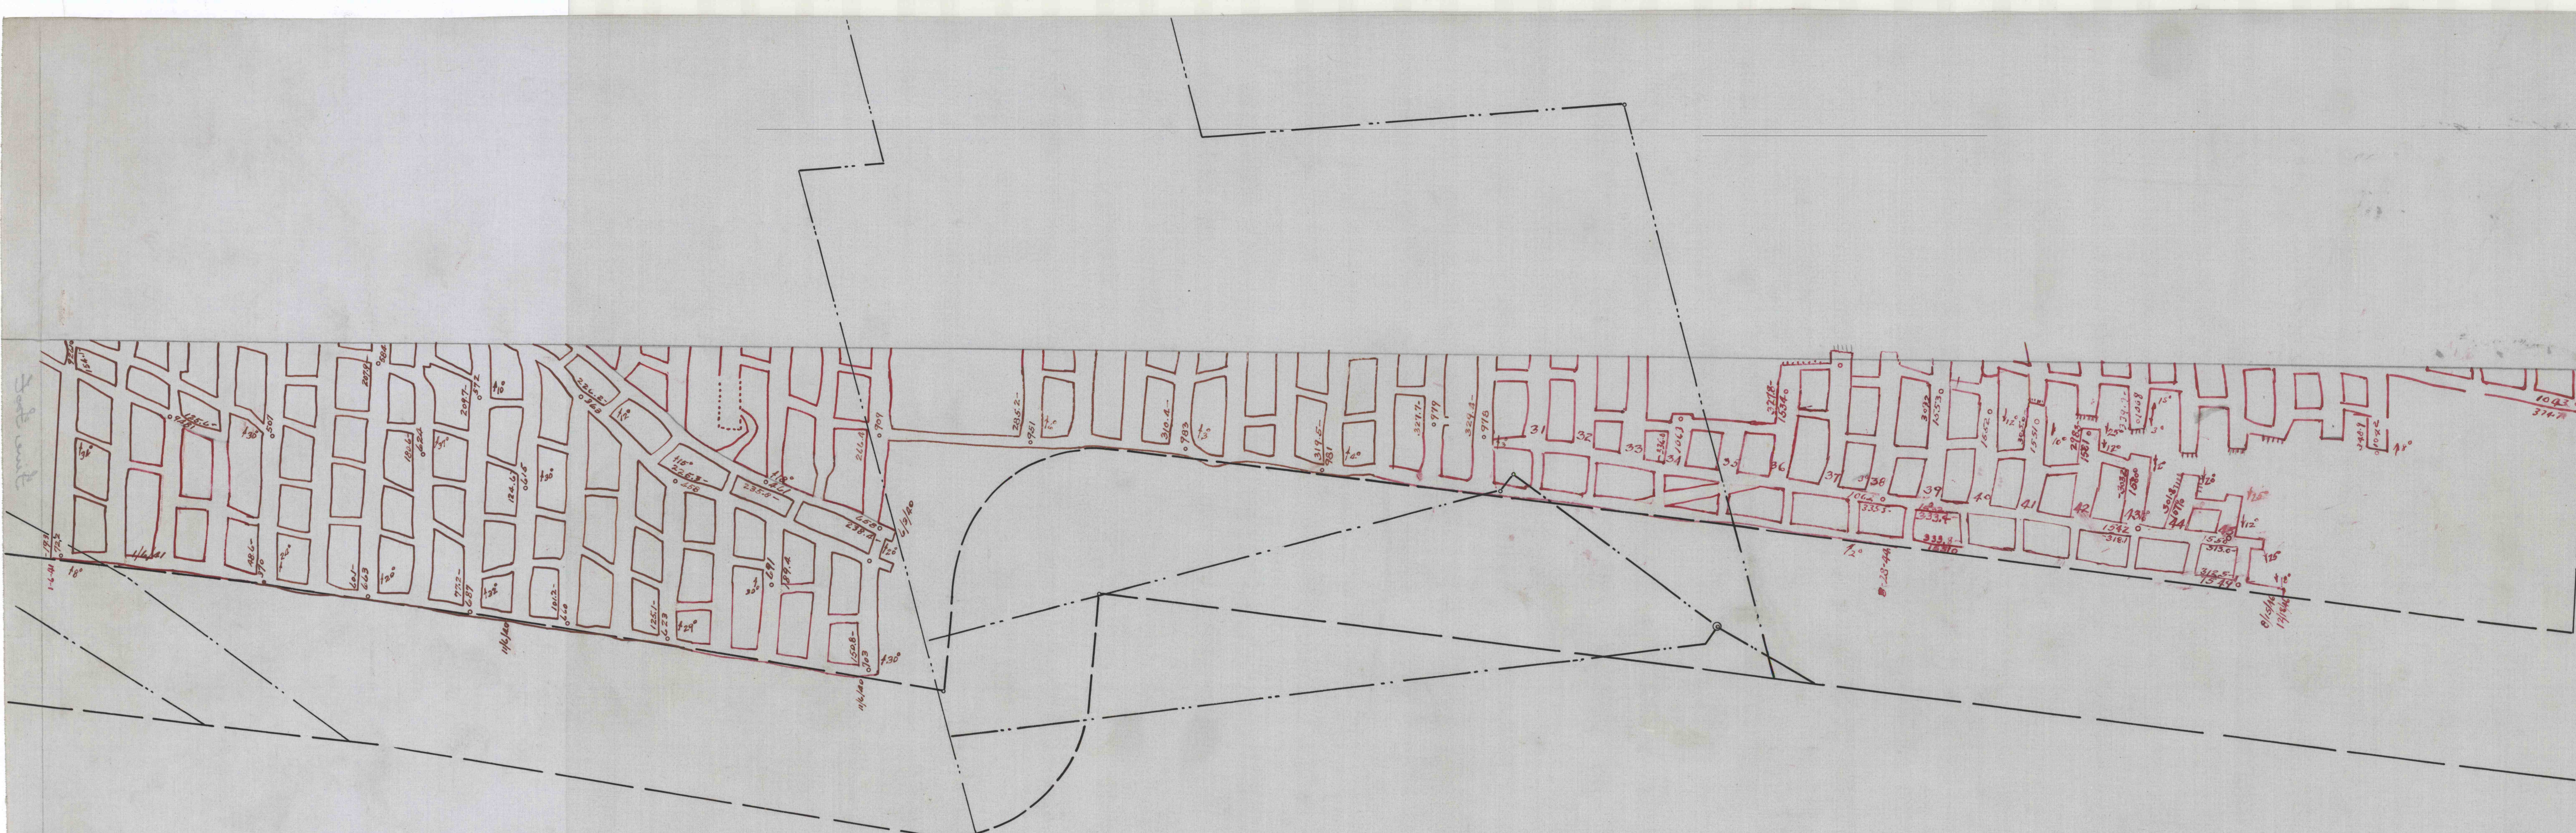

DATE OF EXTENSIONS		
JANUARY	1941	NOV 1956
DECEMBER	1941	SEPT. 20, 1957
JANUARY	1943	" 4 1958
NOVEMBER	1943	April 1959
MARCH	1945	
FEBRUARY	1946	
October	1946	
September	1947	
July	1948	
March	1949	
FEBRUARY	1950	
FEBRUARY	1951	
JANUARY	1954	

..50P5 TRAC'G..

..NORTHERN COAL FIELD..
 5-PLYMOUTH DIST., GLEN ALDEN COAL CO.,
 LANCE-11-COLLIERY FIVE FOOT VEIN 1"=100'
 LUZERNE COUNTY, PLYMOUTH BORO.,
 MINE INSPECTOR TRACING TWP.,
 PA.,

Handwritten signature or initials in the bottom right corner.