


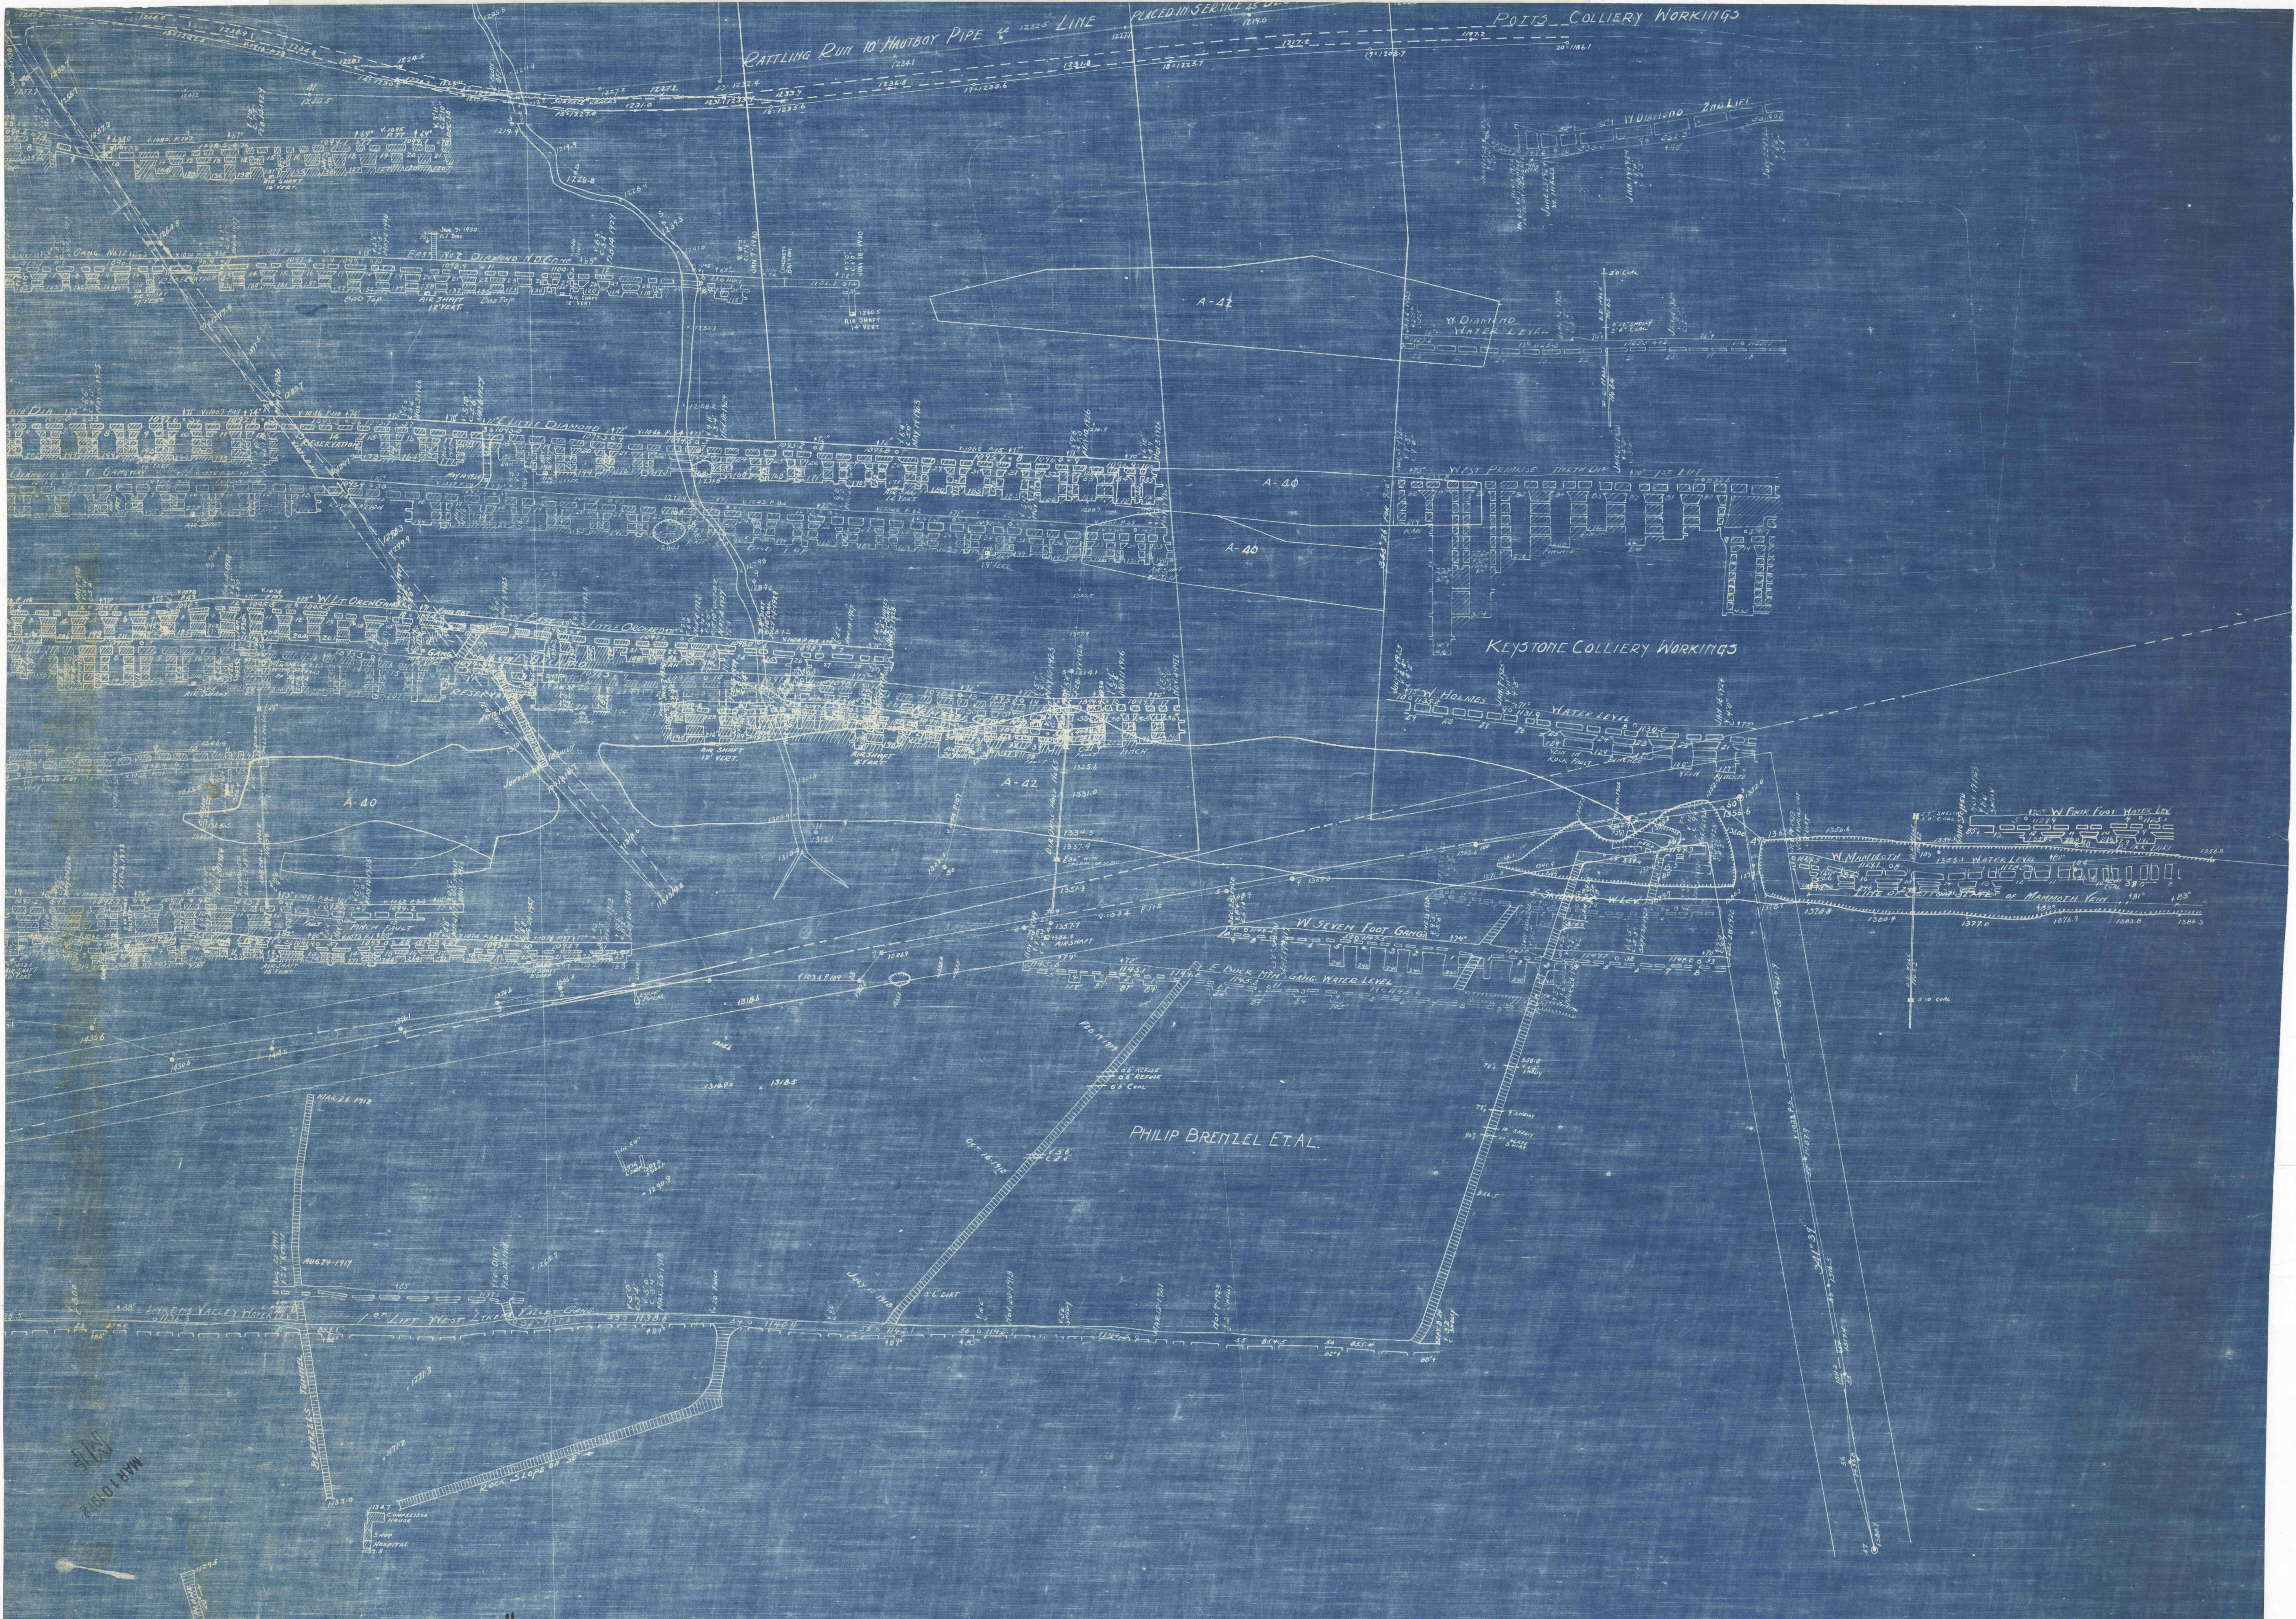

WESTERN MIDDLE FIELD.
POTTS COLLIERY & KEYSTONE COLLY. WRKGS.
• POTTS-PILLAR-LINE (NOV. 12 1963). BUTLER TWP., NORTH CONYNGHAM TWP.
NORTHUMBERLAND & SCHUYLKILL COUNTIES. W. MAHANAY DISTRICT 11