


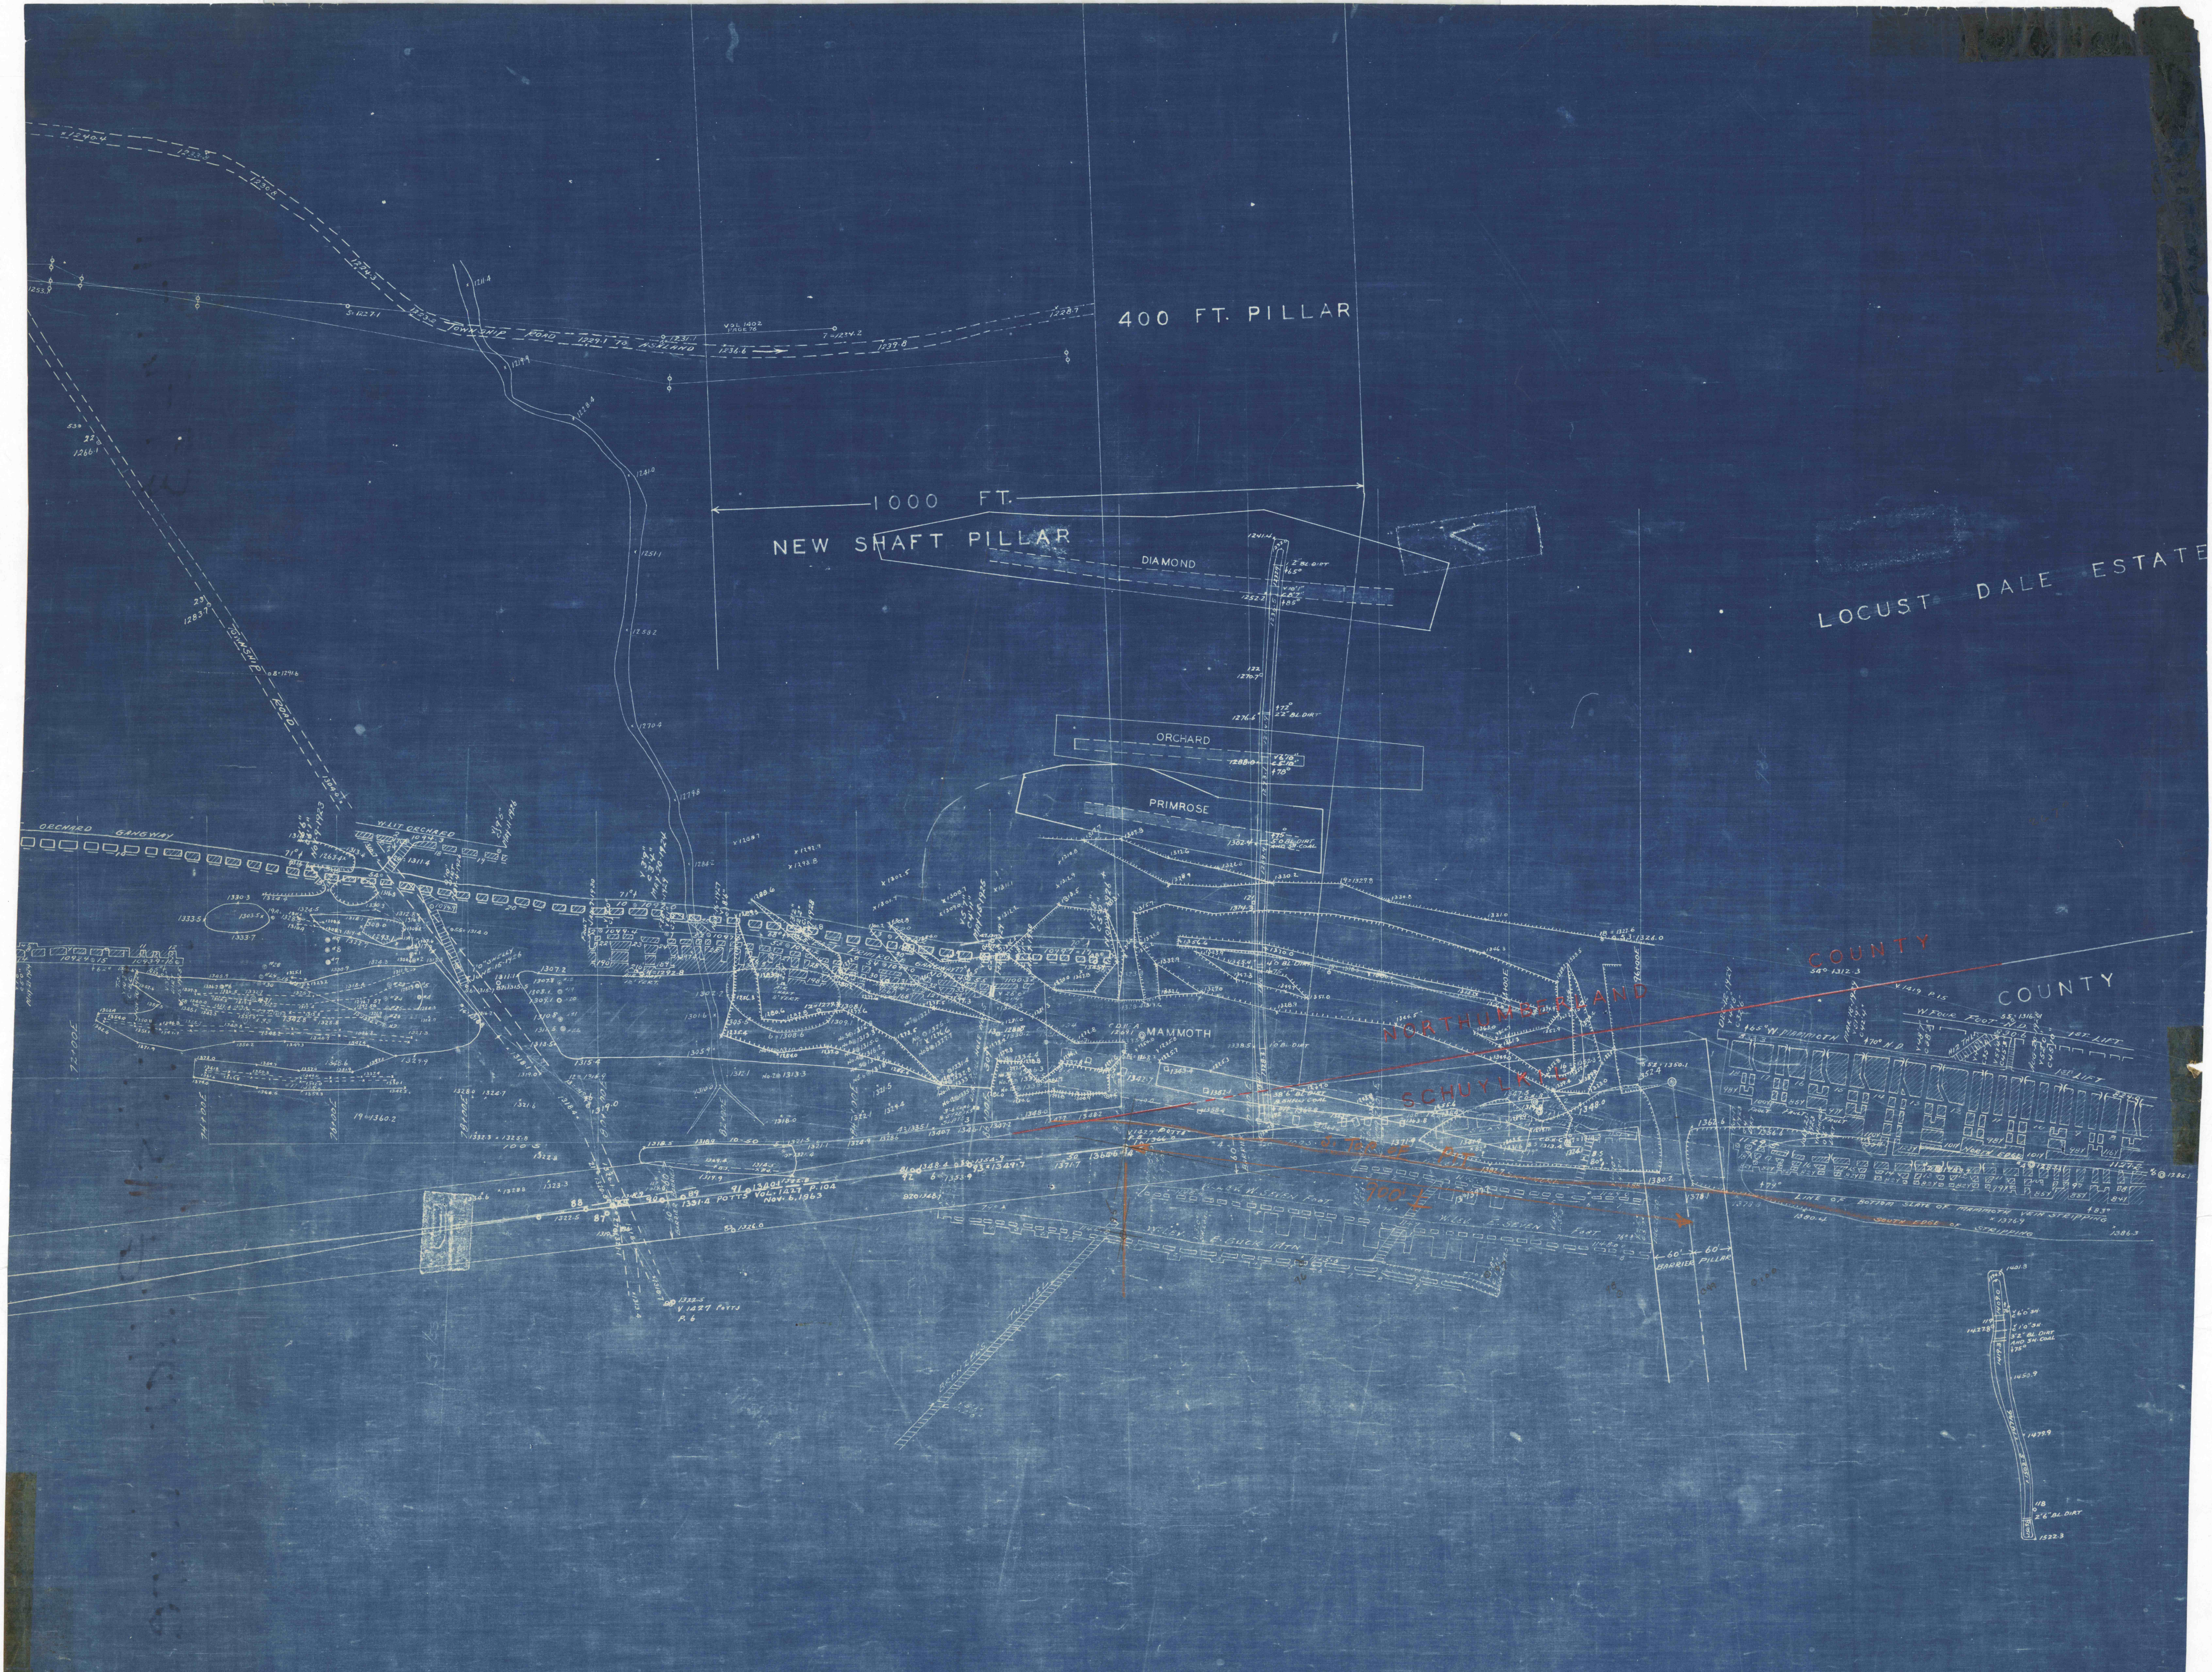

...WESTERN MIDDLE FIELD...
 Potts Colliery with KEYSTONE Colly WORKINGS 1"=100'
 NORTHUMBERLAND= SCHUYLK CNT'S. WEST MAHANODY DISTRICT. 11.
 BUTLER TWP. & NORTH CONYNGHAM TWP.
 .. POTTS WEST PILLAR LINE: NOV. 12, 1963 A.D. MF 10 MARCH 1972.