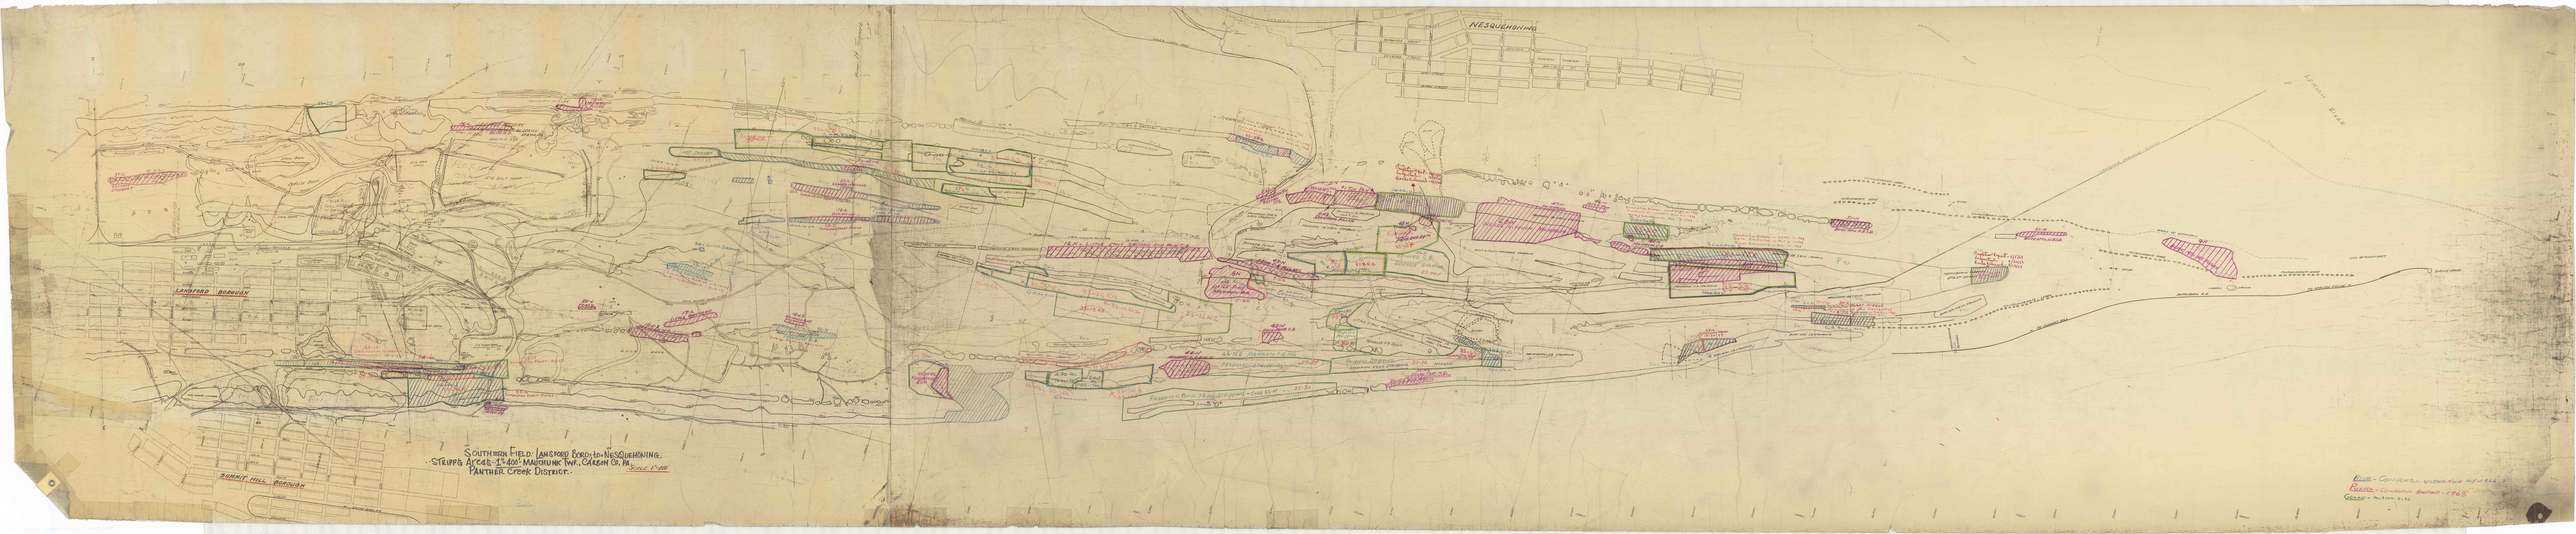

LANSFORD BOROUGH
SUMMIT HILL BOROUGH
NESQUEHONING
LEHIGH RIVER
SOUTHERN FIELD: LANSFORD BORO. to NESQUEHONING.
PANTHER CREEK DISTRICT.
SCALE 1"=400'
