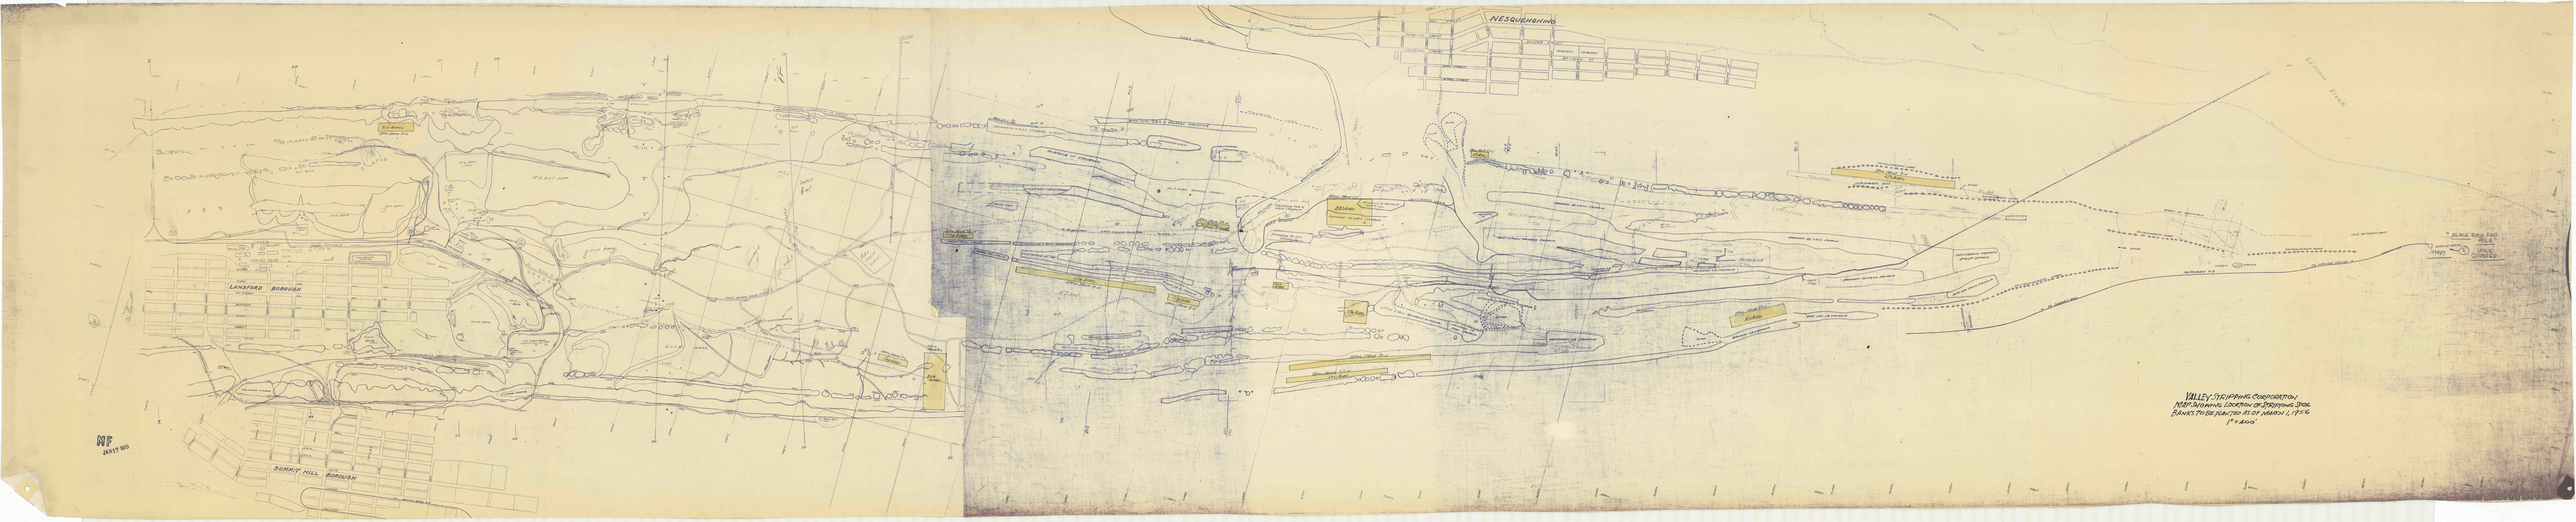
NESQUEHONING
LANSFORD BOROUGH
SUMMIT HILL BOROUGH
BLACK ROCK TAN HOLE & LANDS COVERED
VALLEY STRIPPING CORPORATION
MAP SHOWING LOCATION OF STRIPPING PROP.
BANKS TO BE PLANTED AS OF MARCH 1, 1956
1" = 400'