


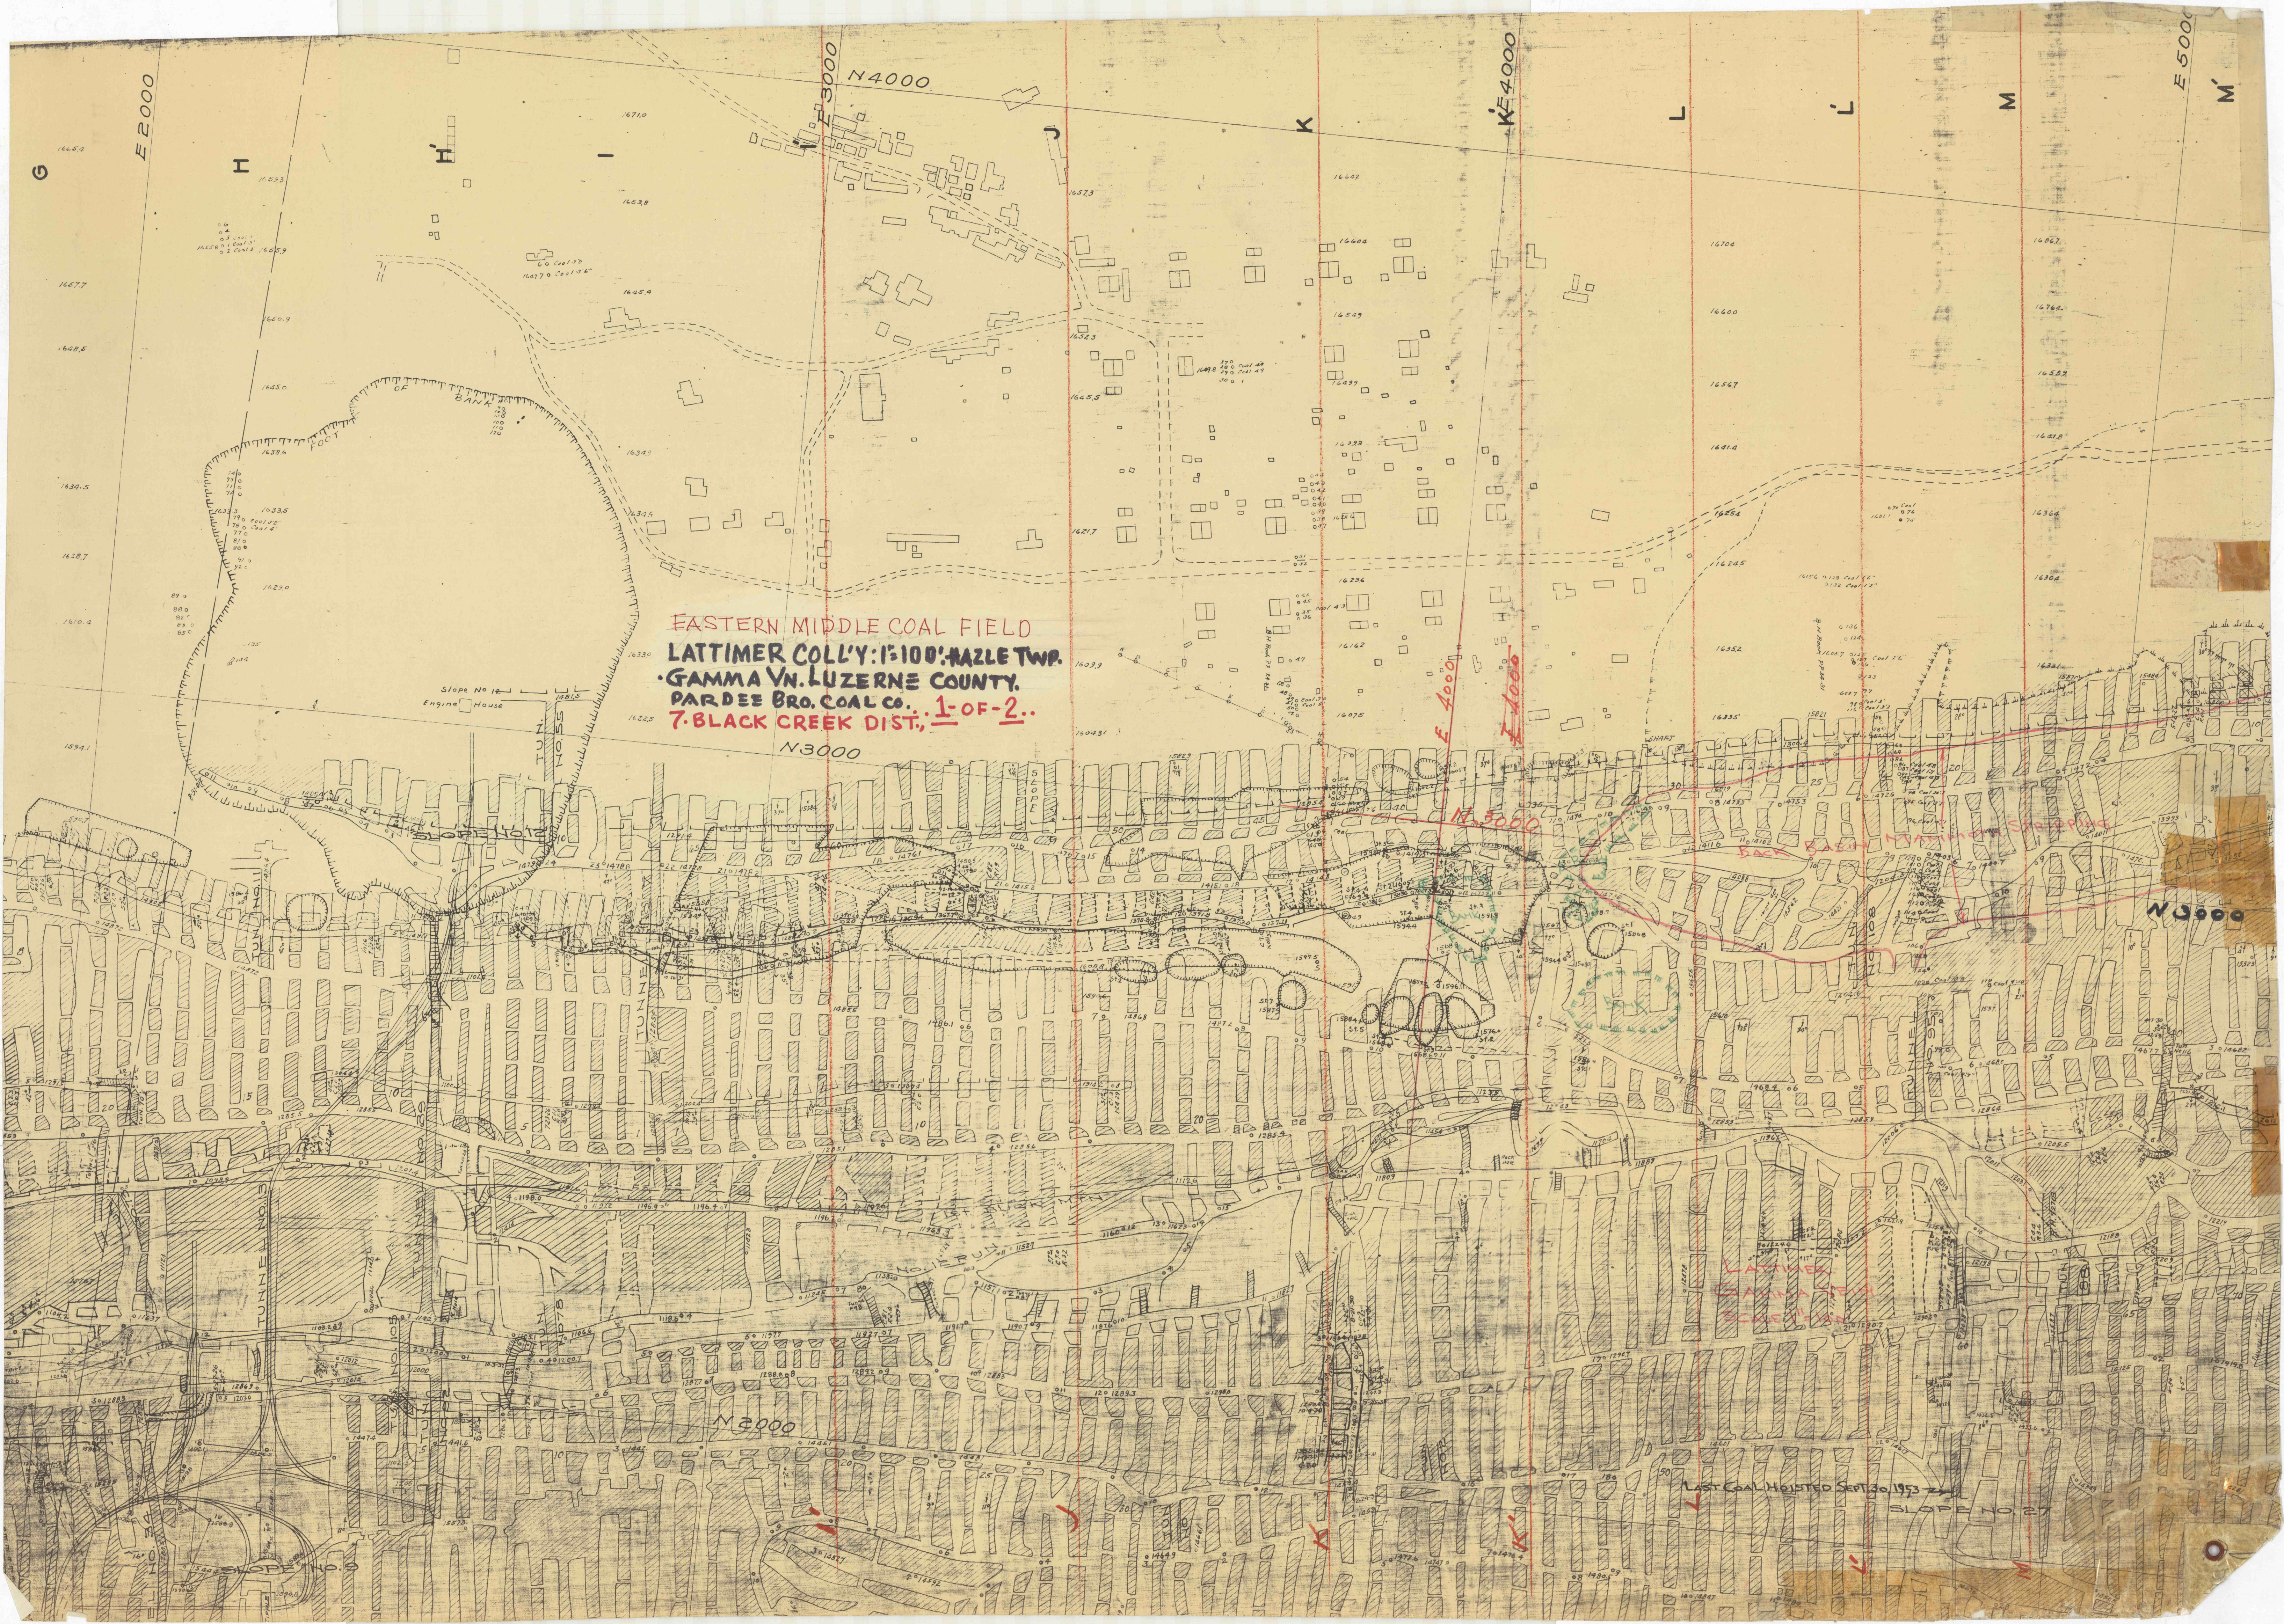

EASTERN MIDDLE COAL FIELD
LATTIMER COLL'Y: 15100' HAZLE TWP.
GAMMA VN. LUZERNE COUNTY.
PARDEE BRO. COAL CO. 1-OF-2..
7-BLACK CREEK DIST; 1-OF-2..

LAST COAL HOISTED SEPT 30, 1953
SLOPE NO. 27