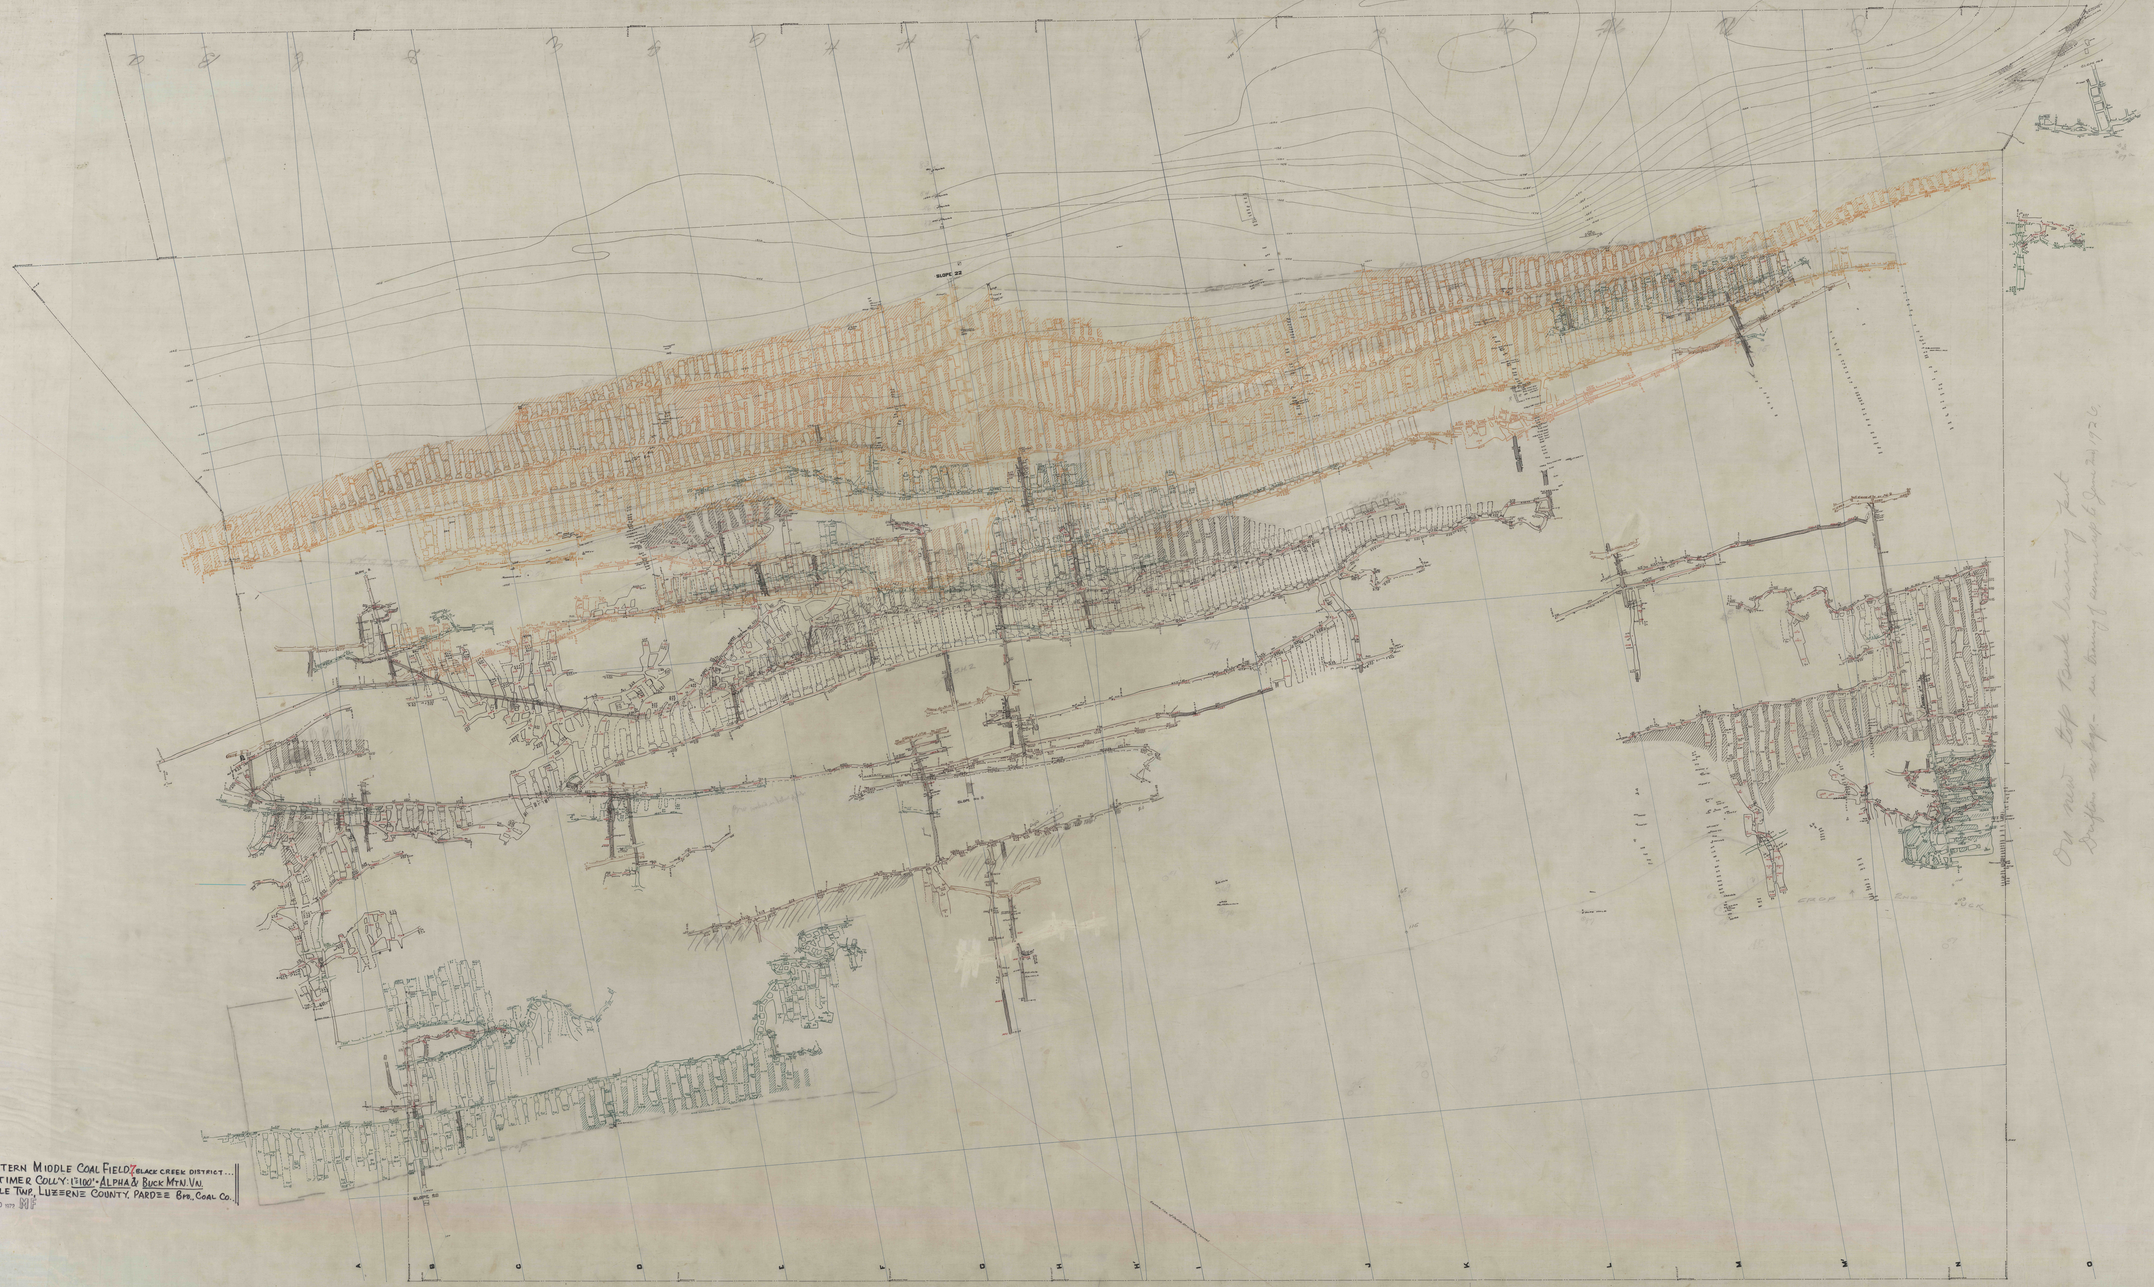


EASTERN MIDDLE COAL FIELD (BLACK CREEK DISTRICT)...
LATTIMER COLLY: 1"=100' - ALPHA & BUCK MTN. VN.
HAZLE TWP., LUZERNE COUNTY. PARDEE BRS. COAL CO.
MAR 10 1972 MF

On mine Top Rock bearing East
Scale as shop- as being surveyed June 24 1926

THE PENNSYLVANIA STATE UNIVERSITY LIBRARIES
PENNSYLVANIA MINE MAPS COLLECTION
THIS MAP IS THE PROPERTY OF THE PENNSYLVANIA STATE UNIVERSITY LIBRARIES