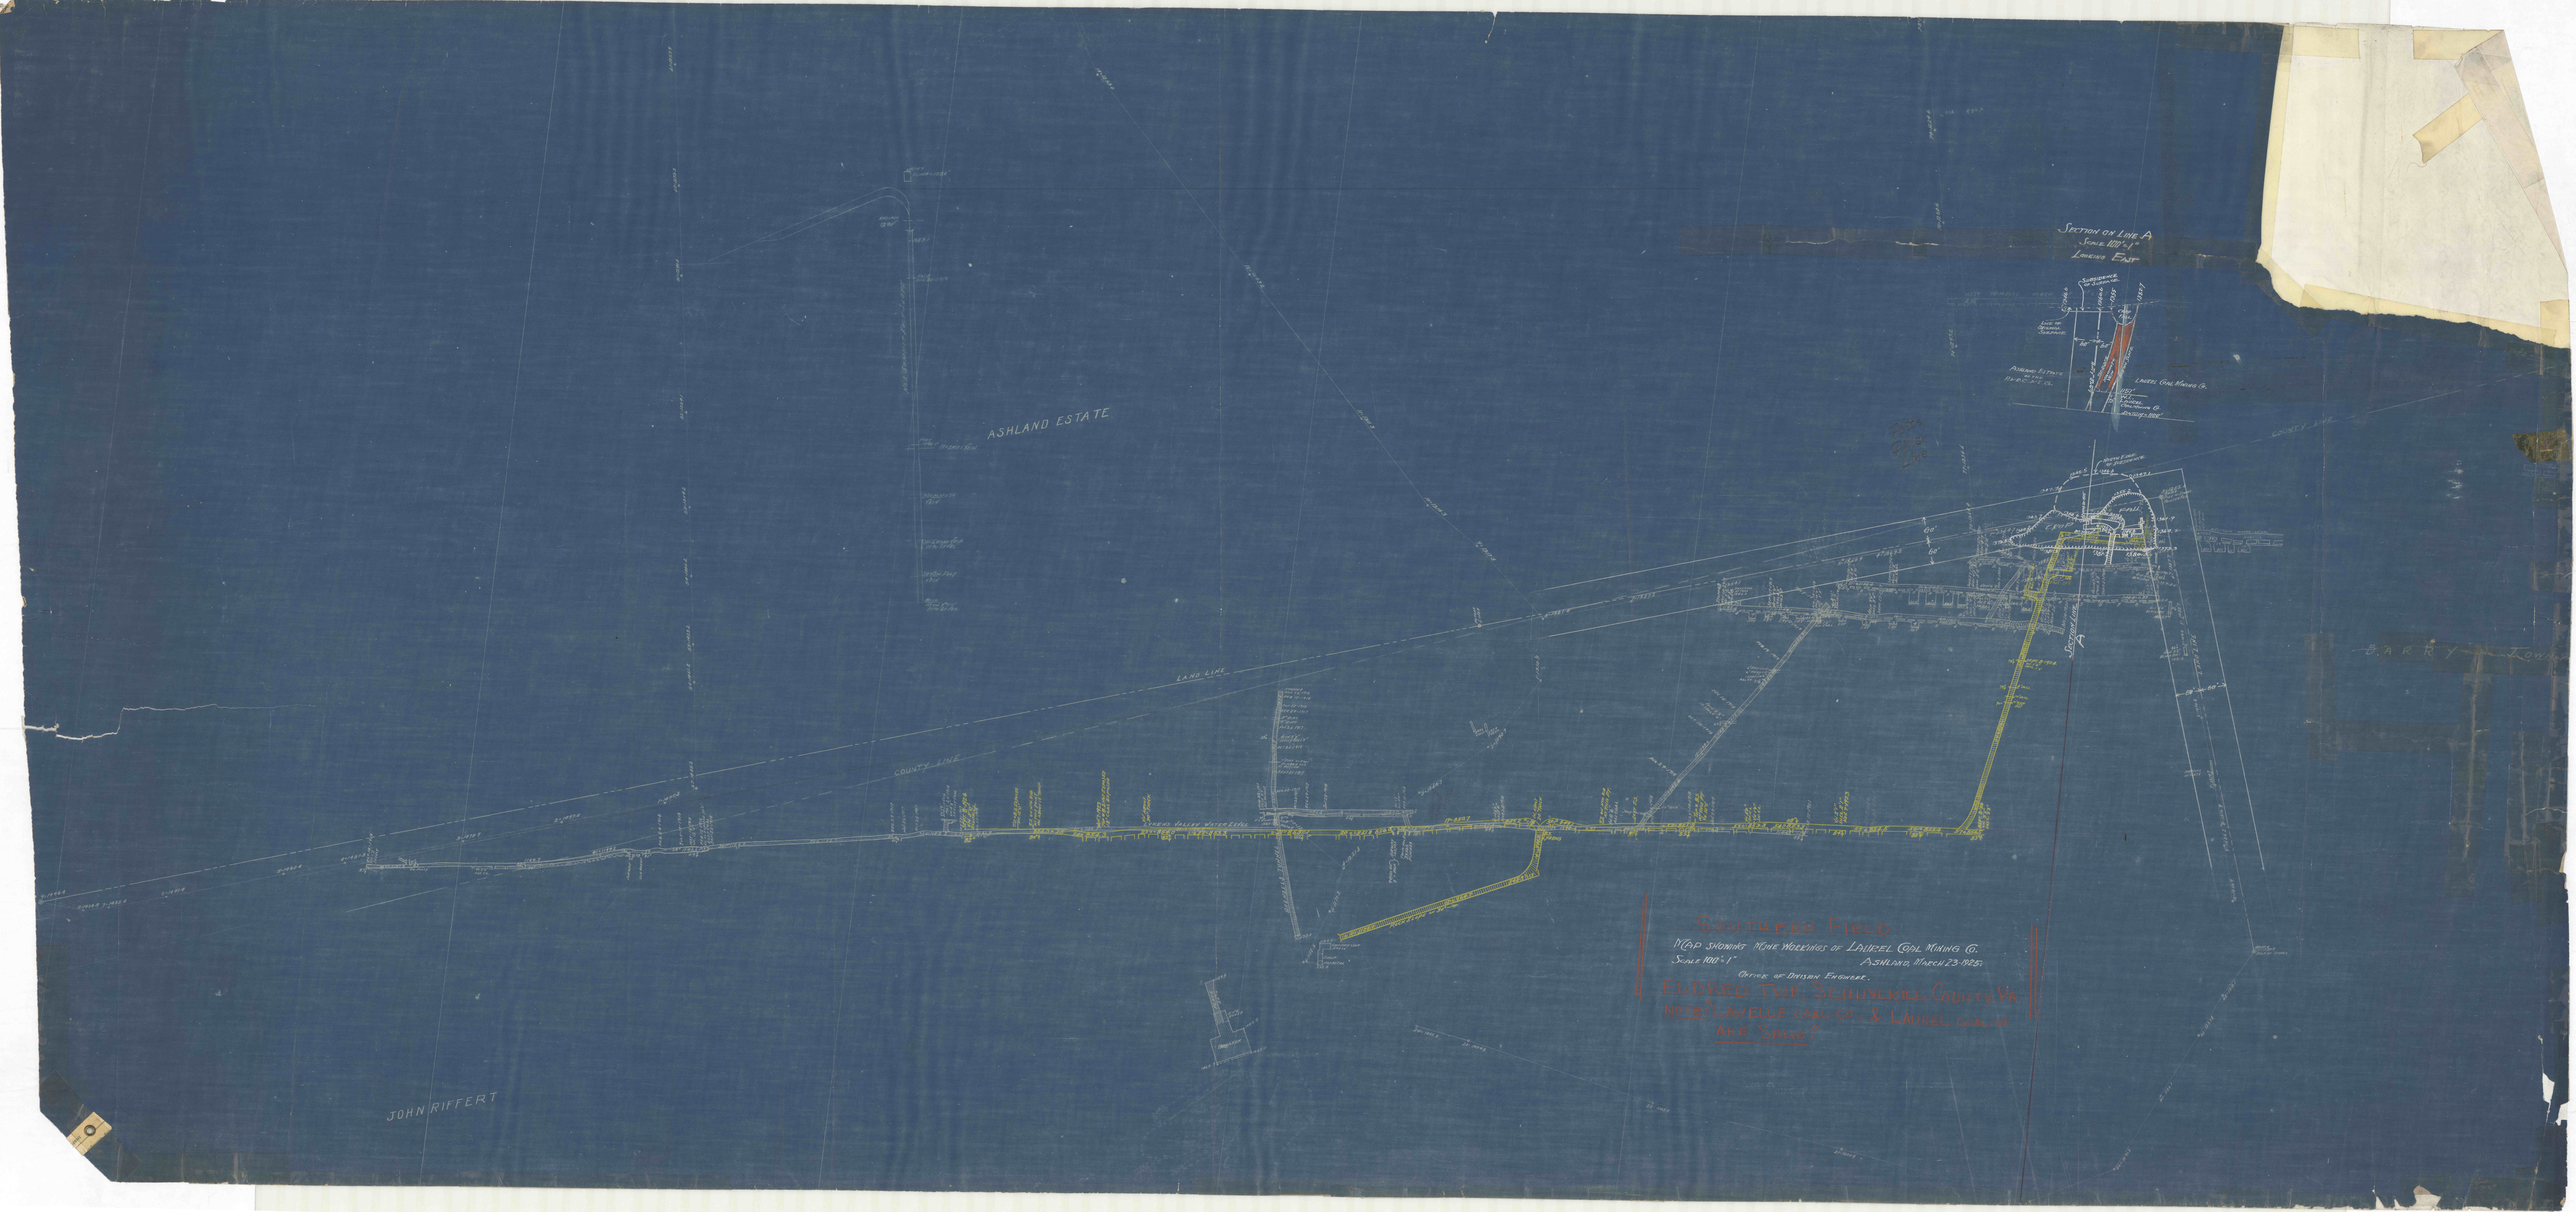
SECTION ON LINE A
SCALE 100'=1"
LOOKING EAST
ASHLAND ESTATE
LAND LINE
COUNTY LINE
JOHN RIFFERT
SOUTHERN FIELD
MAP SHOWING MINE WORKINGS OF LAUREL COAL MINING CO.
SCALE 100'=1"
ASHLAND, MARCH 23 1925
OFFICE OF DIVISION ENGINEER.
