


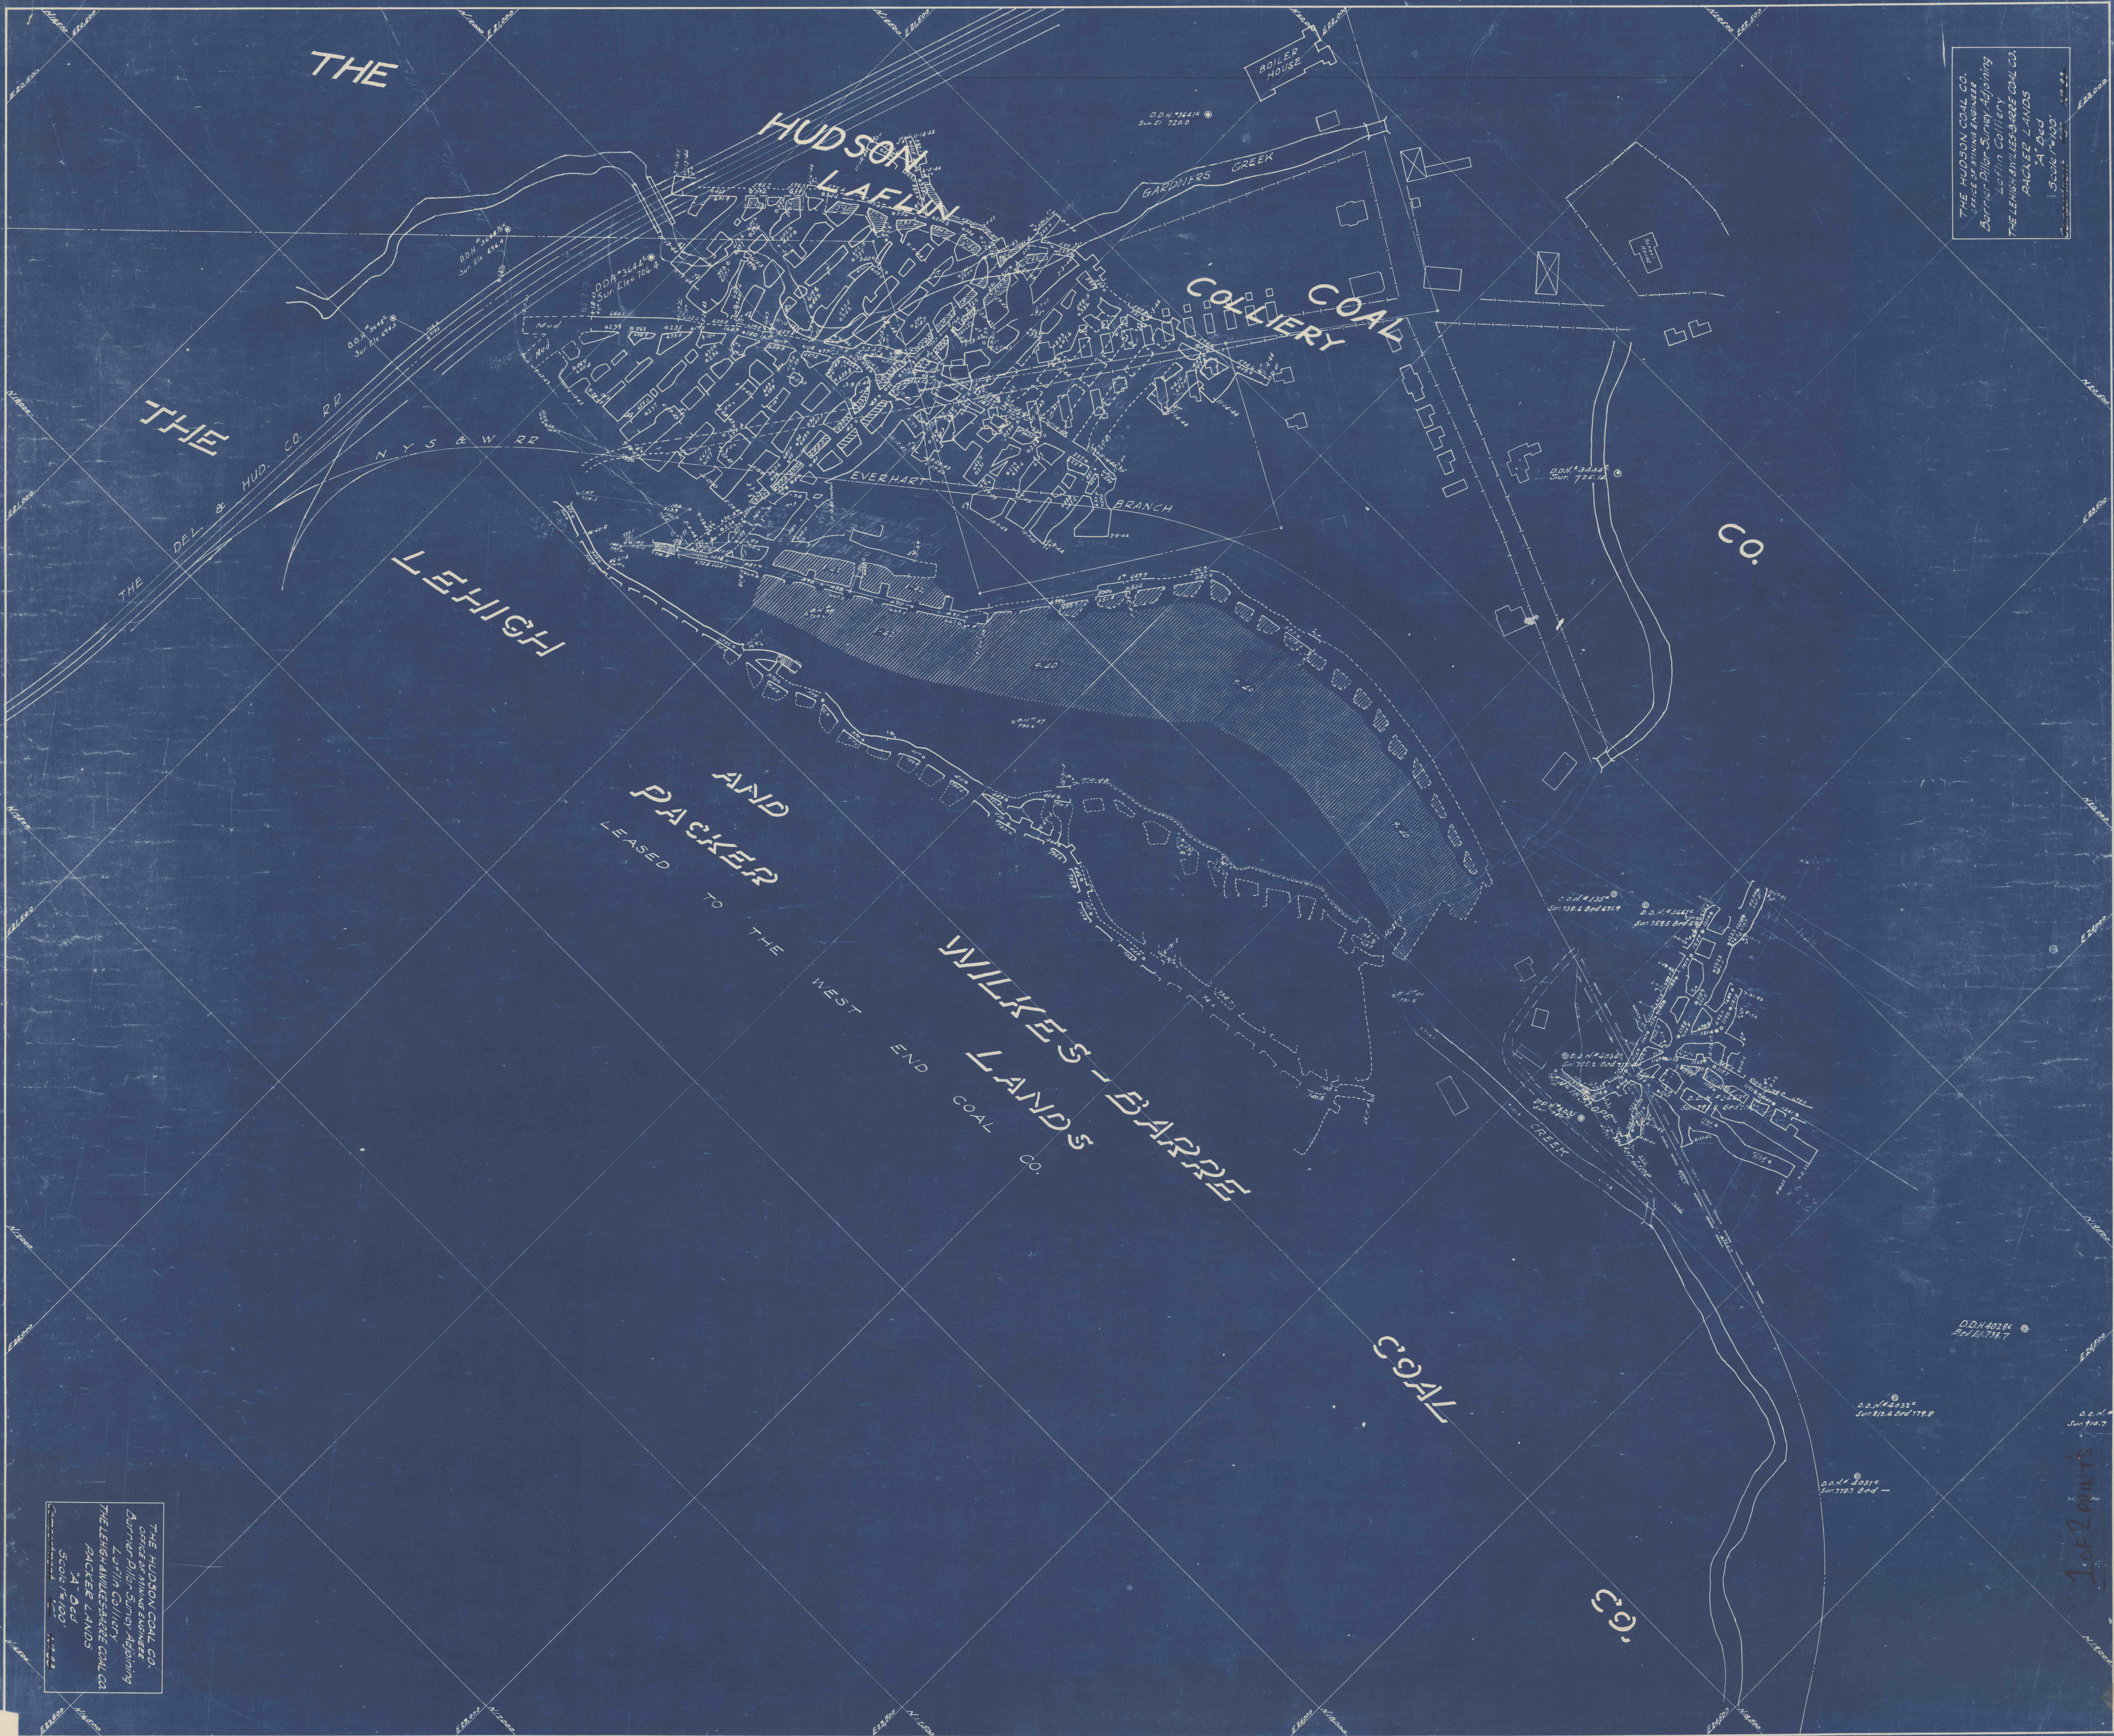

THE HUDSON COAL CO.
OFFICE OF MINING ENGINEER
Barner Dillon Survey Adjutant
Lehigh Valley Coal Co.
THE LEHIGH-BYVILLER-BAKRE COAL CO.
PACKER LANDS
Scale 1" = 100'
1" = 100'


1 of 2 sheets