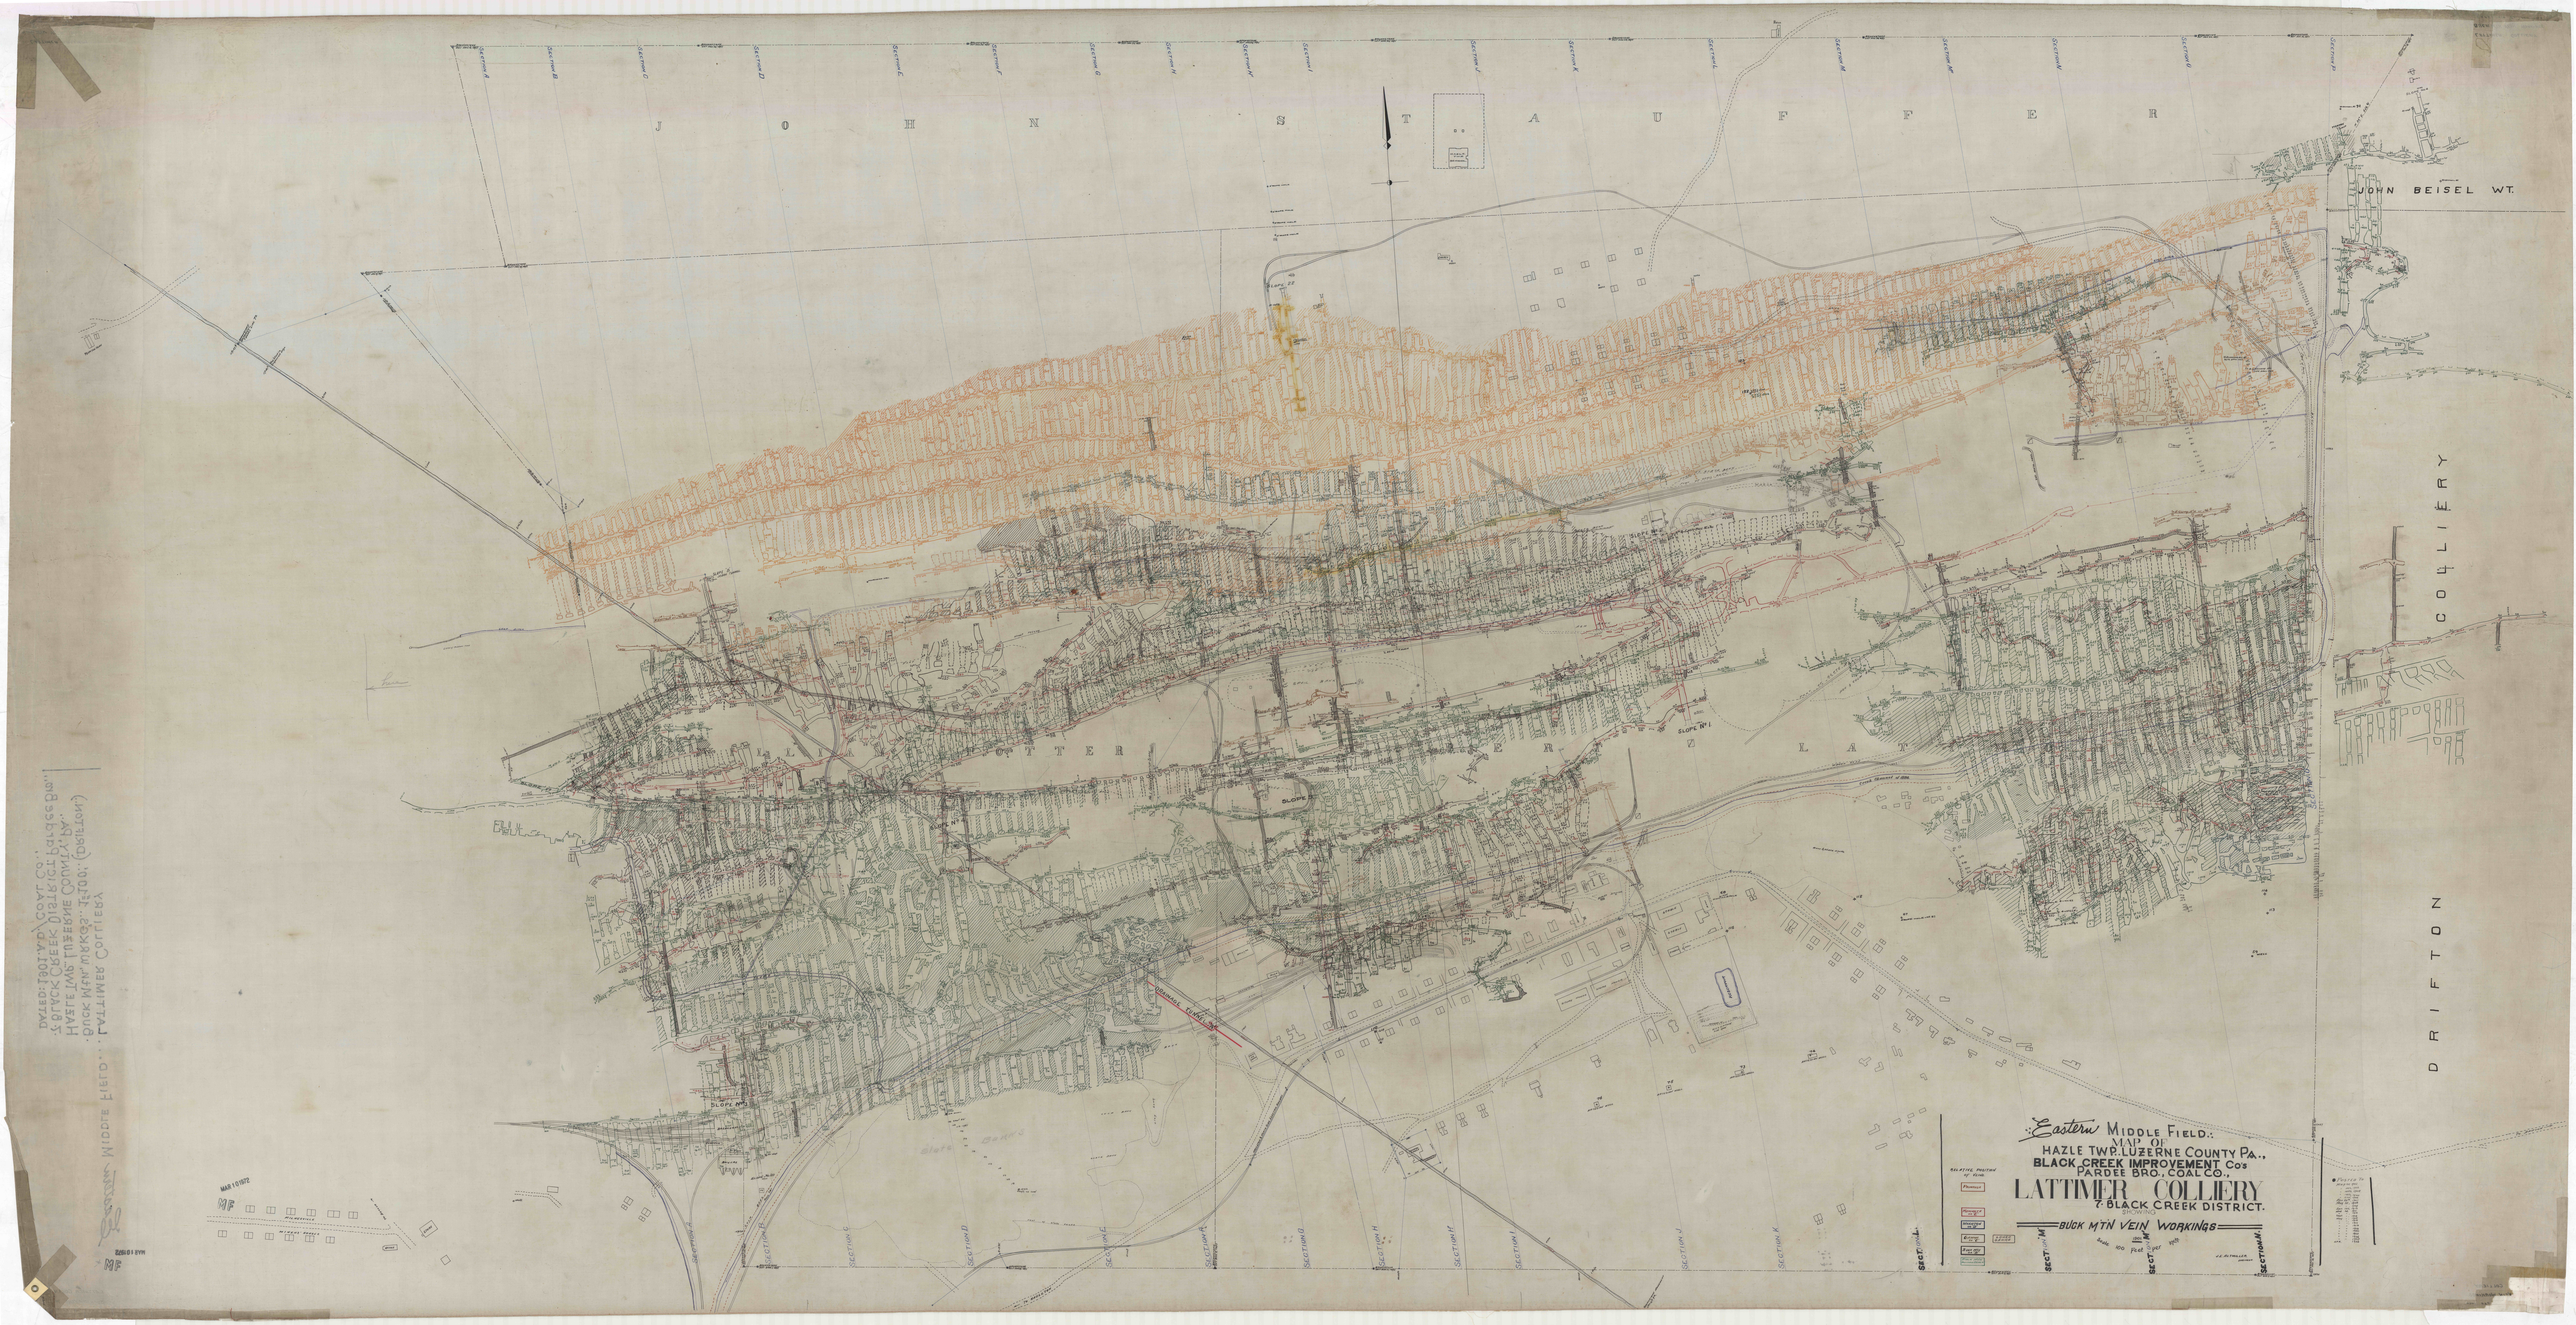

JOHN STAUFFER
JOHN BEISEL WT.
DRIFTON COLLIERY
Eastern Middle Field.
MAP OF
HAZLE TWP. LUZERNE COUNTY PA.,
BLACK CREEK IMPROVEMENT Co's
PARDEE BRO. COAL CO.,
LATTIMER COLLIERY
& BLACK CREEK DISTRICT.
BUCK MTN VEIN WORKINGS
Eastern Middle Field...Lattimer Colliery
Pardee Bros. Coal Co.
Black Creek District
Hazle Twp. Luzerne County
Buck Mtn. Vein Workings. (Partial)