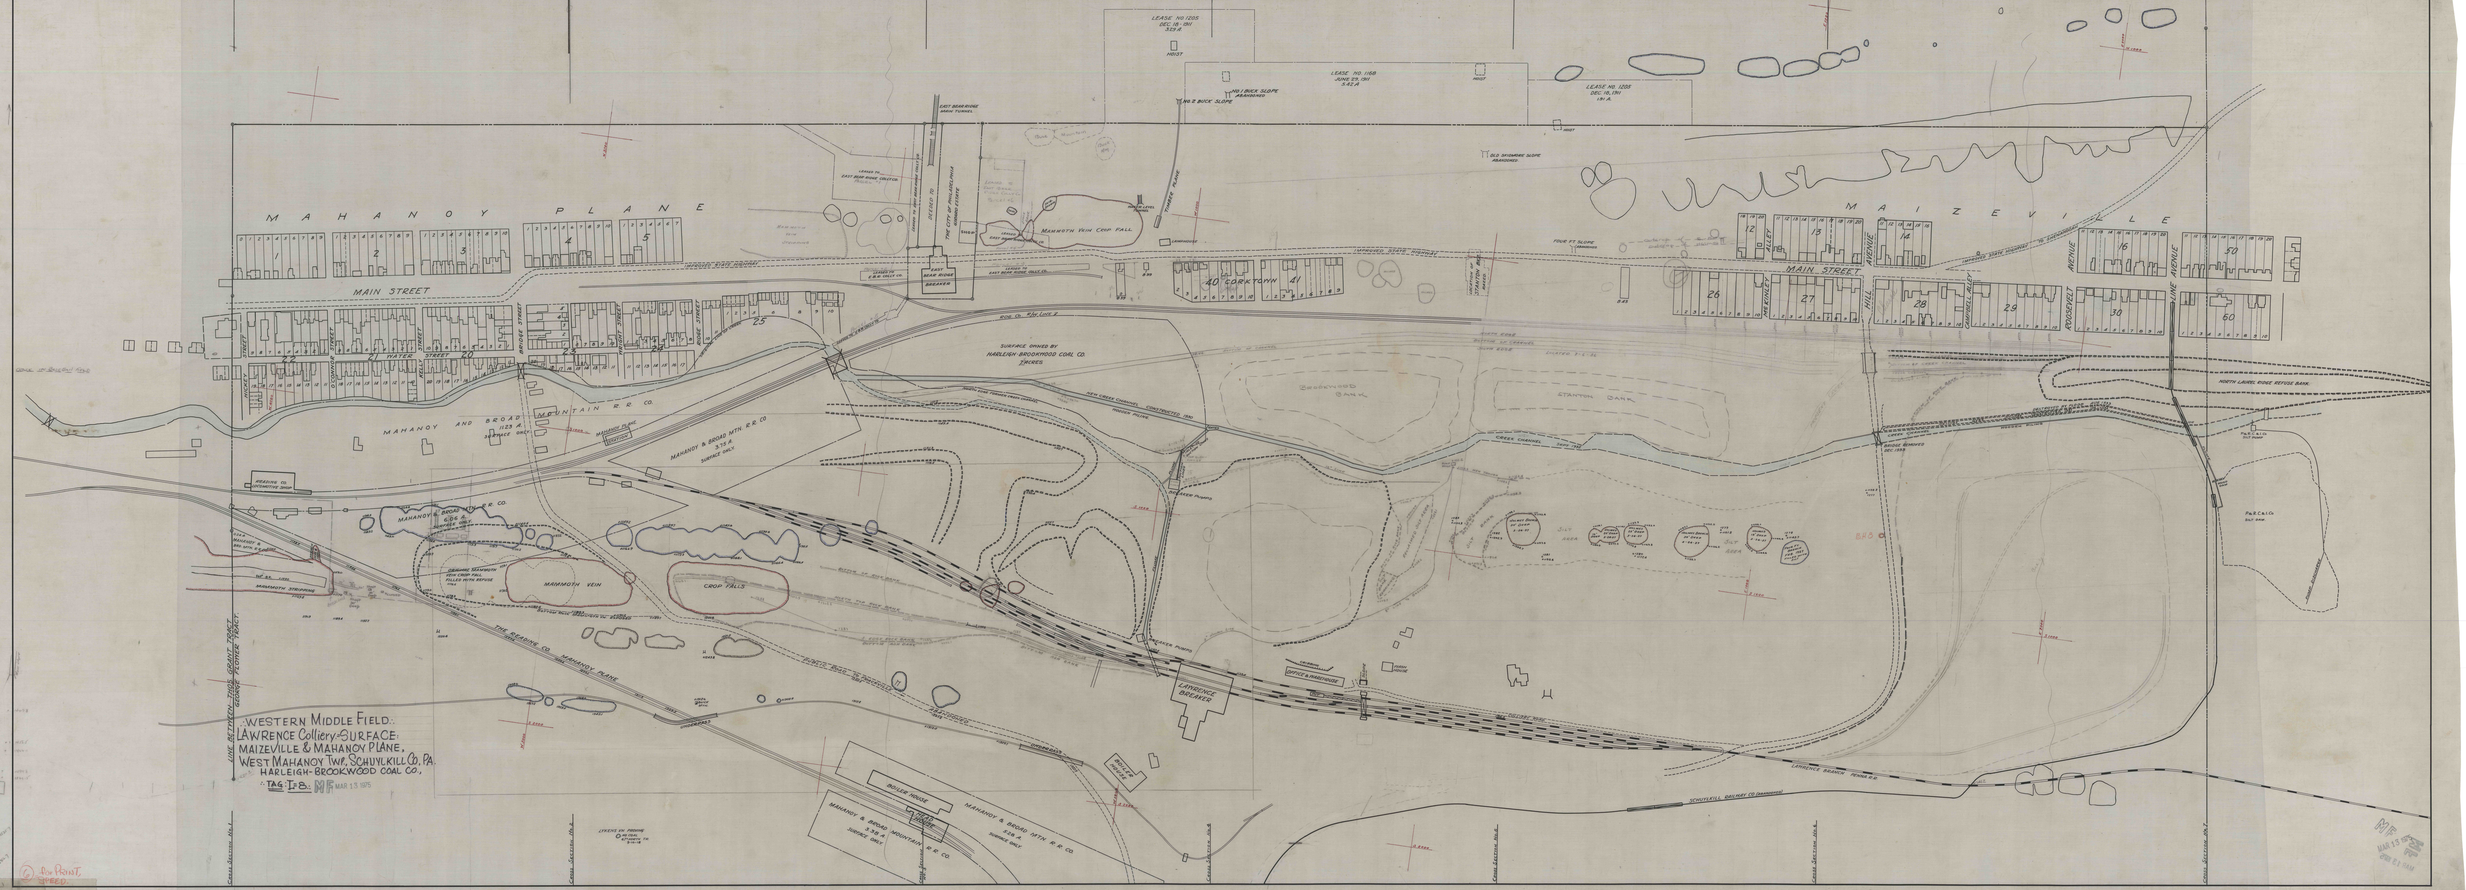

MAHANOY PLANE
MAIZEVILLE
MAIN STREET
MAHANOY AND BROAD MOUNTAIN R.R. CO.
MAHANOY & BROAD MTN. R.R. CO.
MAMMOTH VEIN
CROP FALLS
CORKTOWN
STANTON BANK
BROOKWOOD BANK
LAWRENCE BREAKER
BOILER HOUSE
THE READING CO. MAHANOY PLANE
SURFACE OWNED BY HARLEIGH-BROOKWOOD COAL CO. 7 ACRES
WESTERN MIDDLE FIELD.
LAWRENCE Colliery-SURFACE.
MAIZEVILLE & MAHANOY PLANE,
WEST MAHANOY TWP. SCHUYLKILL CO. PA.
HARLEIGH-BROOKWOOD COAL CO.,
TAG: T-8.
MAR 13 1875