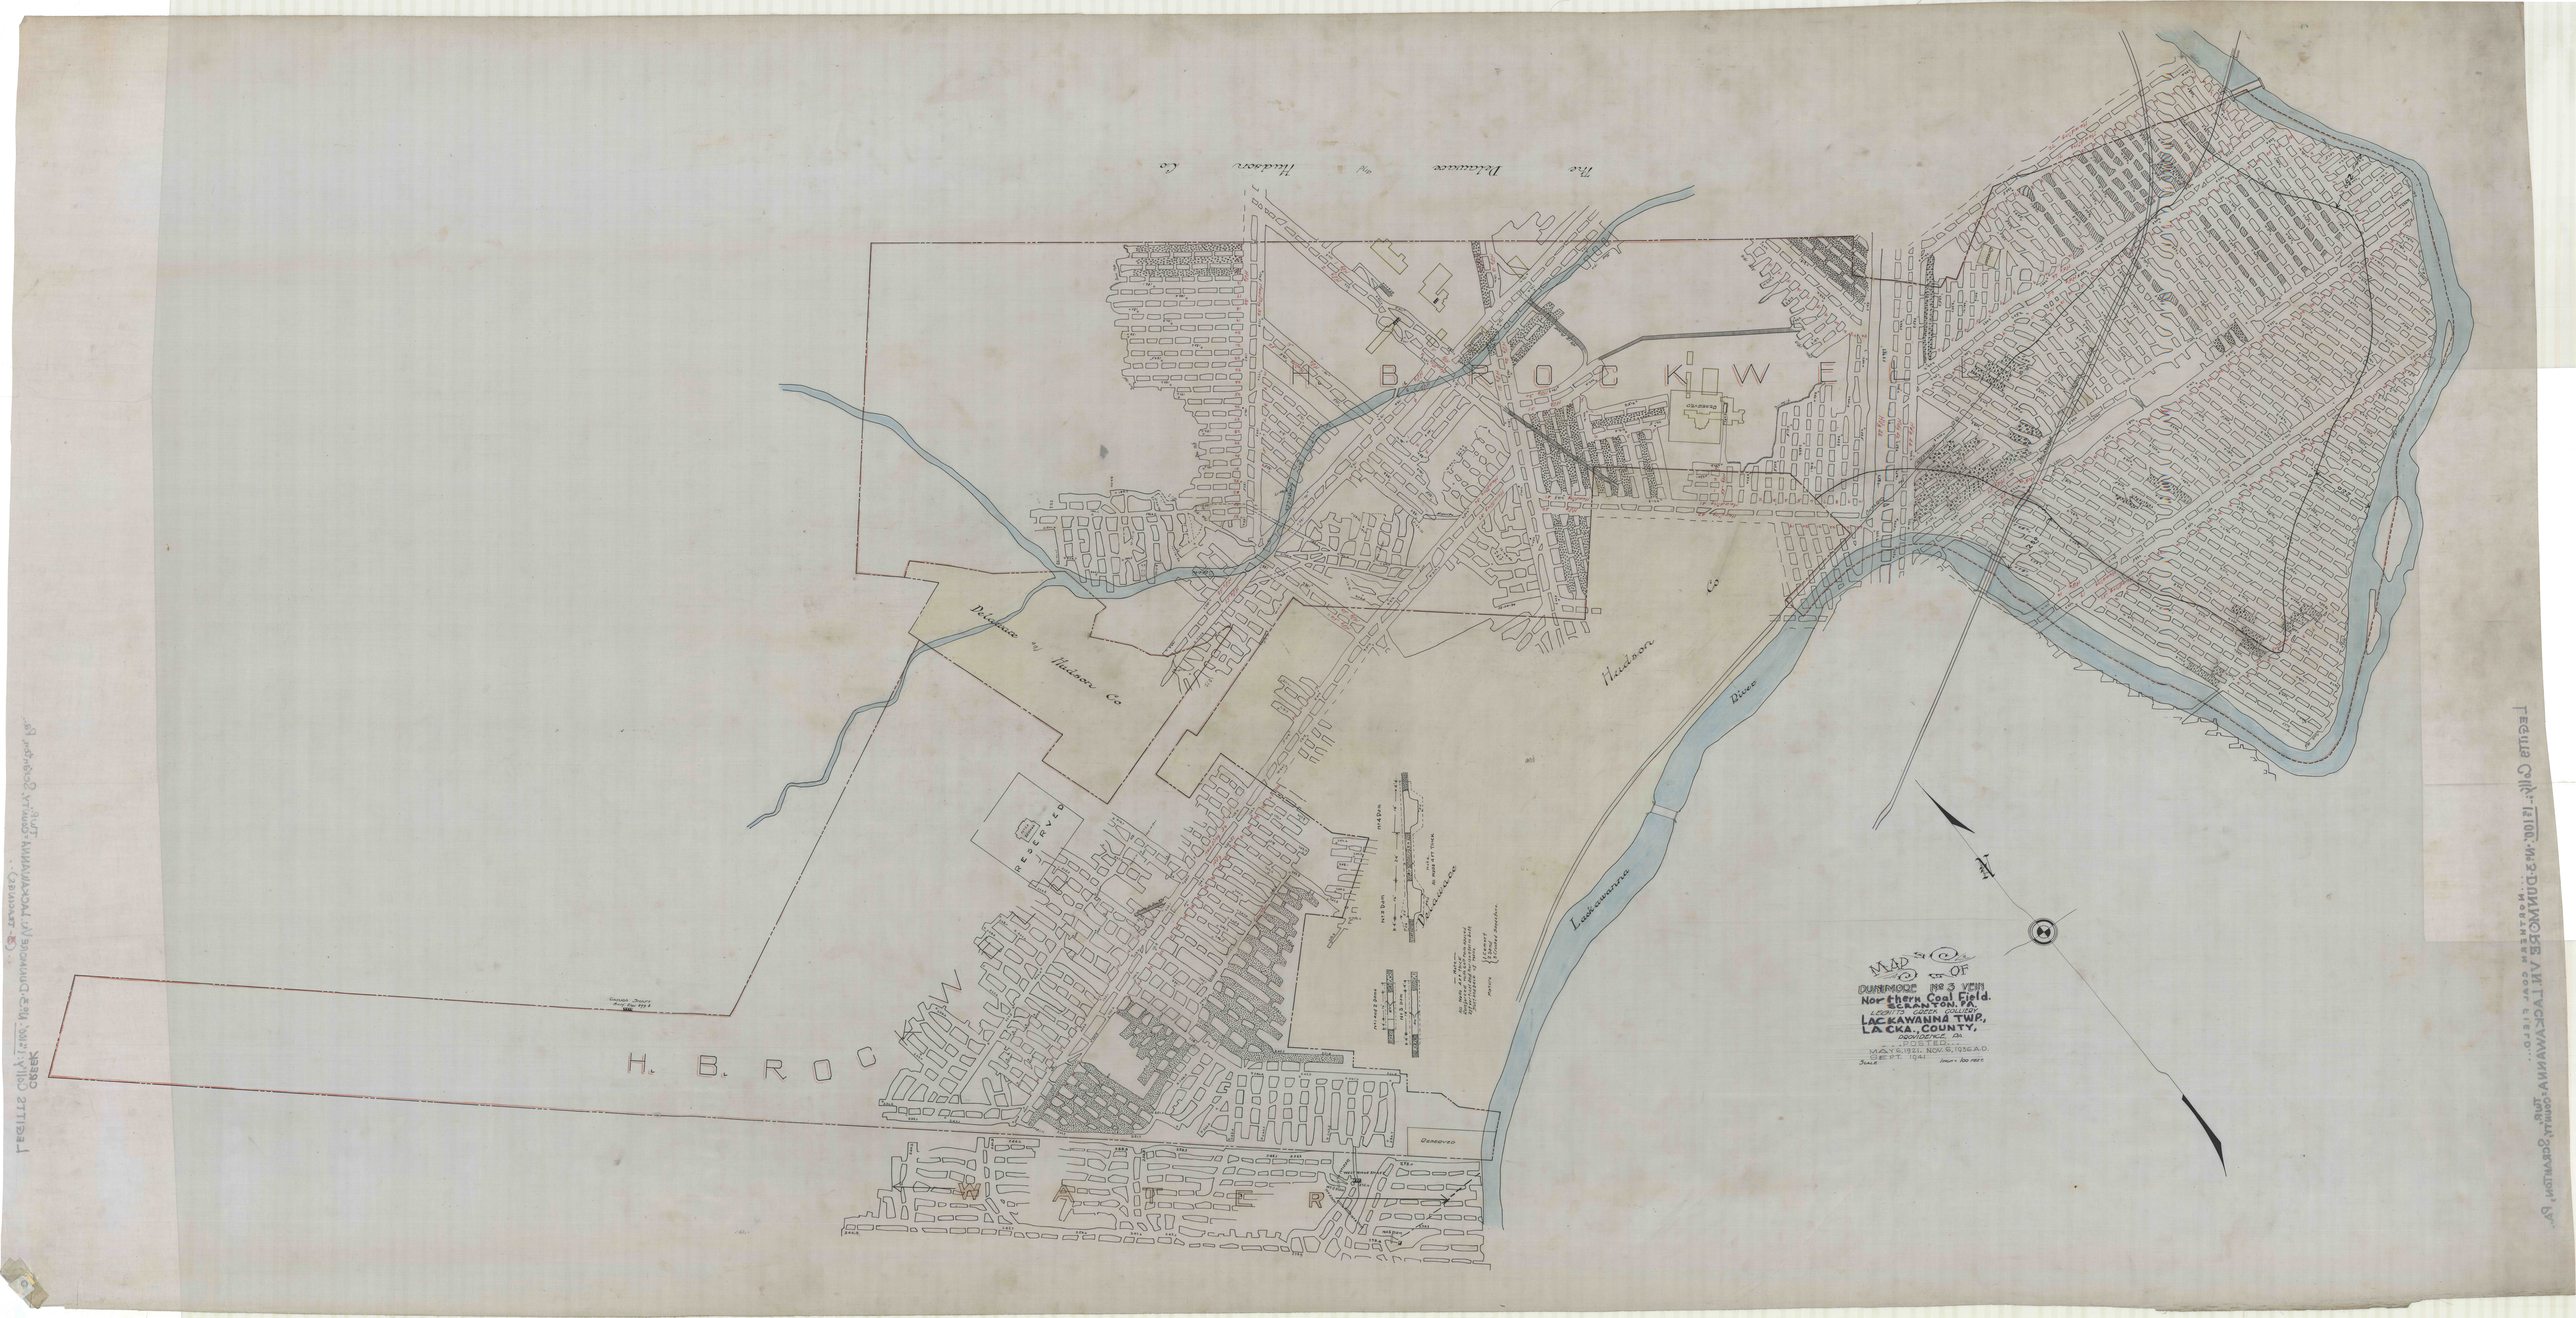

H. B. R O C K W E
H. B. R O C K W A Y
Delaware & Hudson Co
Hudson River
Lackawanna
RESERVED
MAP OF
DUNMORE No 3 VEIN
Northern Coal Field.
SCRANTON, PA.
LACKAWANNA TWIP,
LACKA., COUNTY,
PENNSYLVANIA.
MAY 6, 1921. NOV. 5, 1936 A.D.
SCALE 1" = 100'