

Western Middle Field... LAWRENCE - STANTON COLLIERY


"..SECTION THROUGH CENTRE ST. JOHN'S GREEK CATHOLIC CHURCH
AT MAIZEVILLE, PENNA."

... SCALE: 1" = 100' ...
HARLEIGH-BROOKWOOD COAL CO.
MAHANÓY PLANE, PA.

POTTSVILLE, PA.

APRIL 8-1916

WEST MAHANÓY TWP., SCHUYLKILL COUNTY, 11-W. MAHANÓY DISTRICT.

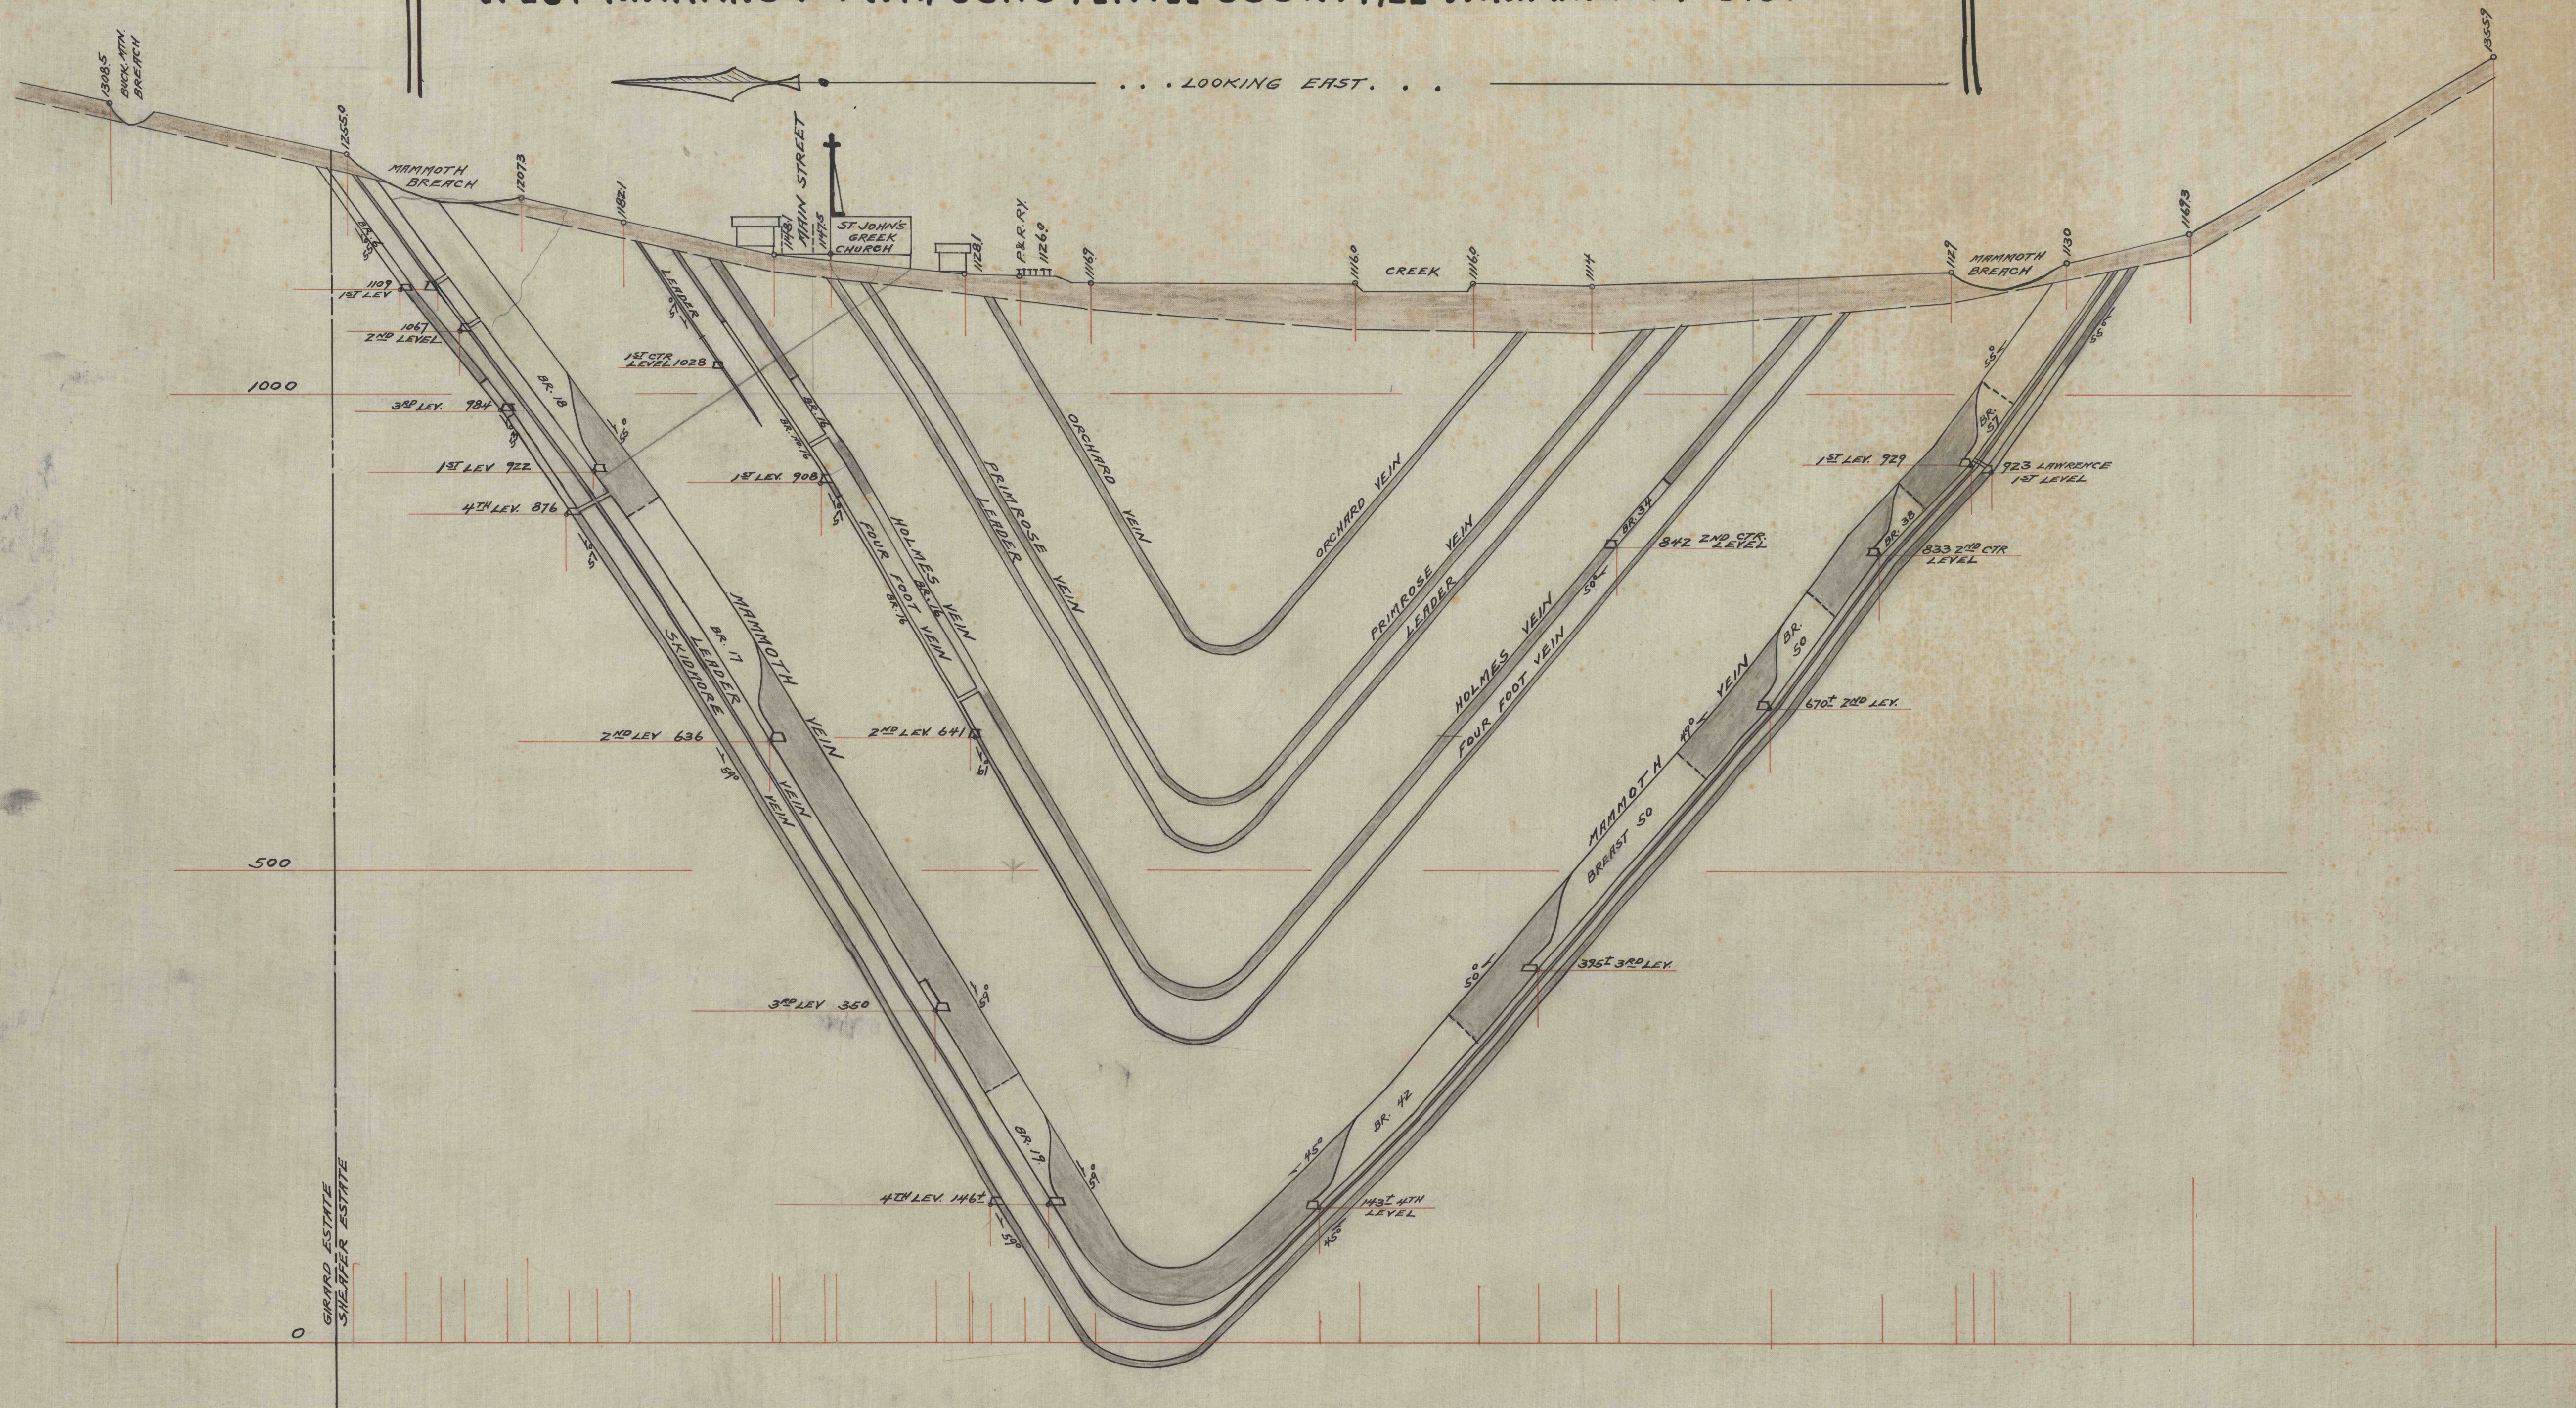

MF
MAR 13 1975

P217