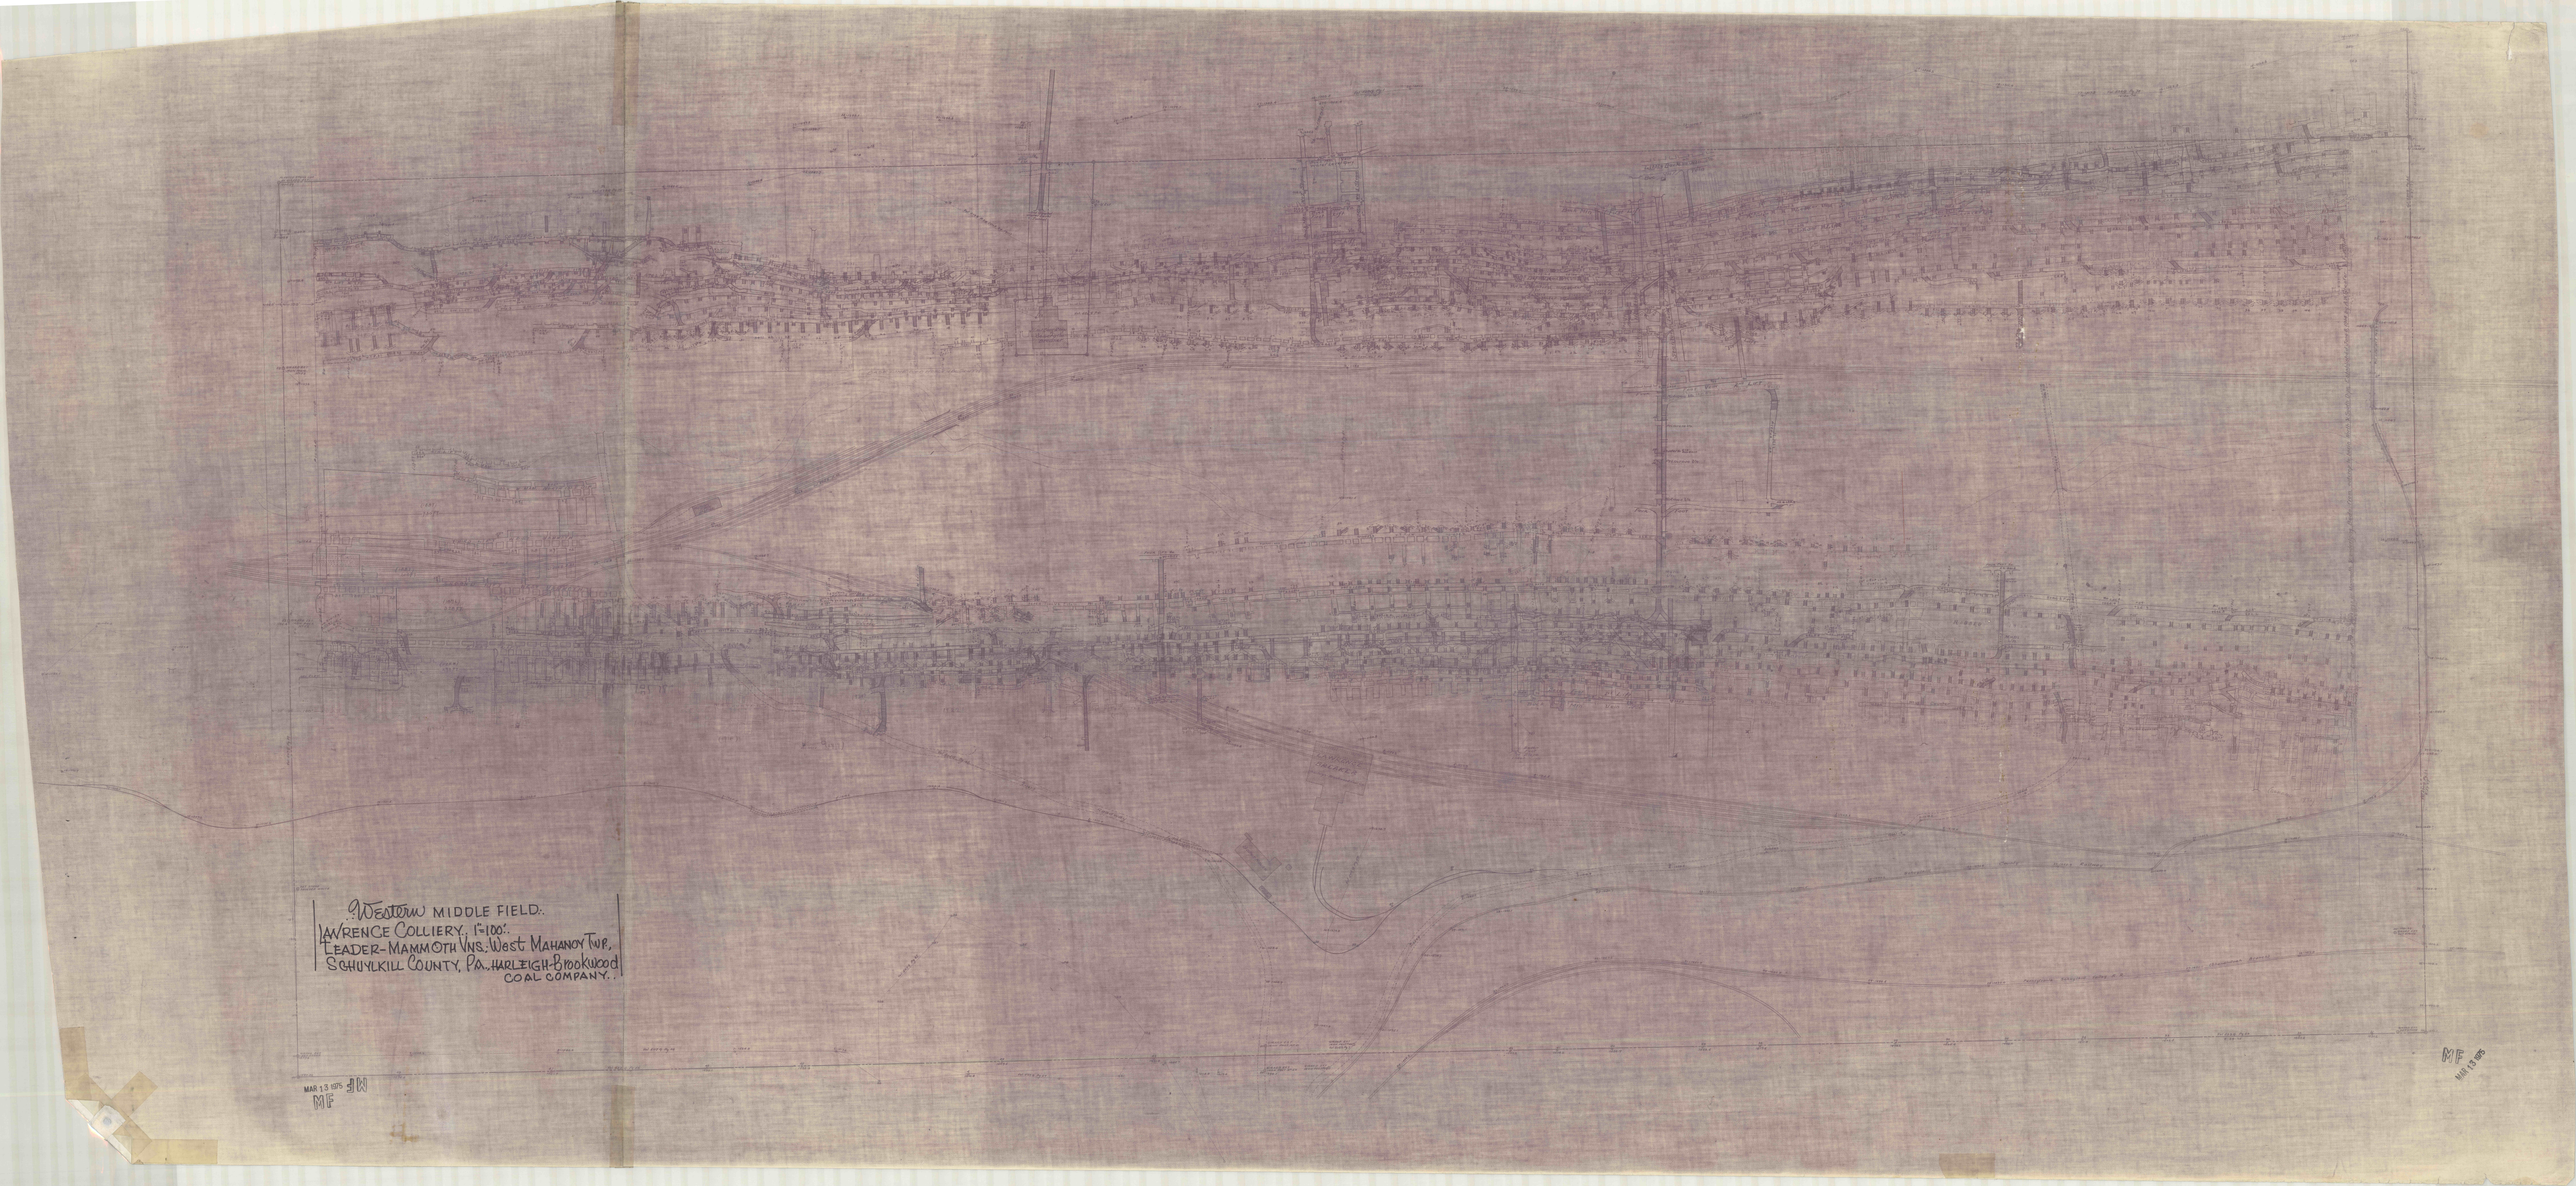

Western MIDDLE FIELD.
LAWRENCE COLLIERY, 1"=100'.
LEADER-MAMMOTH VNS. West Mahanoy Twp,
SCHUYLKILL COUNTY, PA. HARLEIGH-BROOKWOOD
COAL COMPANY.
MAR 13 1975
MF
MF
MAR 13 1975