
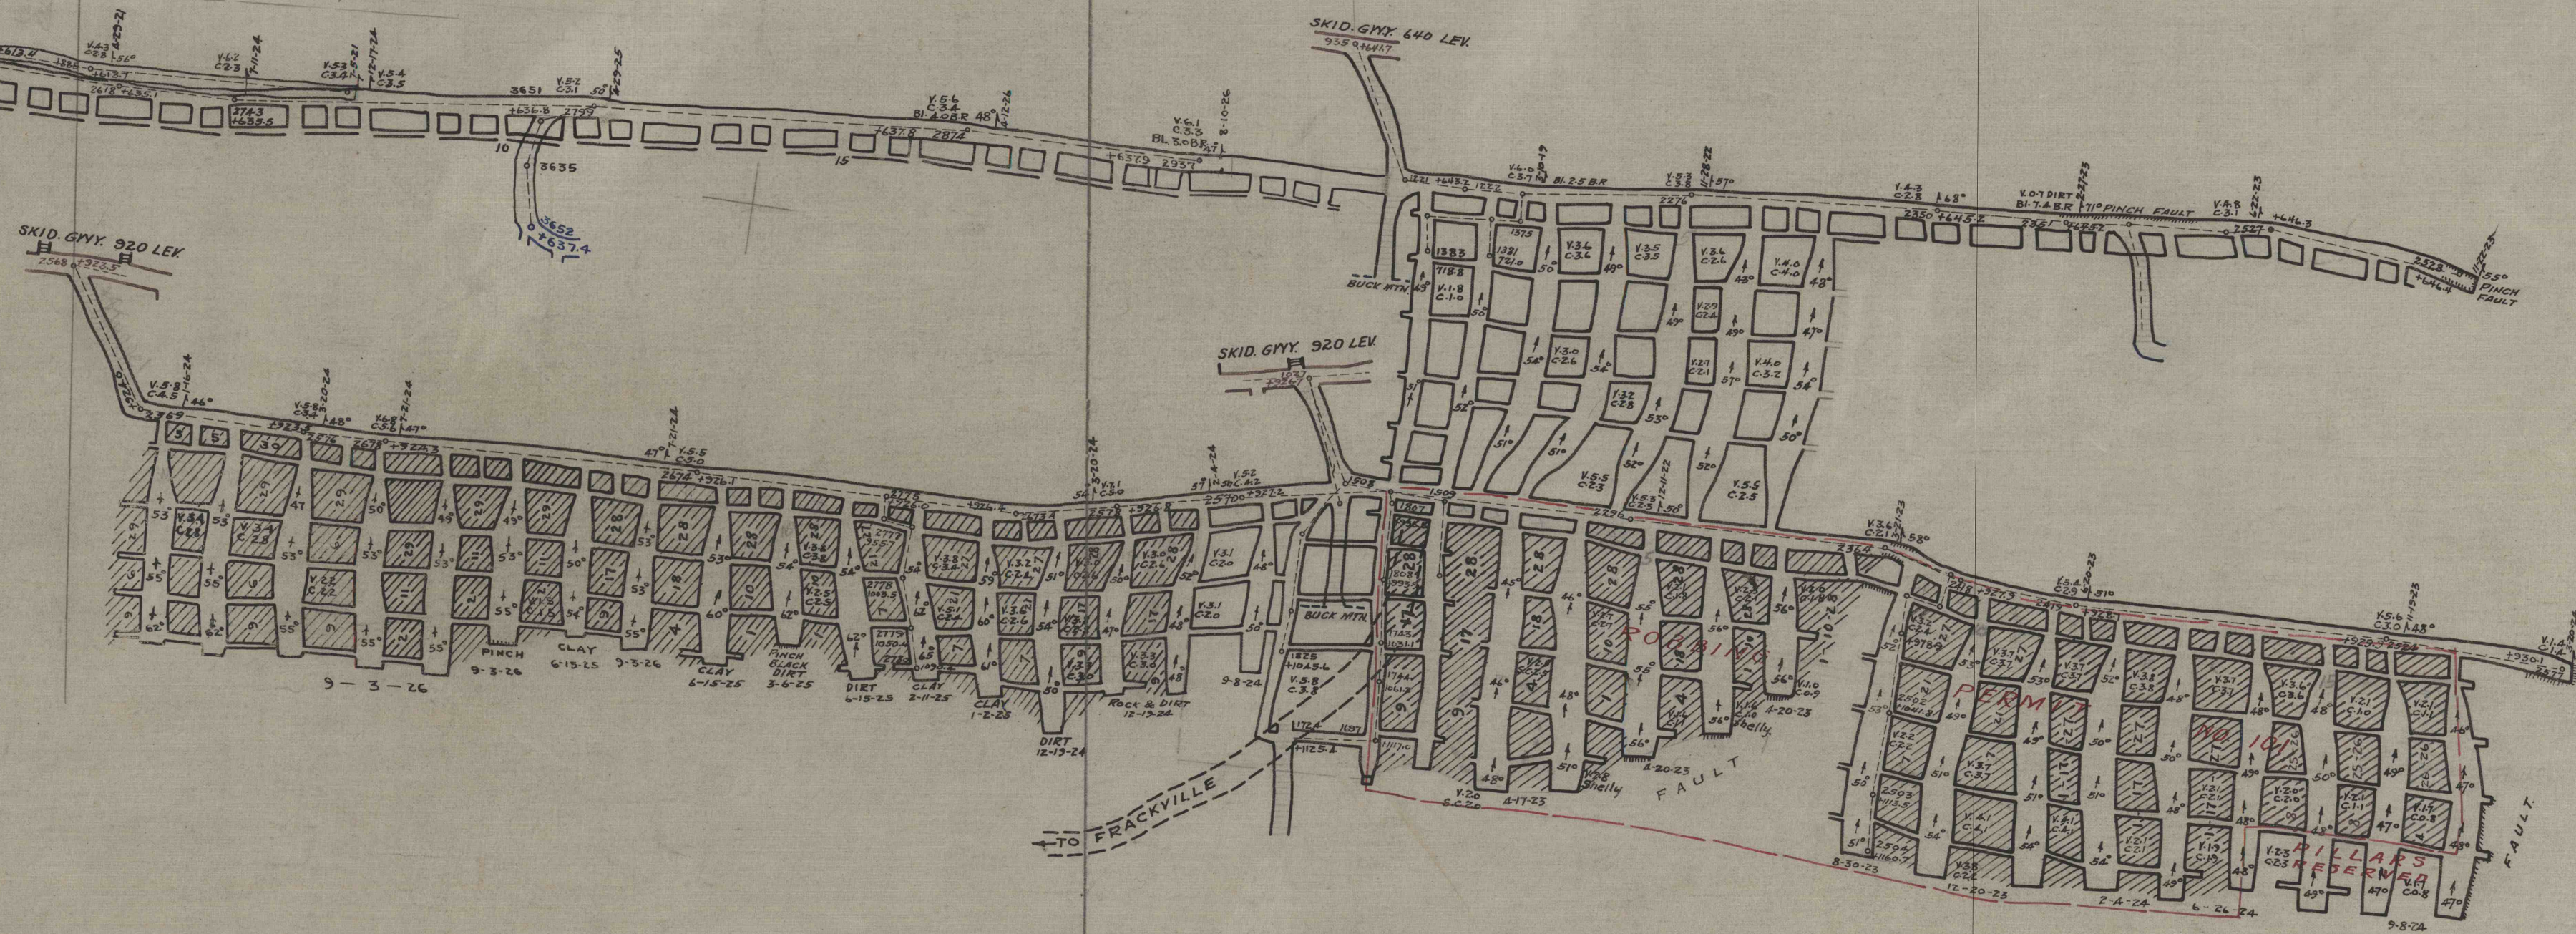
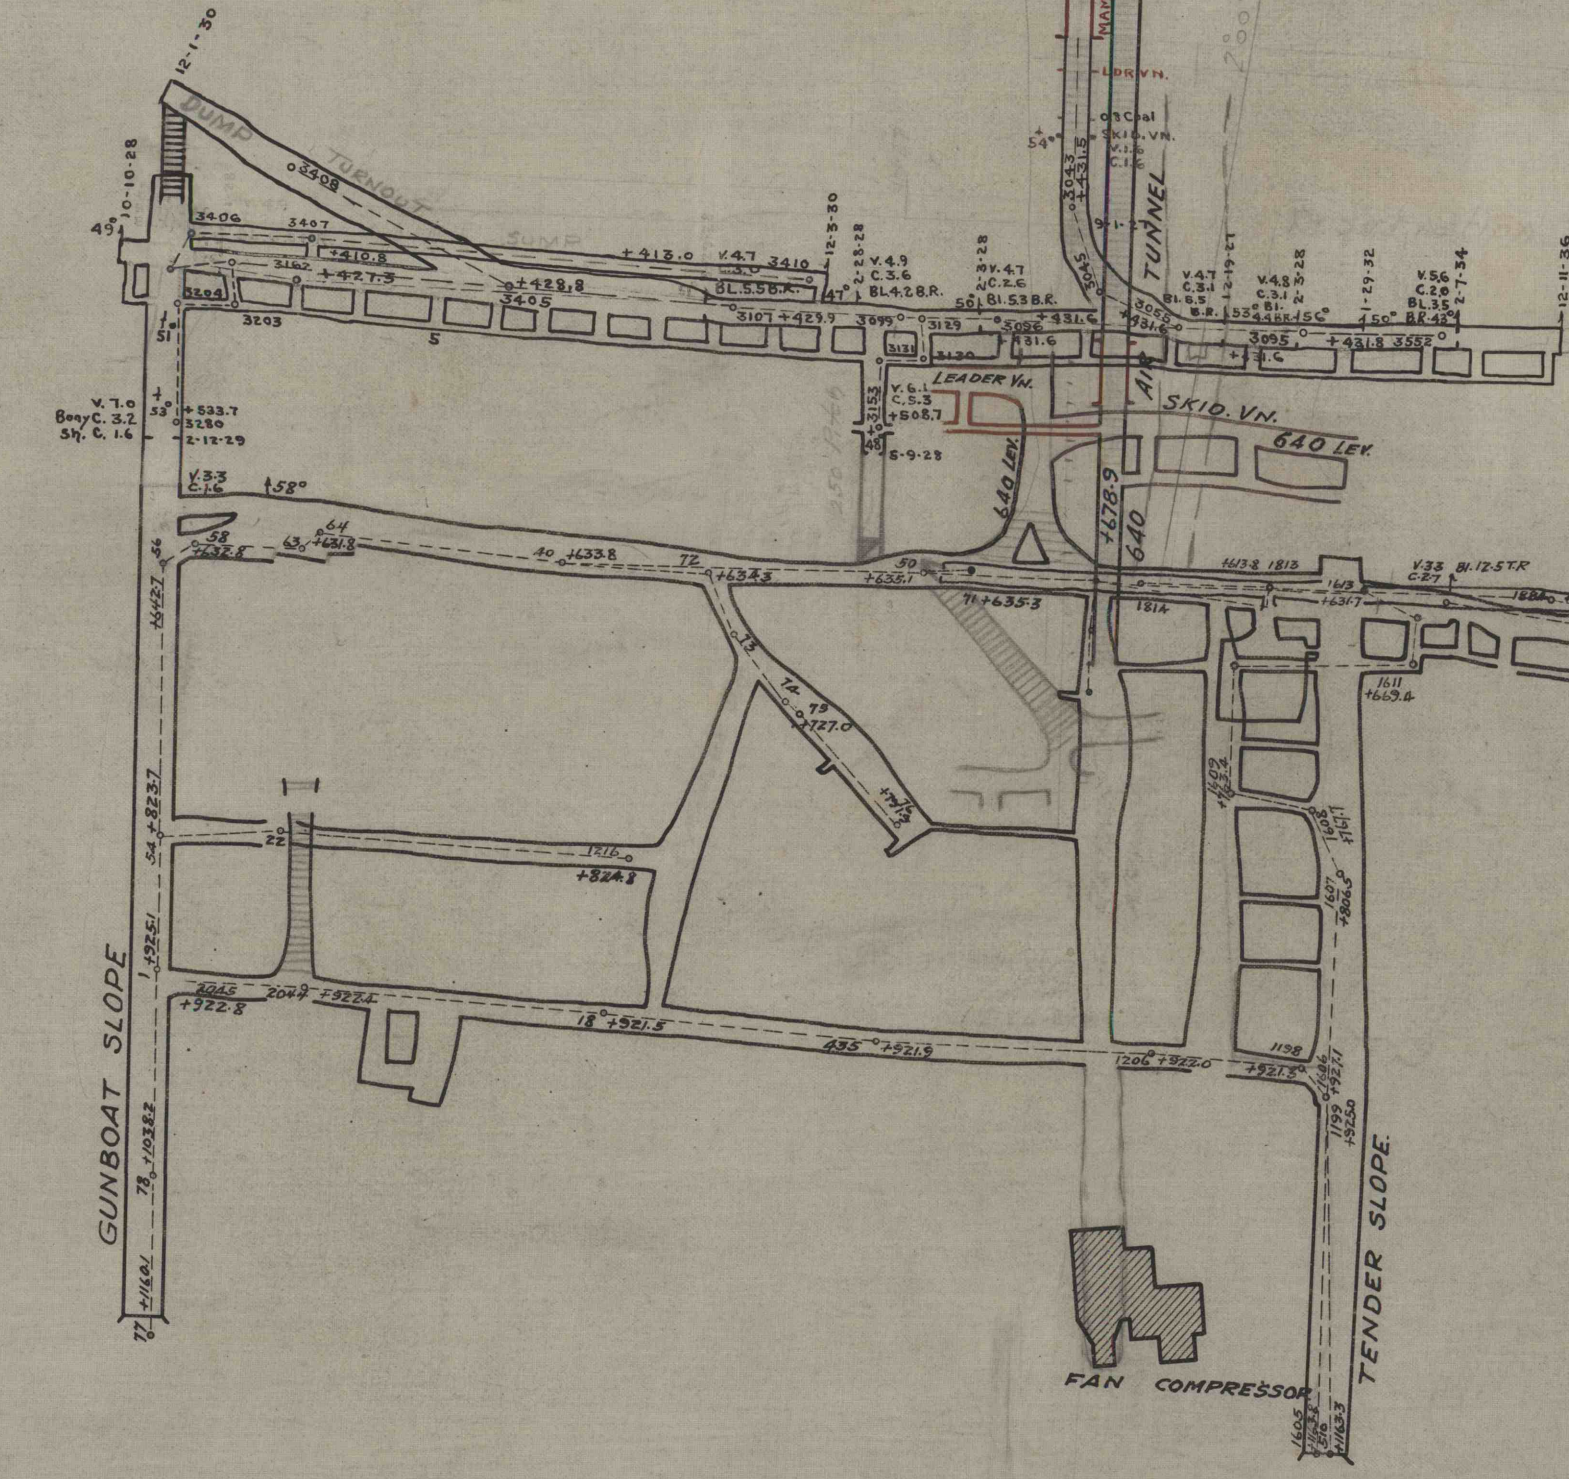
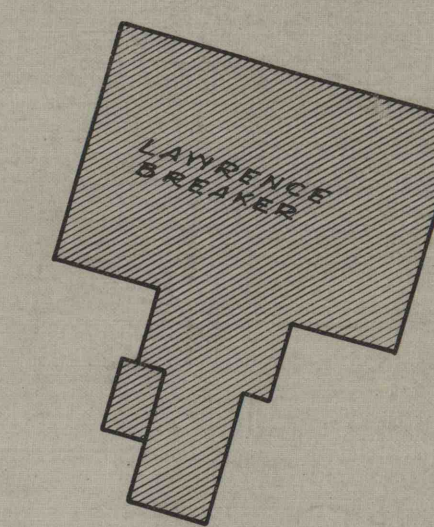
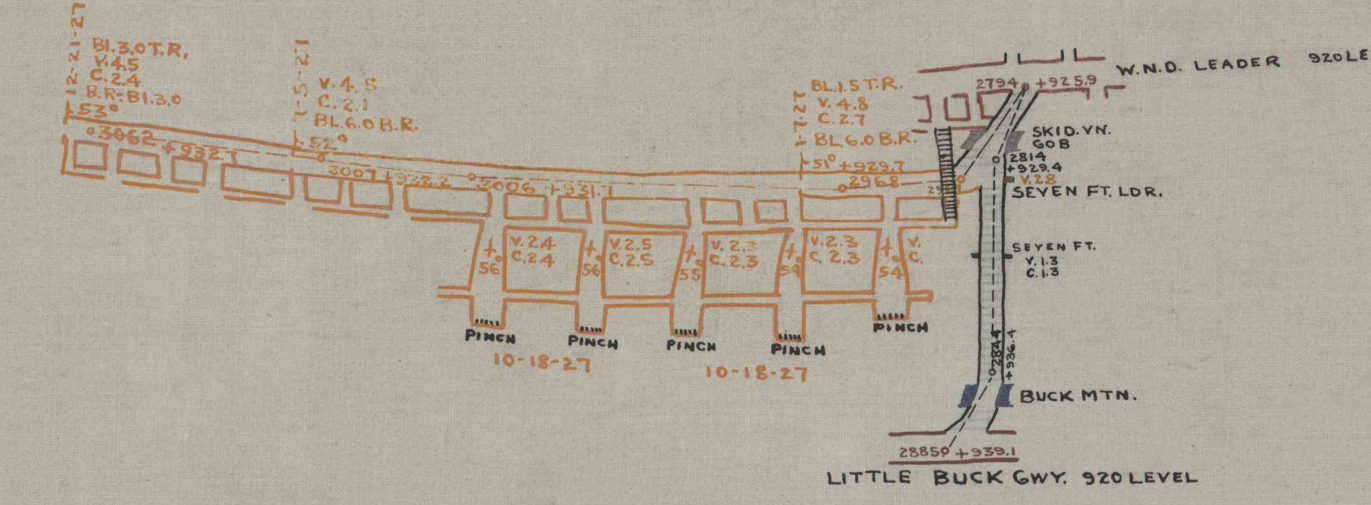
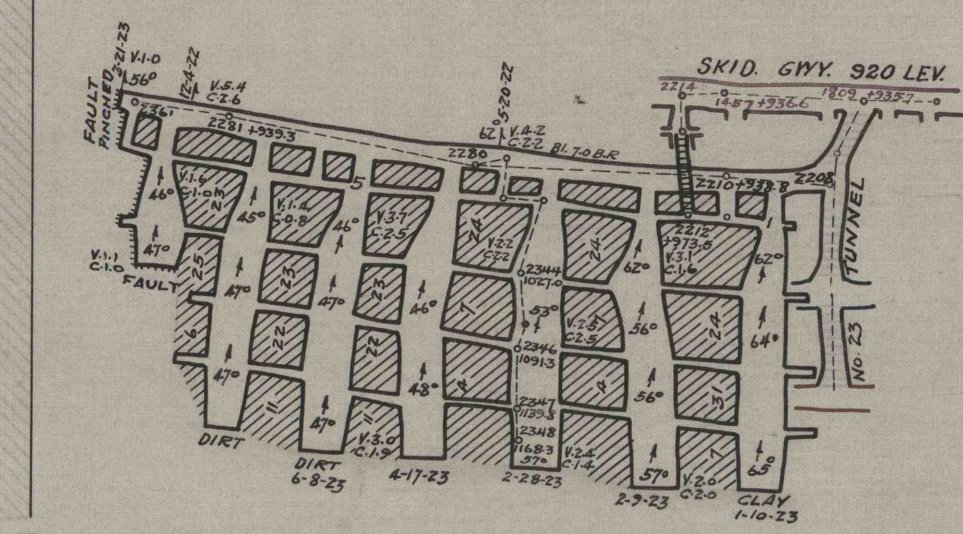
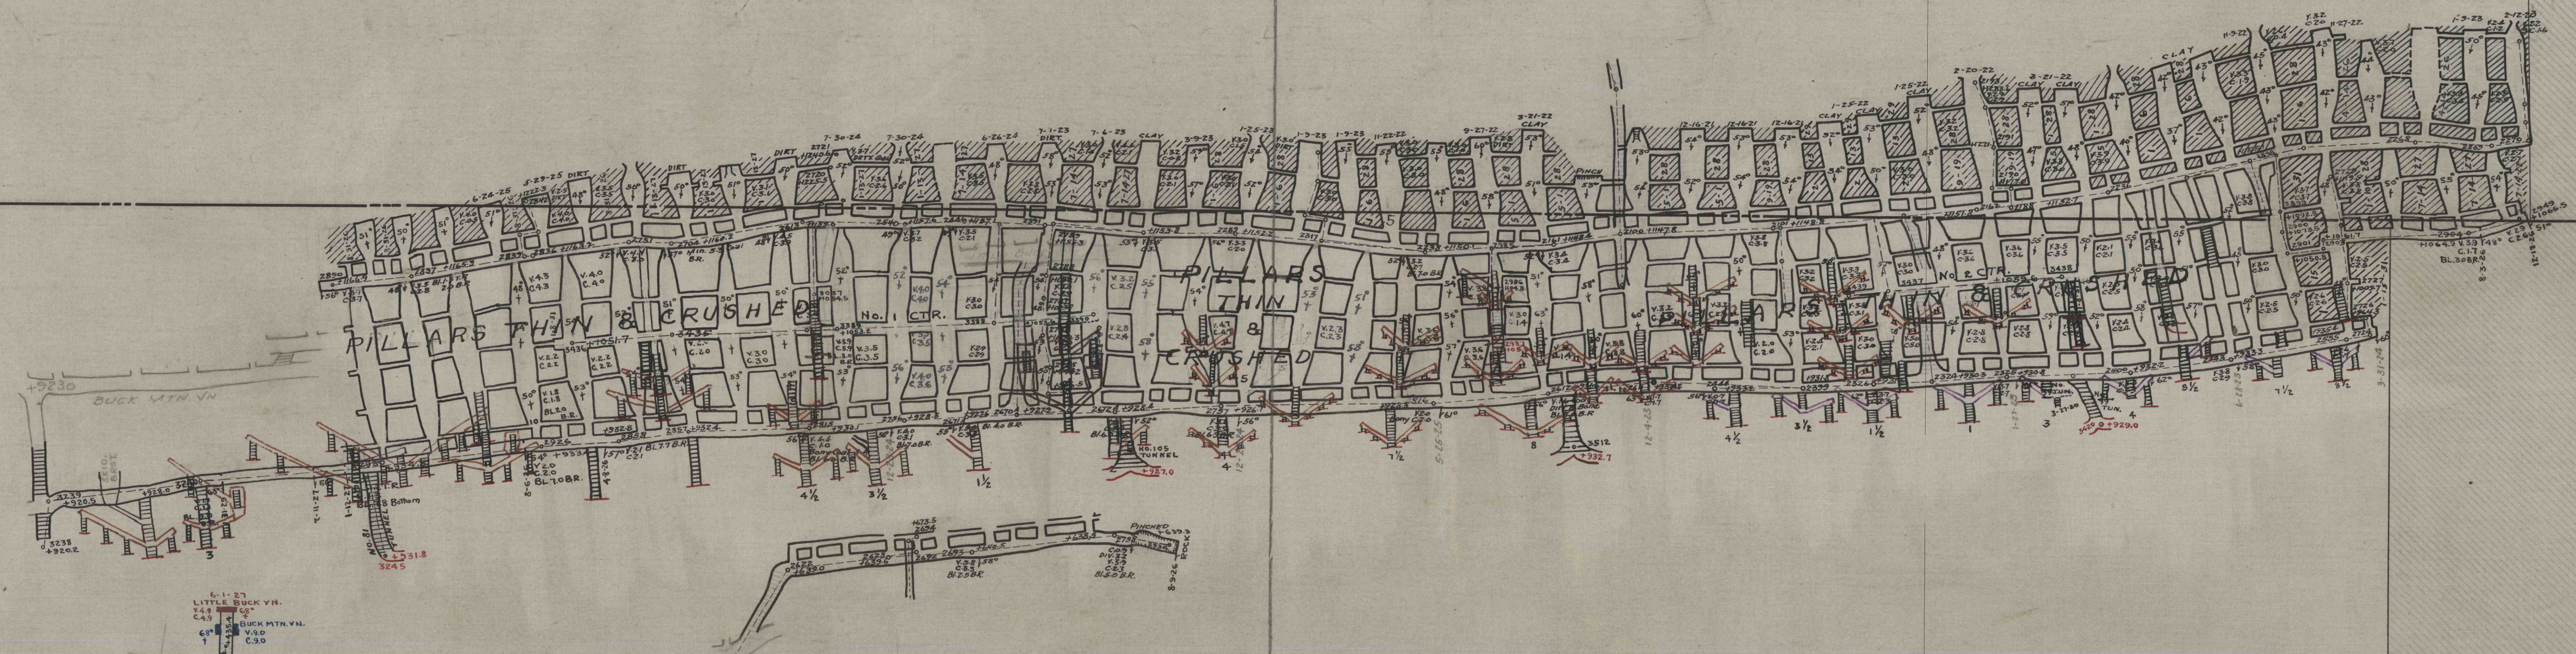
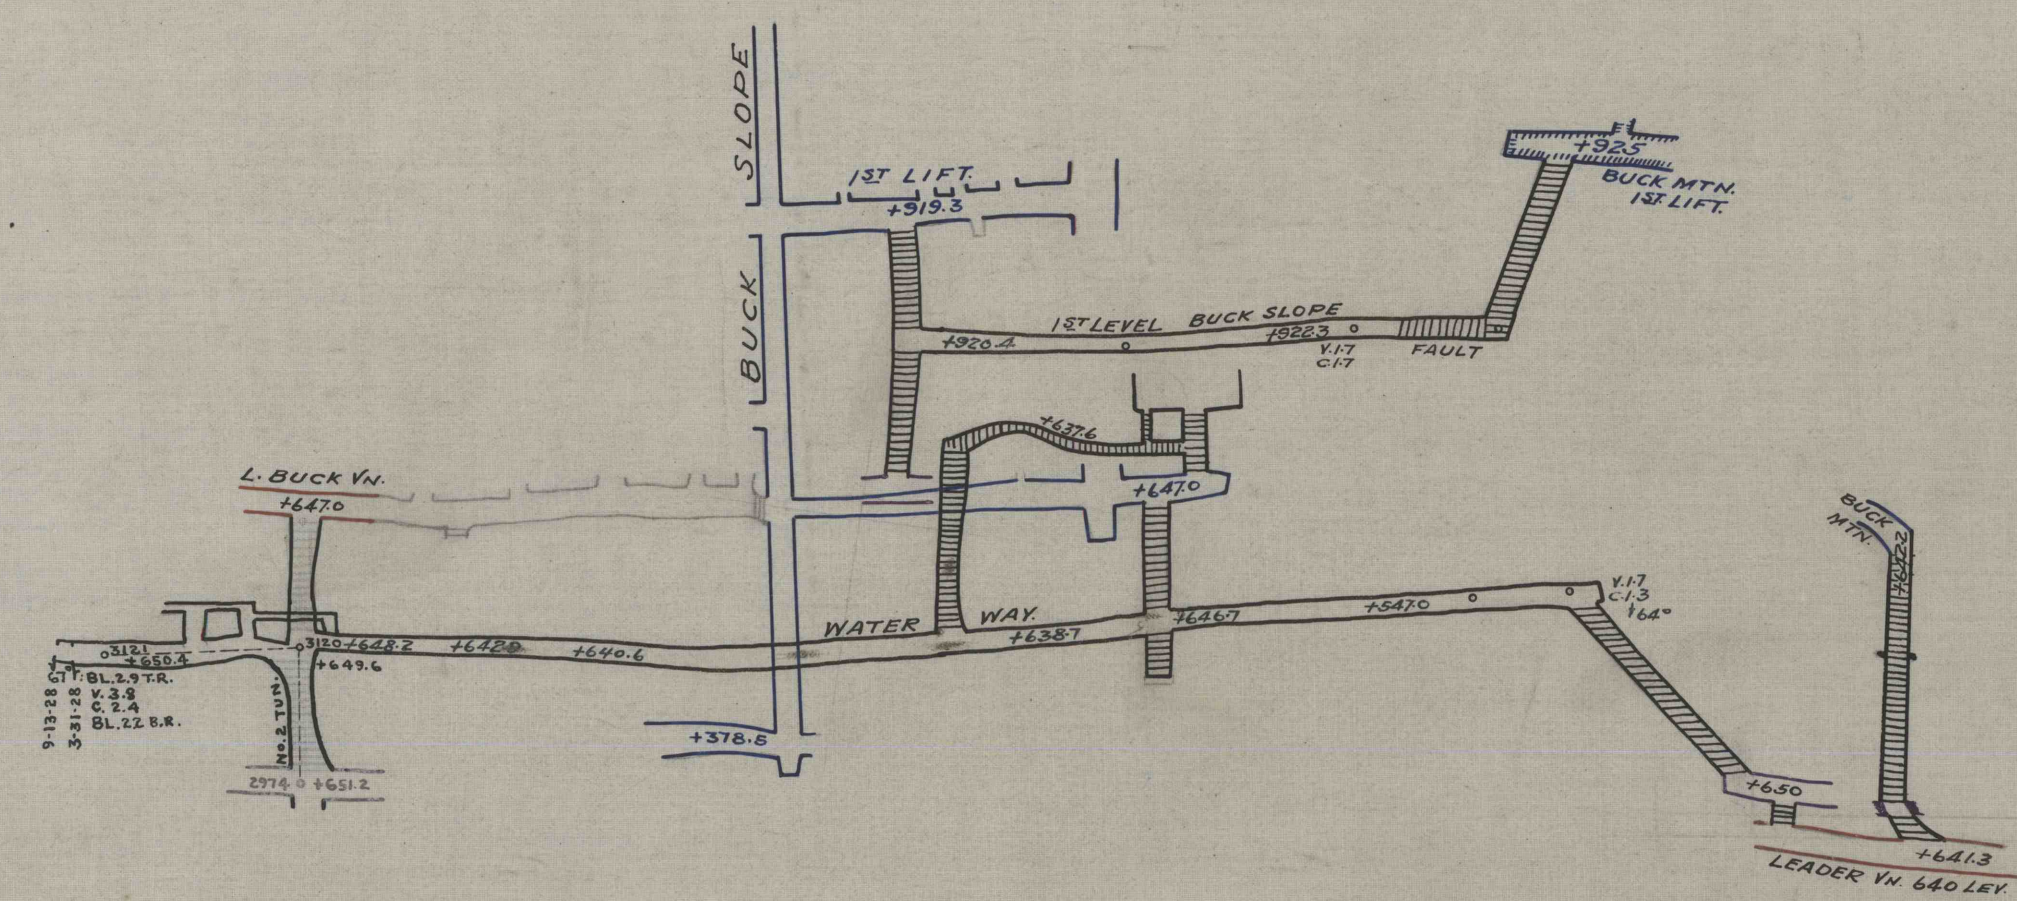


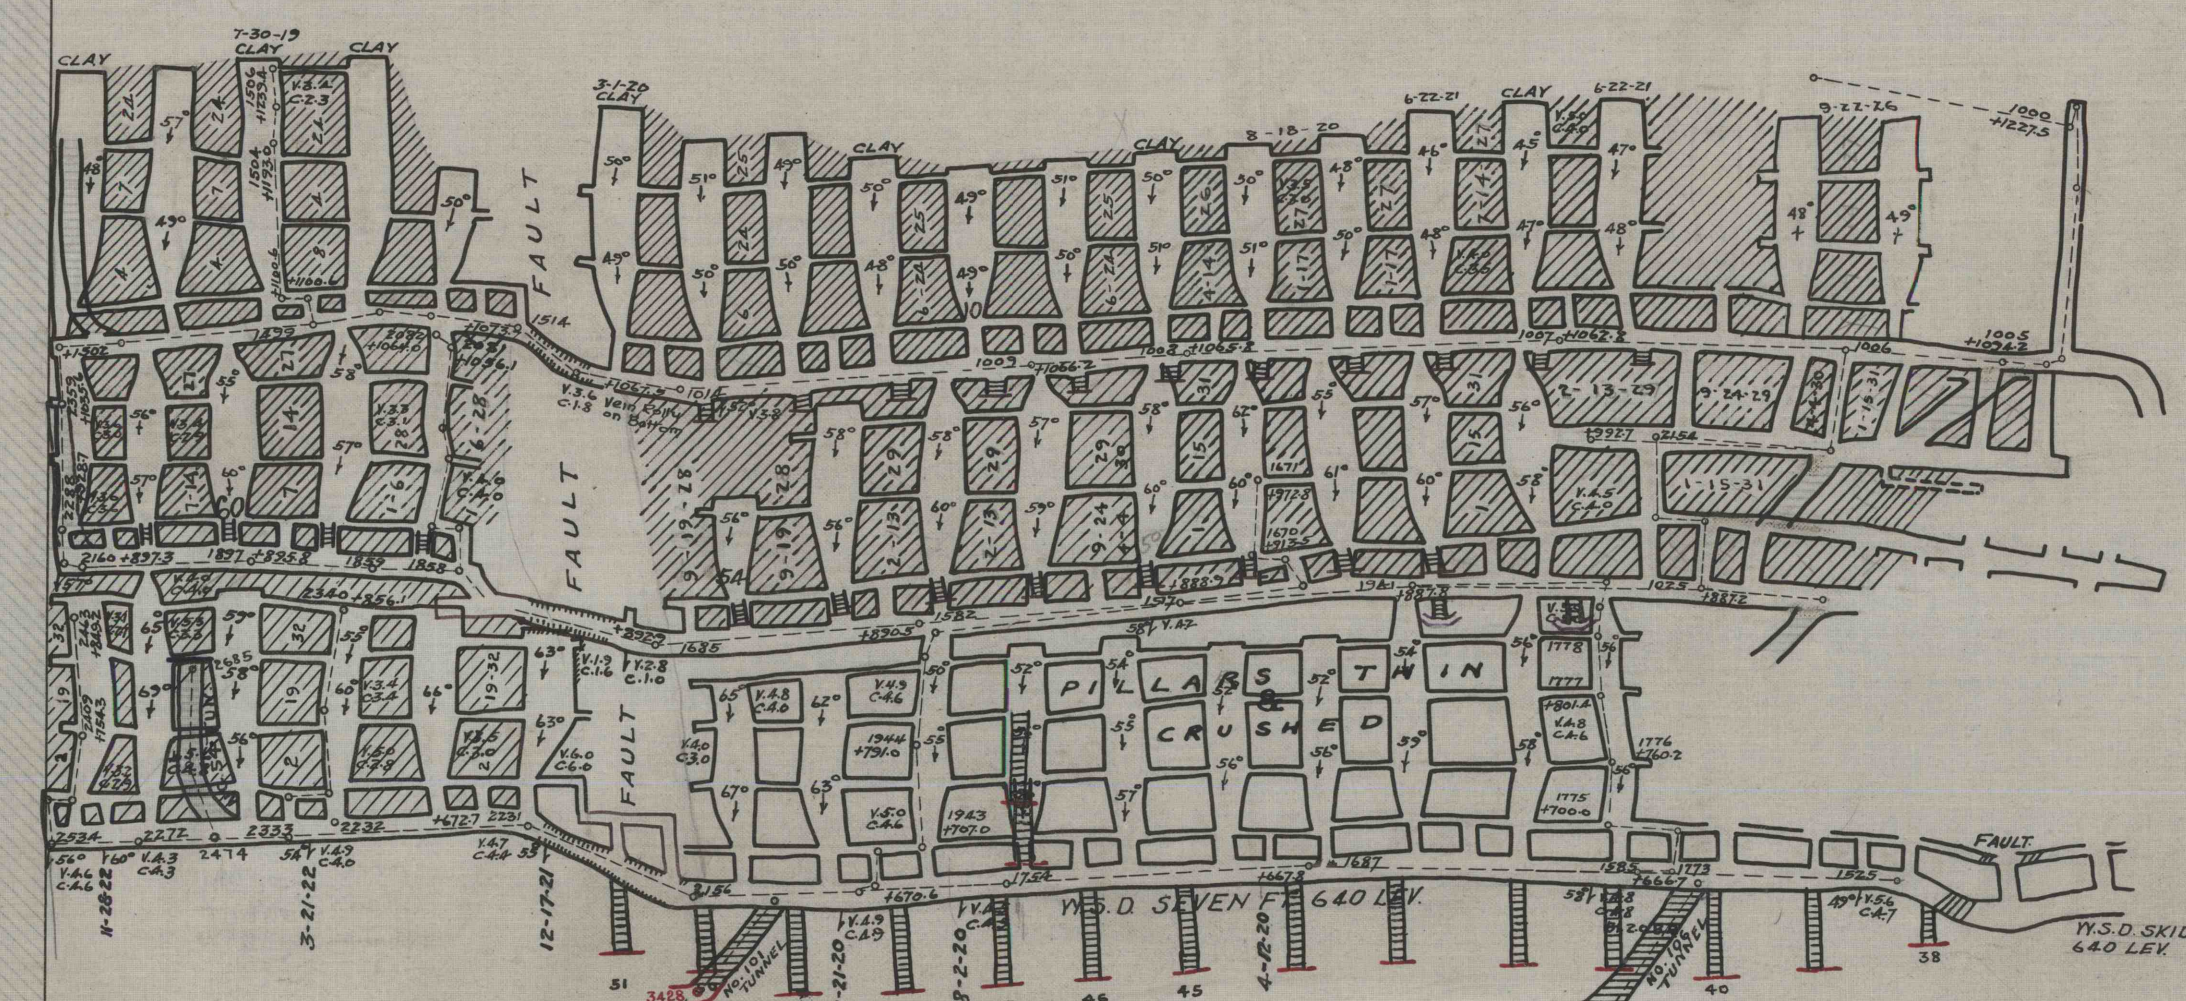

MF MAR 13 1975

Western Middle Field
SEVEN FOOT VEIN
LAWRENCE COLLIERY
WEST MAHANOH TOWNSHIP
HARLEIGH-BROOKWOOD COAL CO.
SCHUYLKILL COUNTY, PA.
AUG 17, 1925
SCALE 1 in. = 100 ft.

WESTERN MIDDLE FIELD
SEVEN FOOT VEIN
LAWRENCE COLLIERY
WEST MAHANOH TOWNSHIP
HARLEIGH-BROOKWOOD COAL CO.
SCHUYLKILL COUNTY, PA.
AUG 17, 1925
SCALE 1 in. = 100 ft.