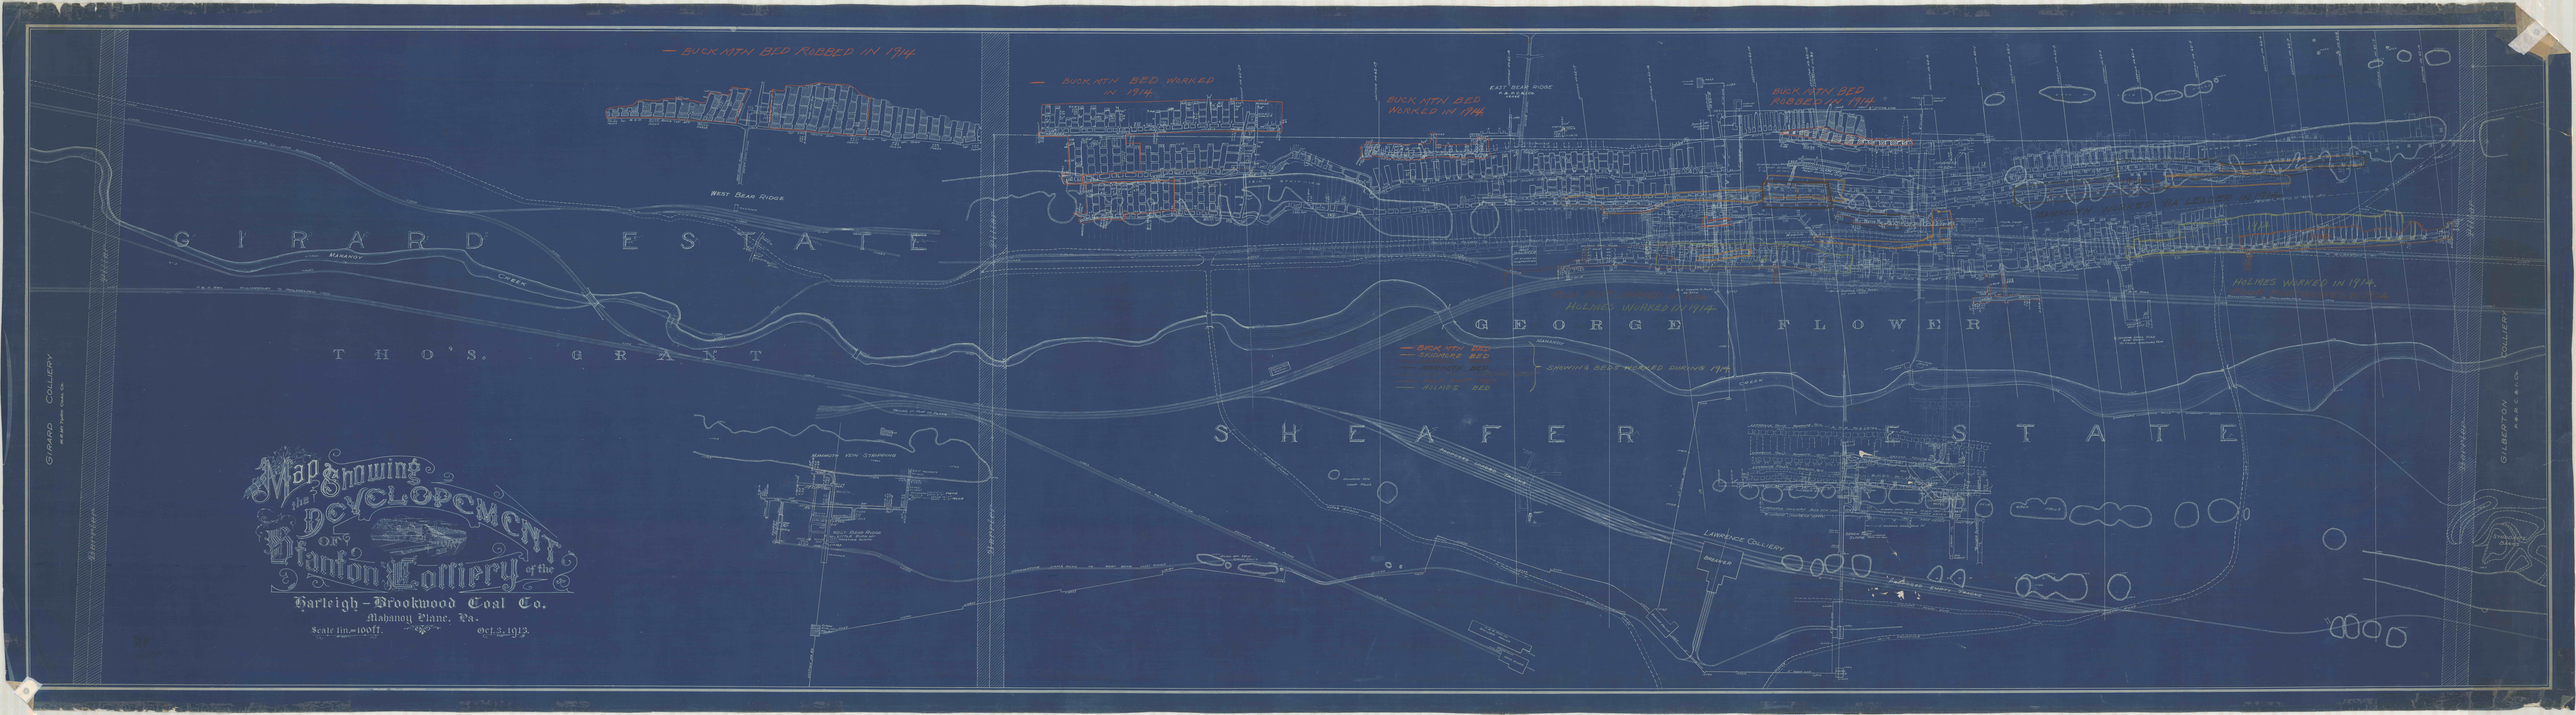

Map Showing the Development of Stanton Colliery of the
Harleigh-Brookwood Coal Co.
Mahanoy Plane, Pa.
Scale 1in.=100ft.
Oct. 3, 1913.
GIRARD ESTATE
THO'S. GRANT
GEORGE FLOWER
SHEAFER ESTATE
BUCK MTN. BED ROBBED IN 1914
BUCK MTN. BED WORKED IN 1914
HOLMES WORKED IN 1914
WEST BEAR RIDGE
EAST BEAR RIDGE
MAHANOY CREEK
LAWRENCE COLLIERY
GILBERTON COLLIERY
GIRARD COLLIERY