Western Middle Field:

LOCUST GAP COLLIERY

MAP OF FOUR FOOT VEIN

A.R. Harris - Div. Engr.

Mt. Carmel, Pa. April 20/1922.

Scale 100 ft. - 1 inch

CARMEL TWP., NORTHUMBERLAND COUNTY, PA.

READING ANTHRACITE COLLIERIES.

FEB 28 1979 MICRO-FILMED.

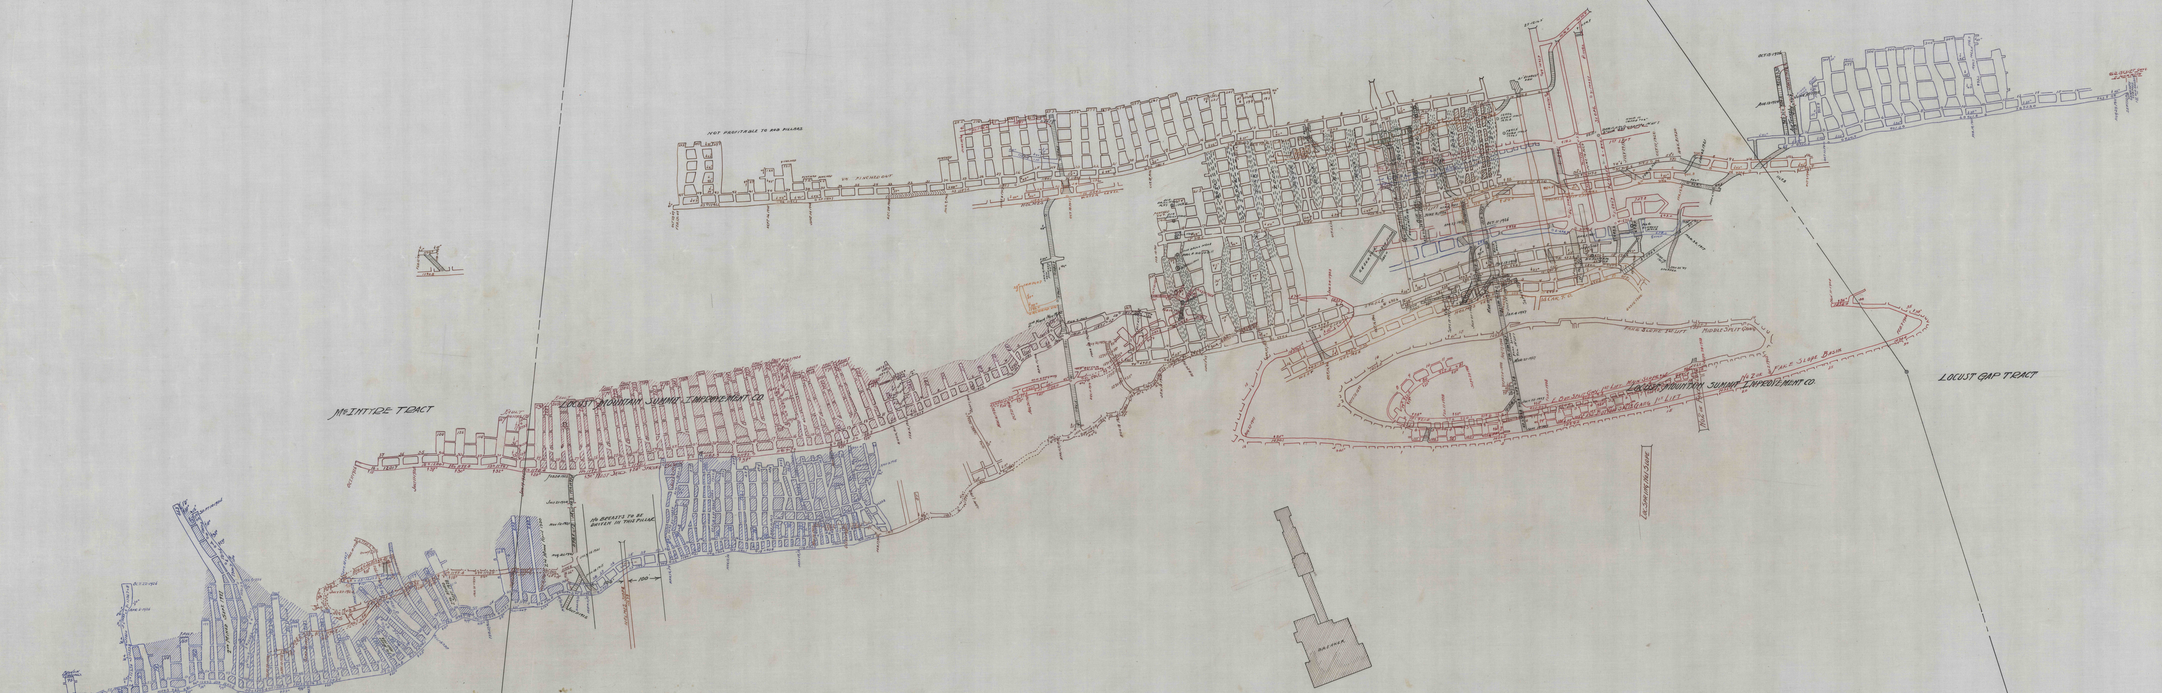

