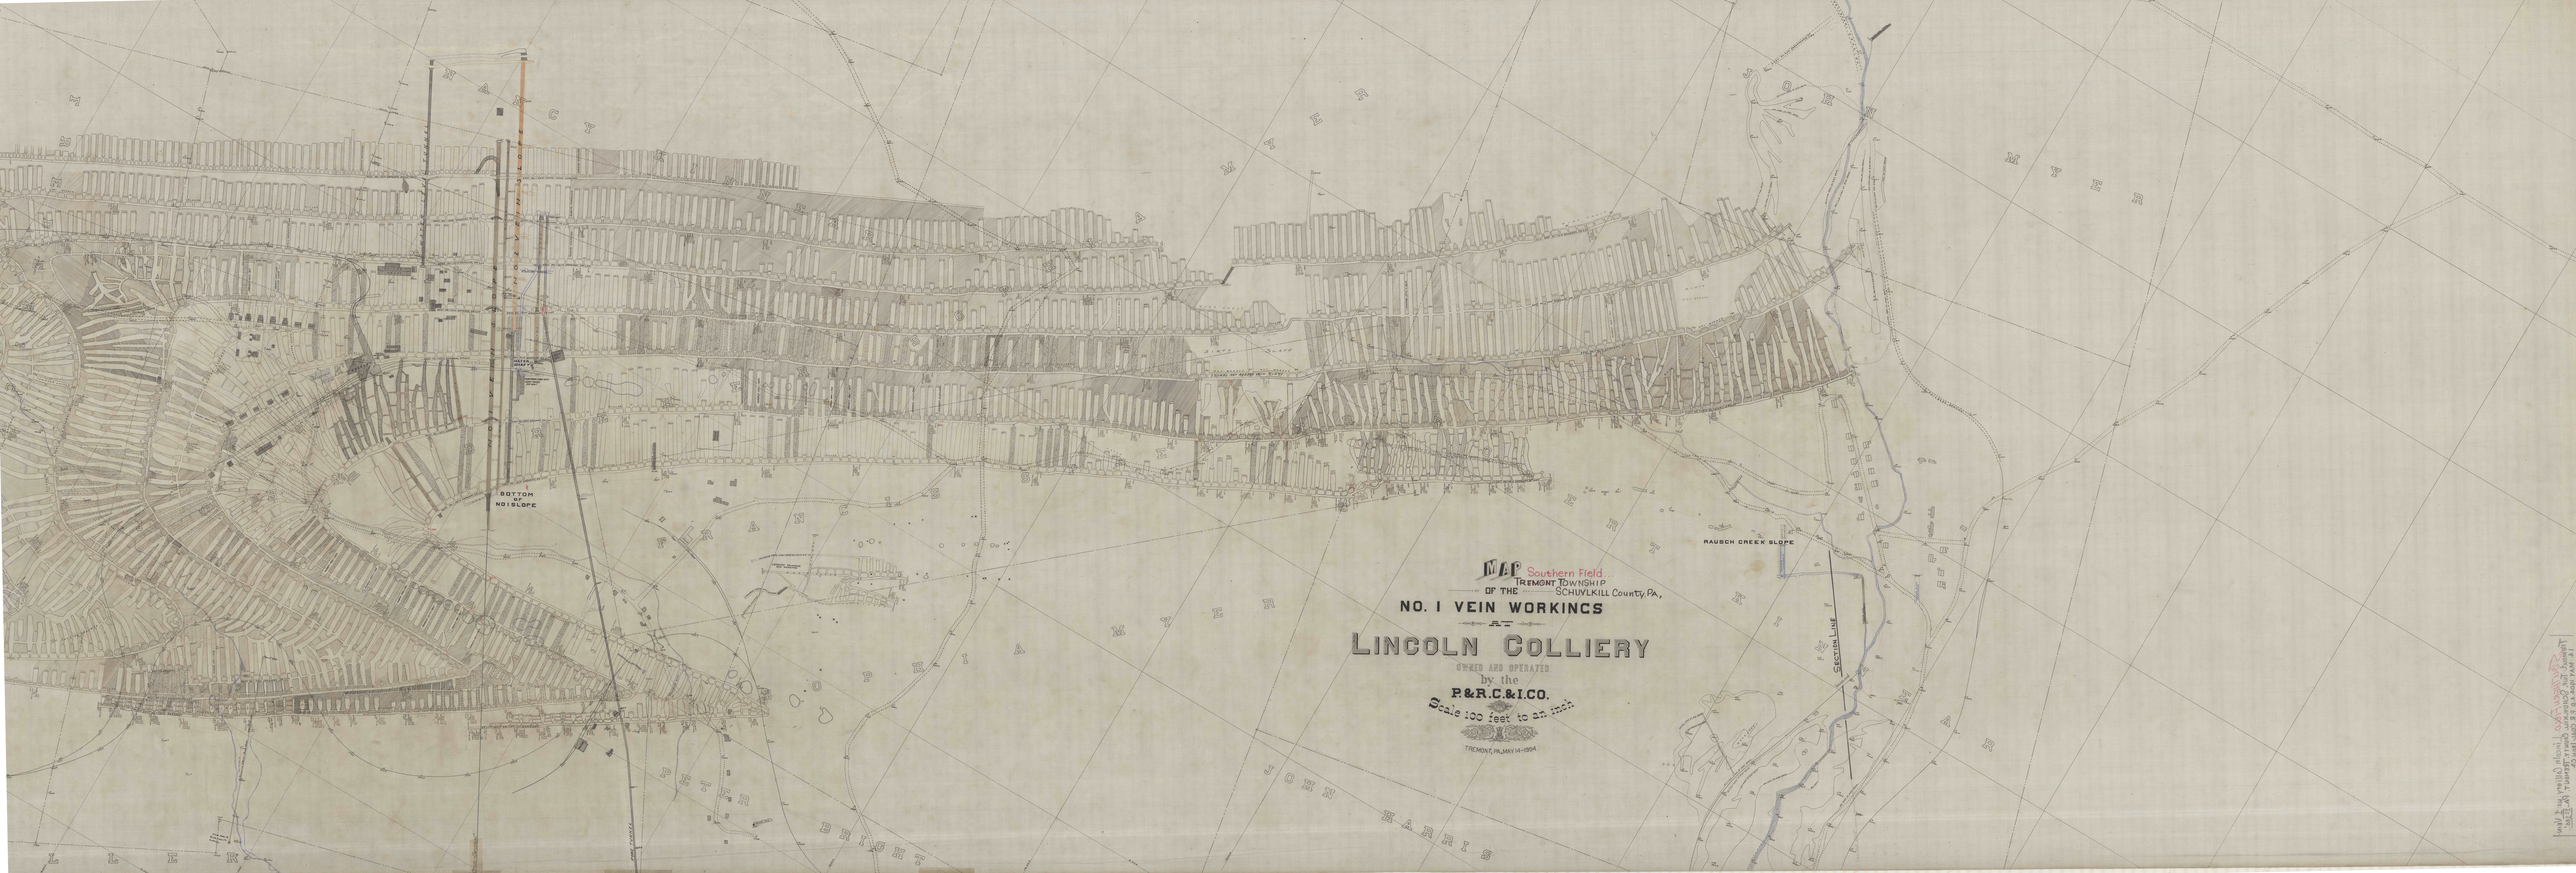

MAP Southern Field
TREMONT TOWNSHIP
OF THE SCHUYLKILL County, PA.,
NO. 1 VEIN WORKINGS
AT
LINCOLN COLLIERY
OWNED AND OPERATED
by the
P&R.C.&I.CO.
Scale 100 feet to an inch
TREMONT, PA. MAY 14-1904
BOTTOM OF NO 1 SLOPE
RAUSCH CREEK SLOPE
SECTION LINE
PETER BRIGHT
JOHN HARRIS