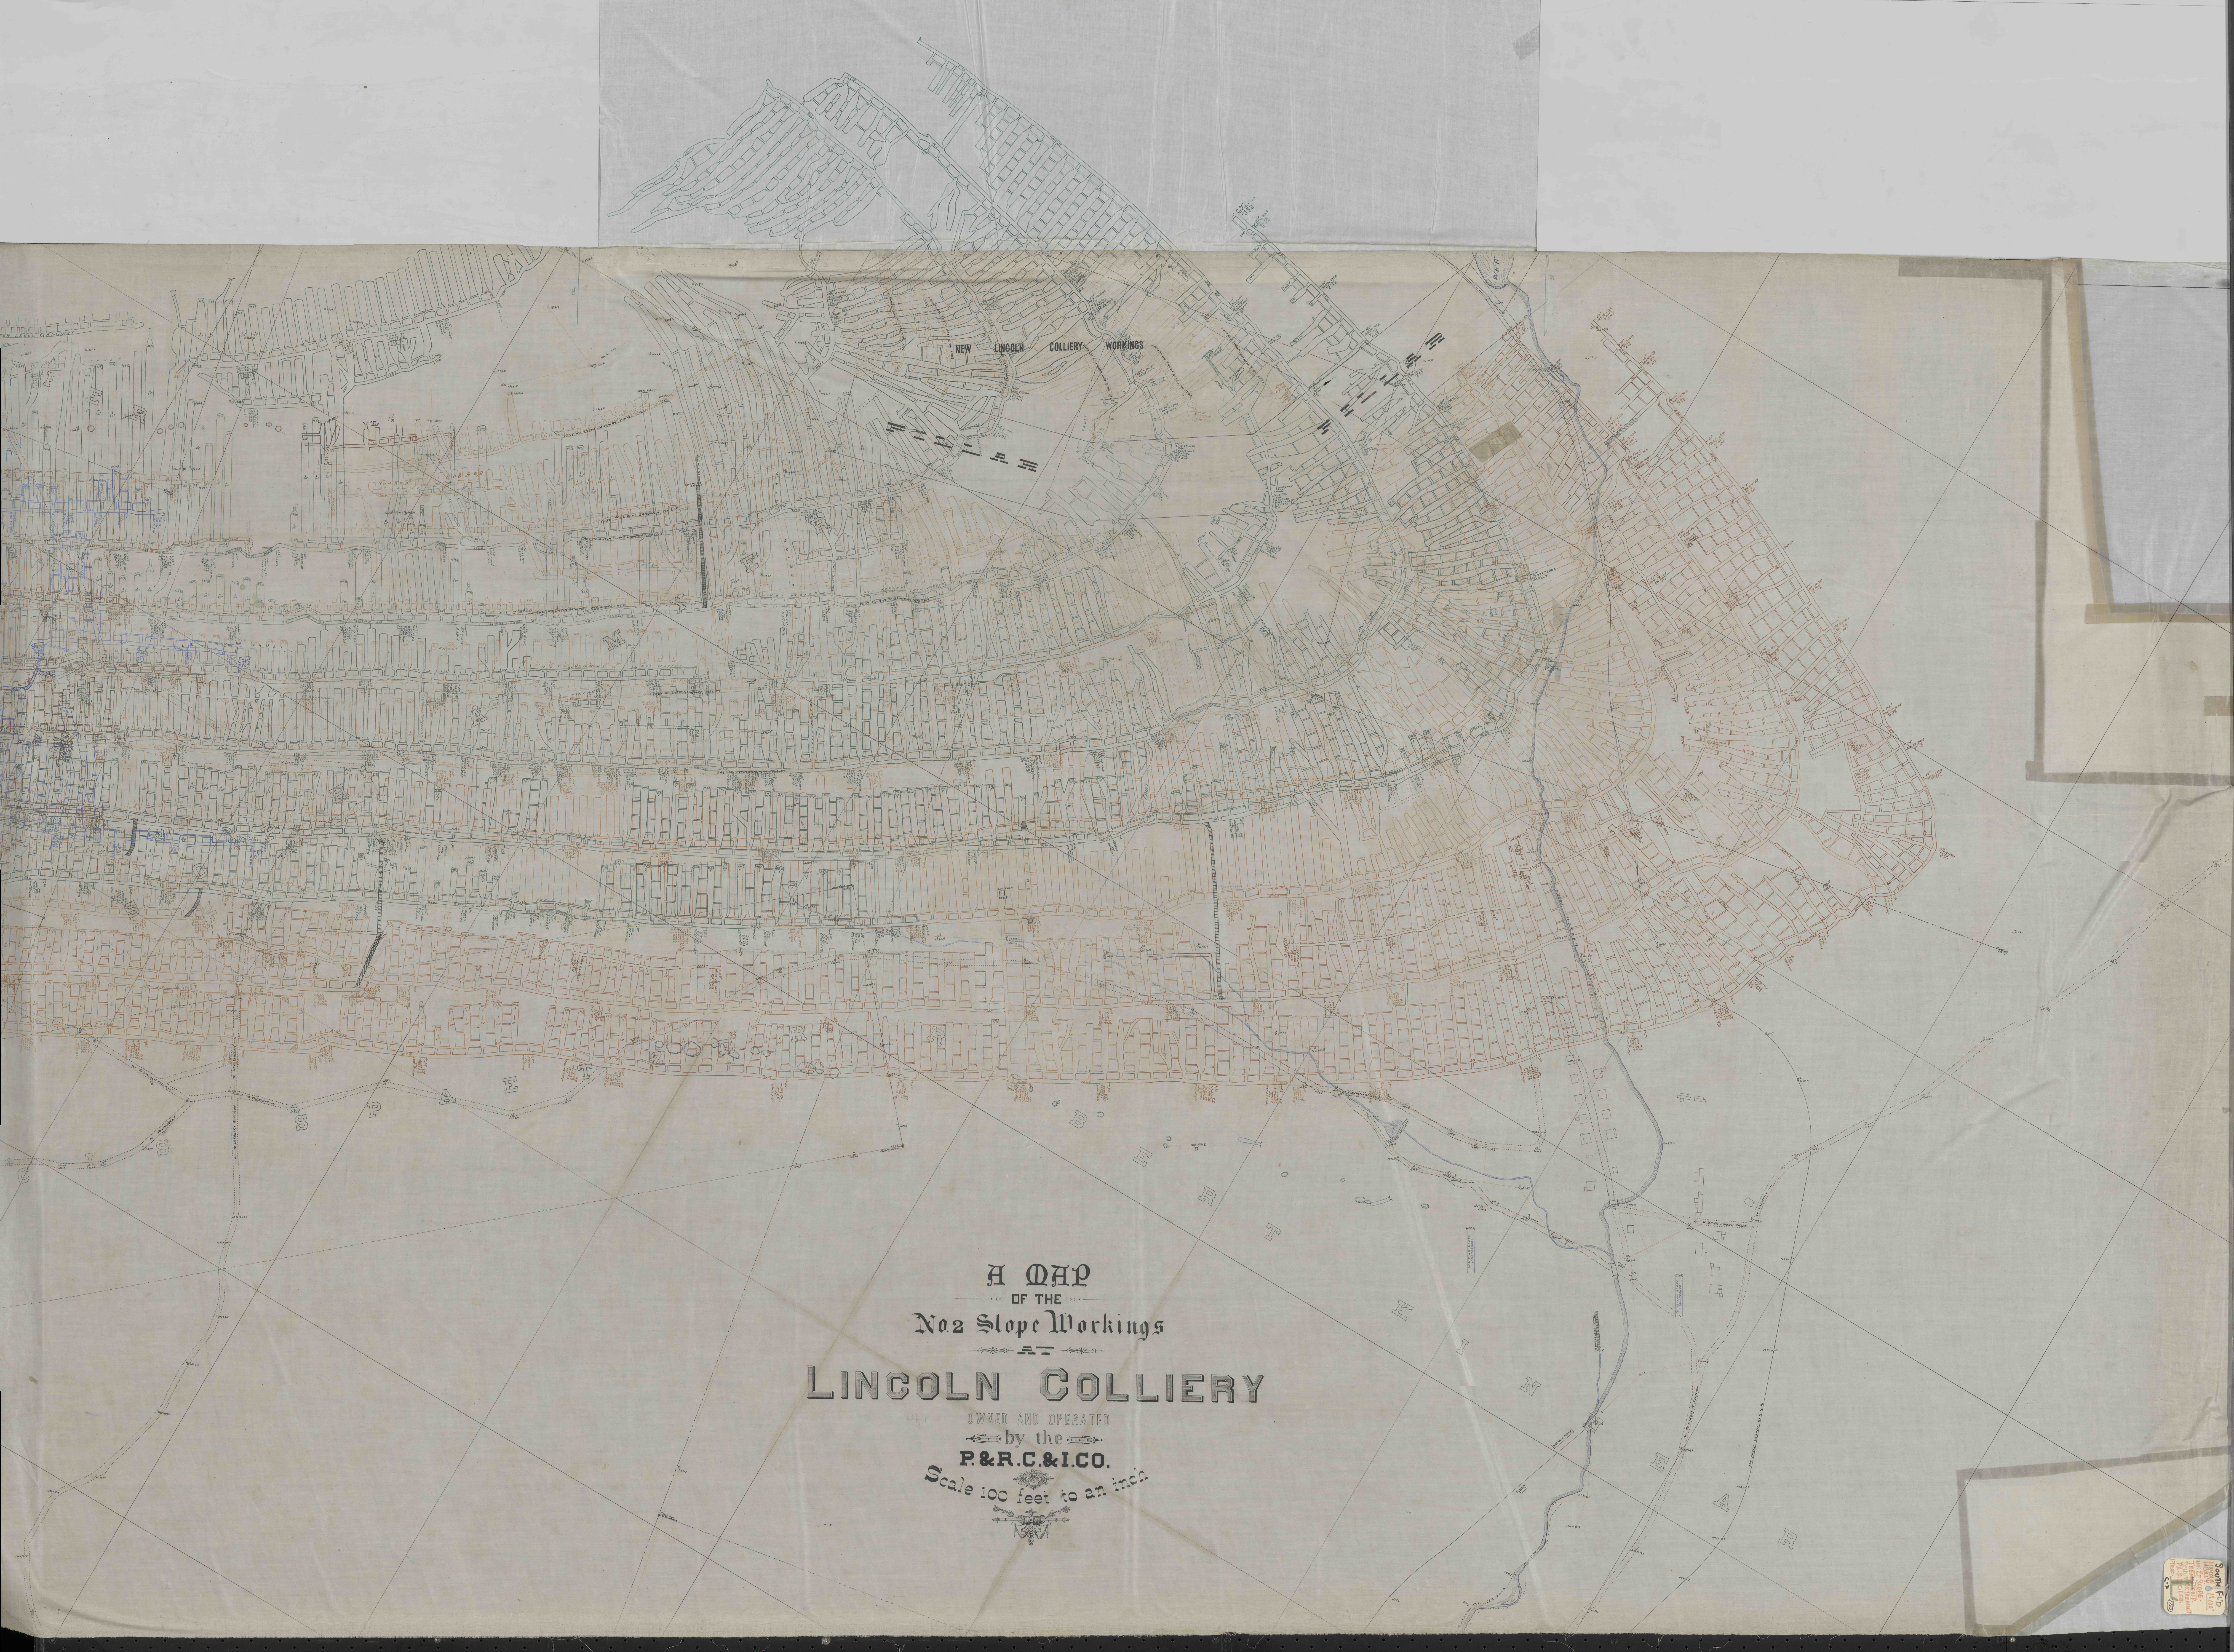

NEW LINCOLN COLLIERY WORKINGS
PLANE
ENG. ROOM
AIR HOLE
B
E
R
T

A MAP
OF THE
No. 2 Slope Workings
AT
LINCOLN COLLIERY
OWNED AND OPERATED
by the
P.&R.C.&I.CO.
Scale 100 feet to an inch

SOUTH FL'D
LINCOLN COLLY. 1"=100'
No. 2 SLOPE.
TREMONT TWP.
SCHUY. CO. TREMONT
PA. P.R.C.I.CO.
1 TRAC.
L
(1762)