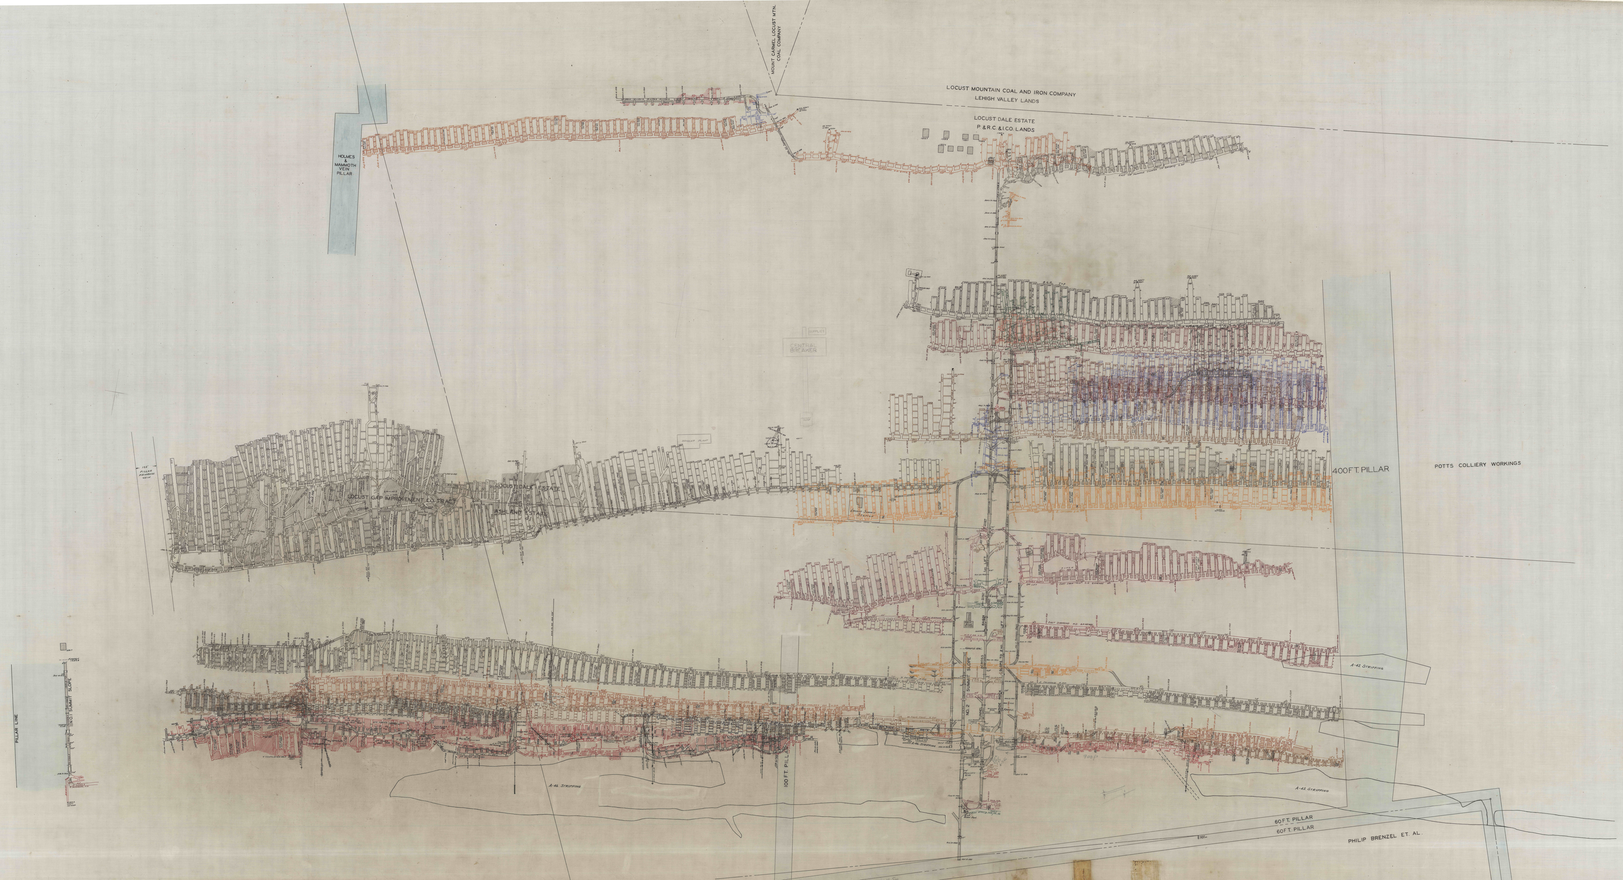

Western Middle Field.

LOCUST SPRING COLLIERY

MT. CARMEL TOWNSHIP
WEST MAHANOY DISTRICT No. 1.
NO. 2 SUMMIT WORKINGS
NORTHUMBERLAND COUNTY.
READING ANTHRACITE Collieries.

SCALE 1 INCH = 200 FEET — ASHLAND, PA. APRIL — 1906

OFFICE OF DIVISION ENGINEER