LOCUST SPRING COLLIERY

MAP OF TOP SPLIT VEIN

SCALE 100' PER INCH

A.R. HARRIS, DIV. ENGR.
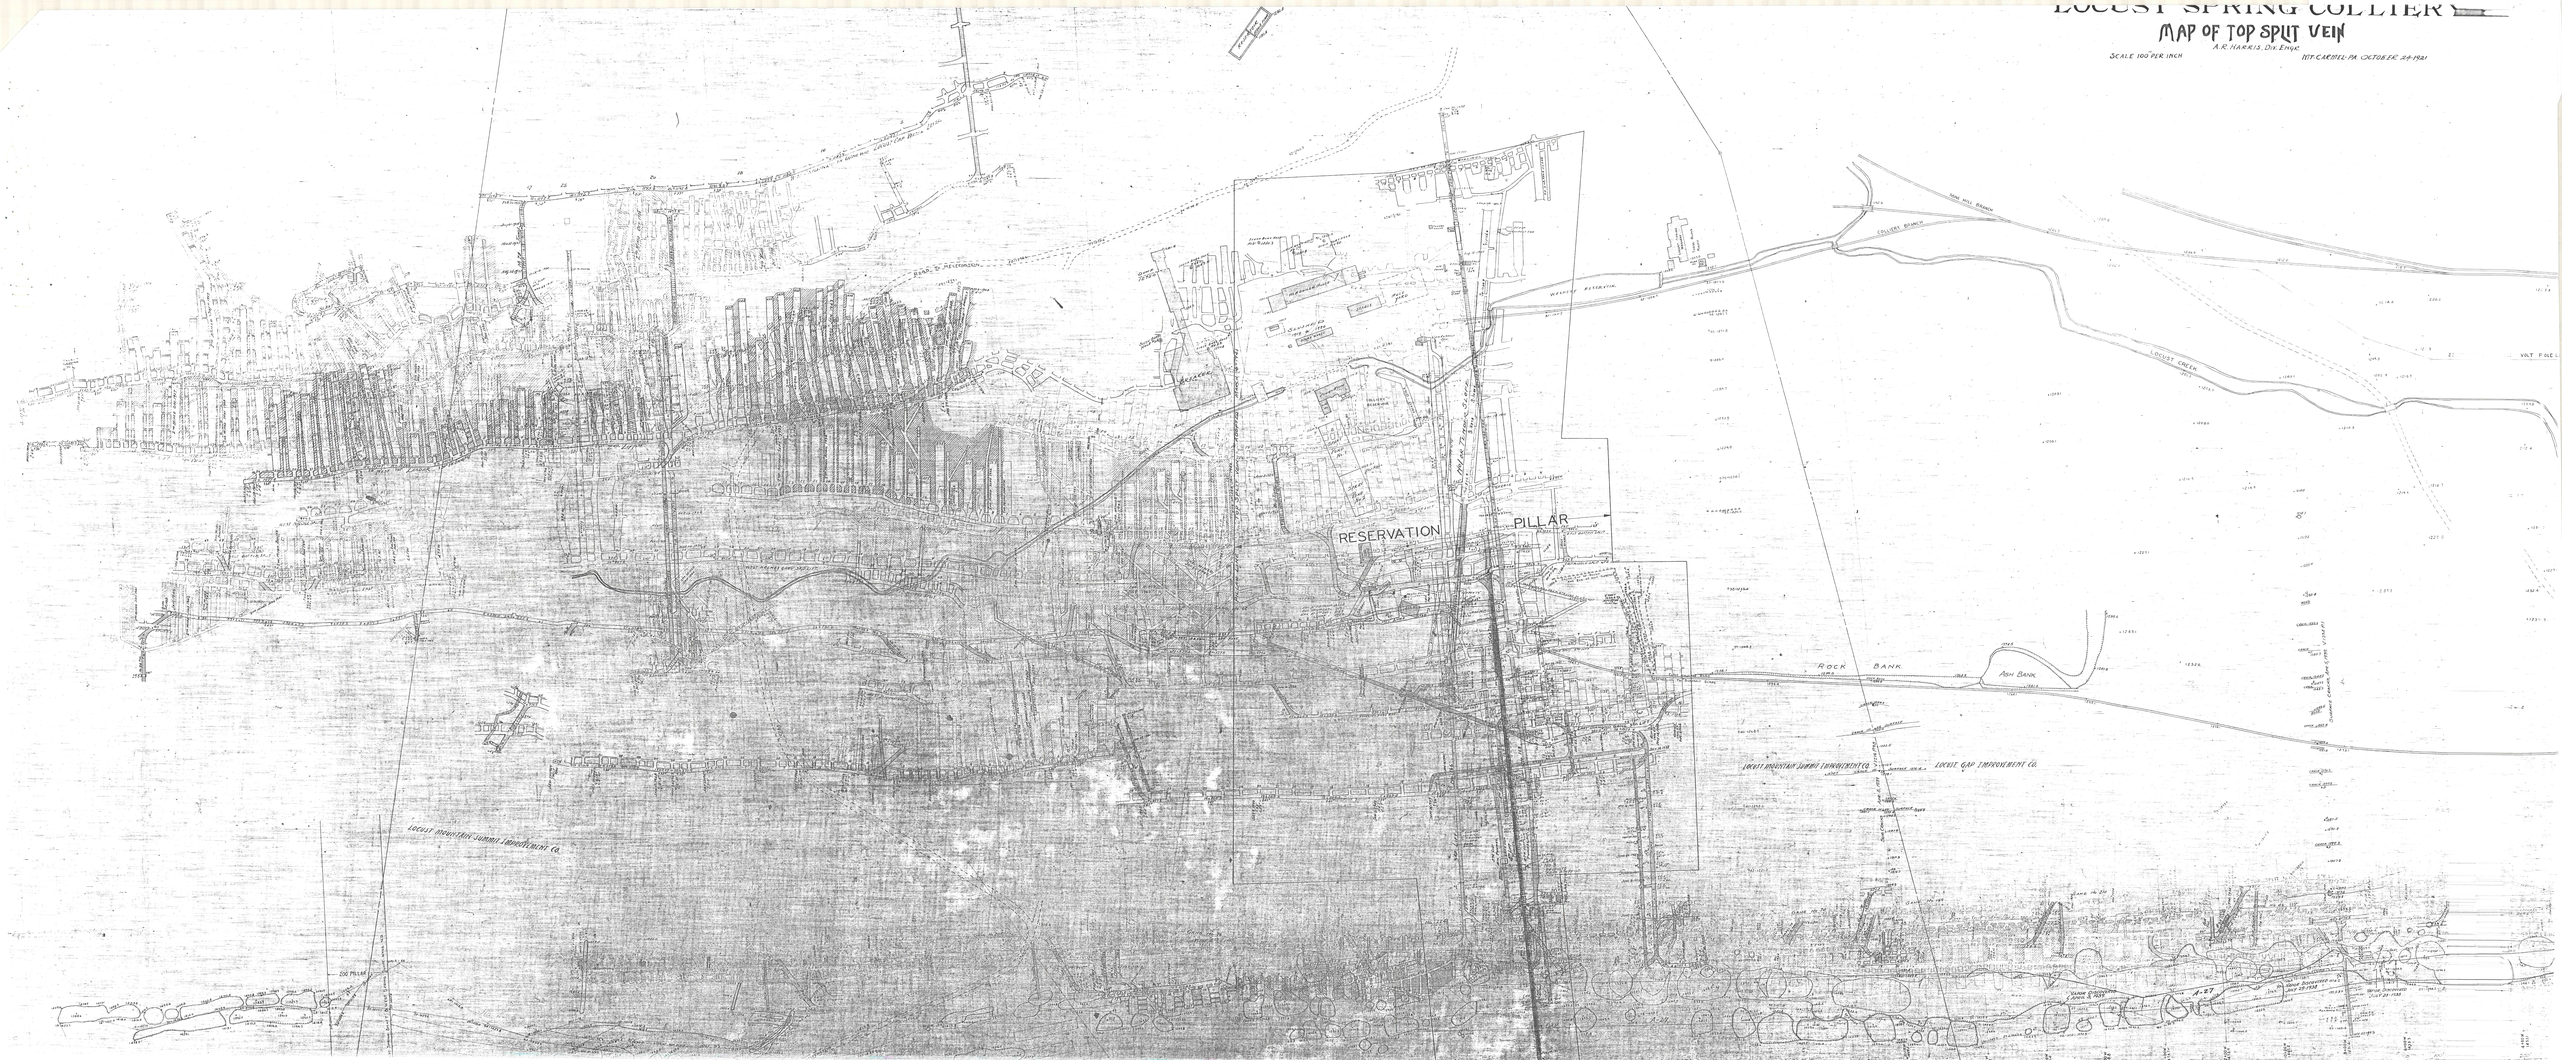
MT. CARMEL, PA. OCTOBER 24, 1931