


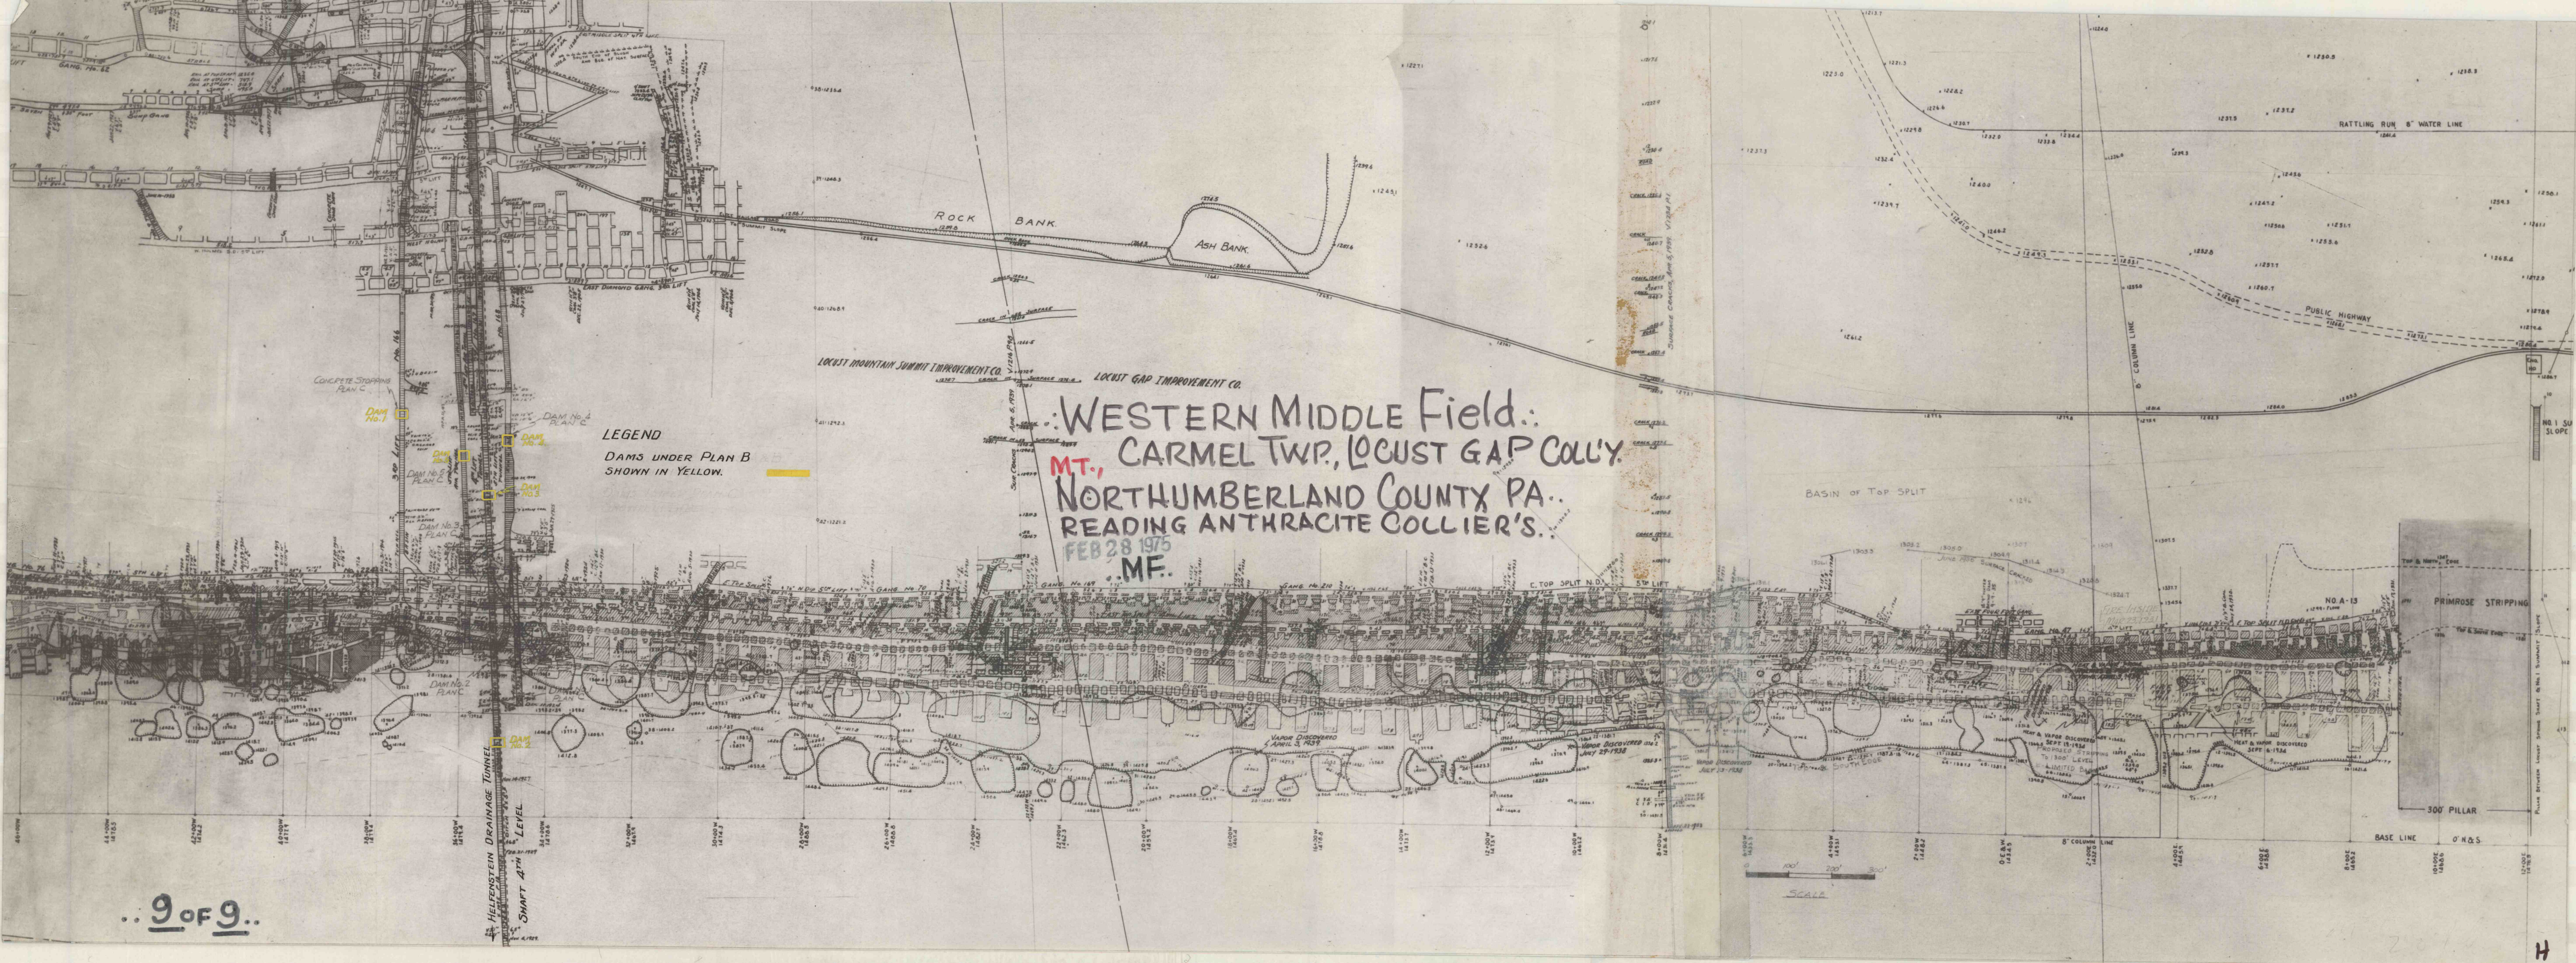

WESTERN MIDDLE Field:
MT., CARMEL TWP., LOCUST GAP COLLY.
NORTHUMBERLAND COUNTY PA.
READING ANTHRACITE COLLIER'S.
FEB 28 1975
.MF.

LEGEND
DAMS UNDER PLAN B
SHOWN IN YELLOW.