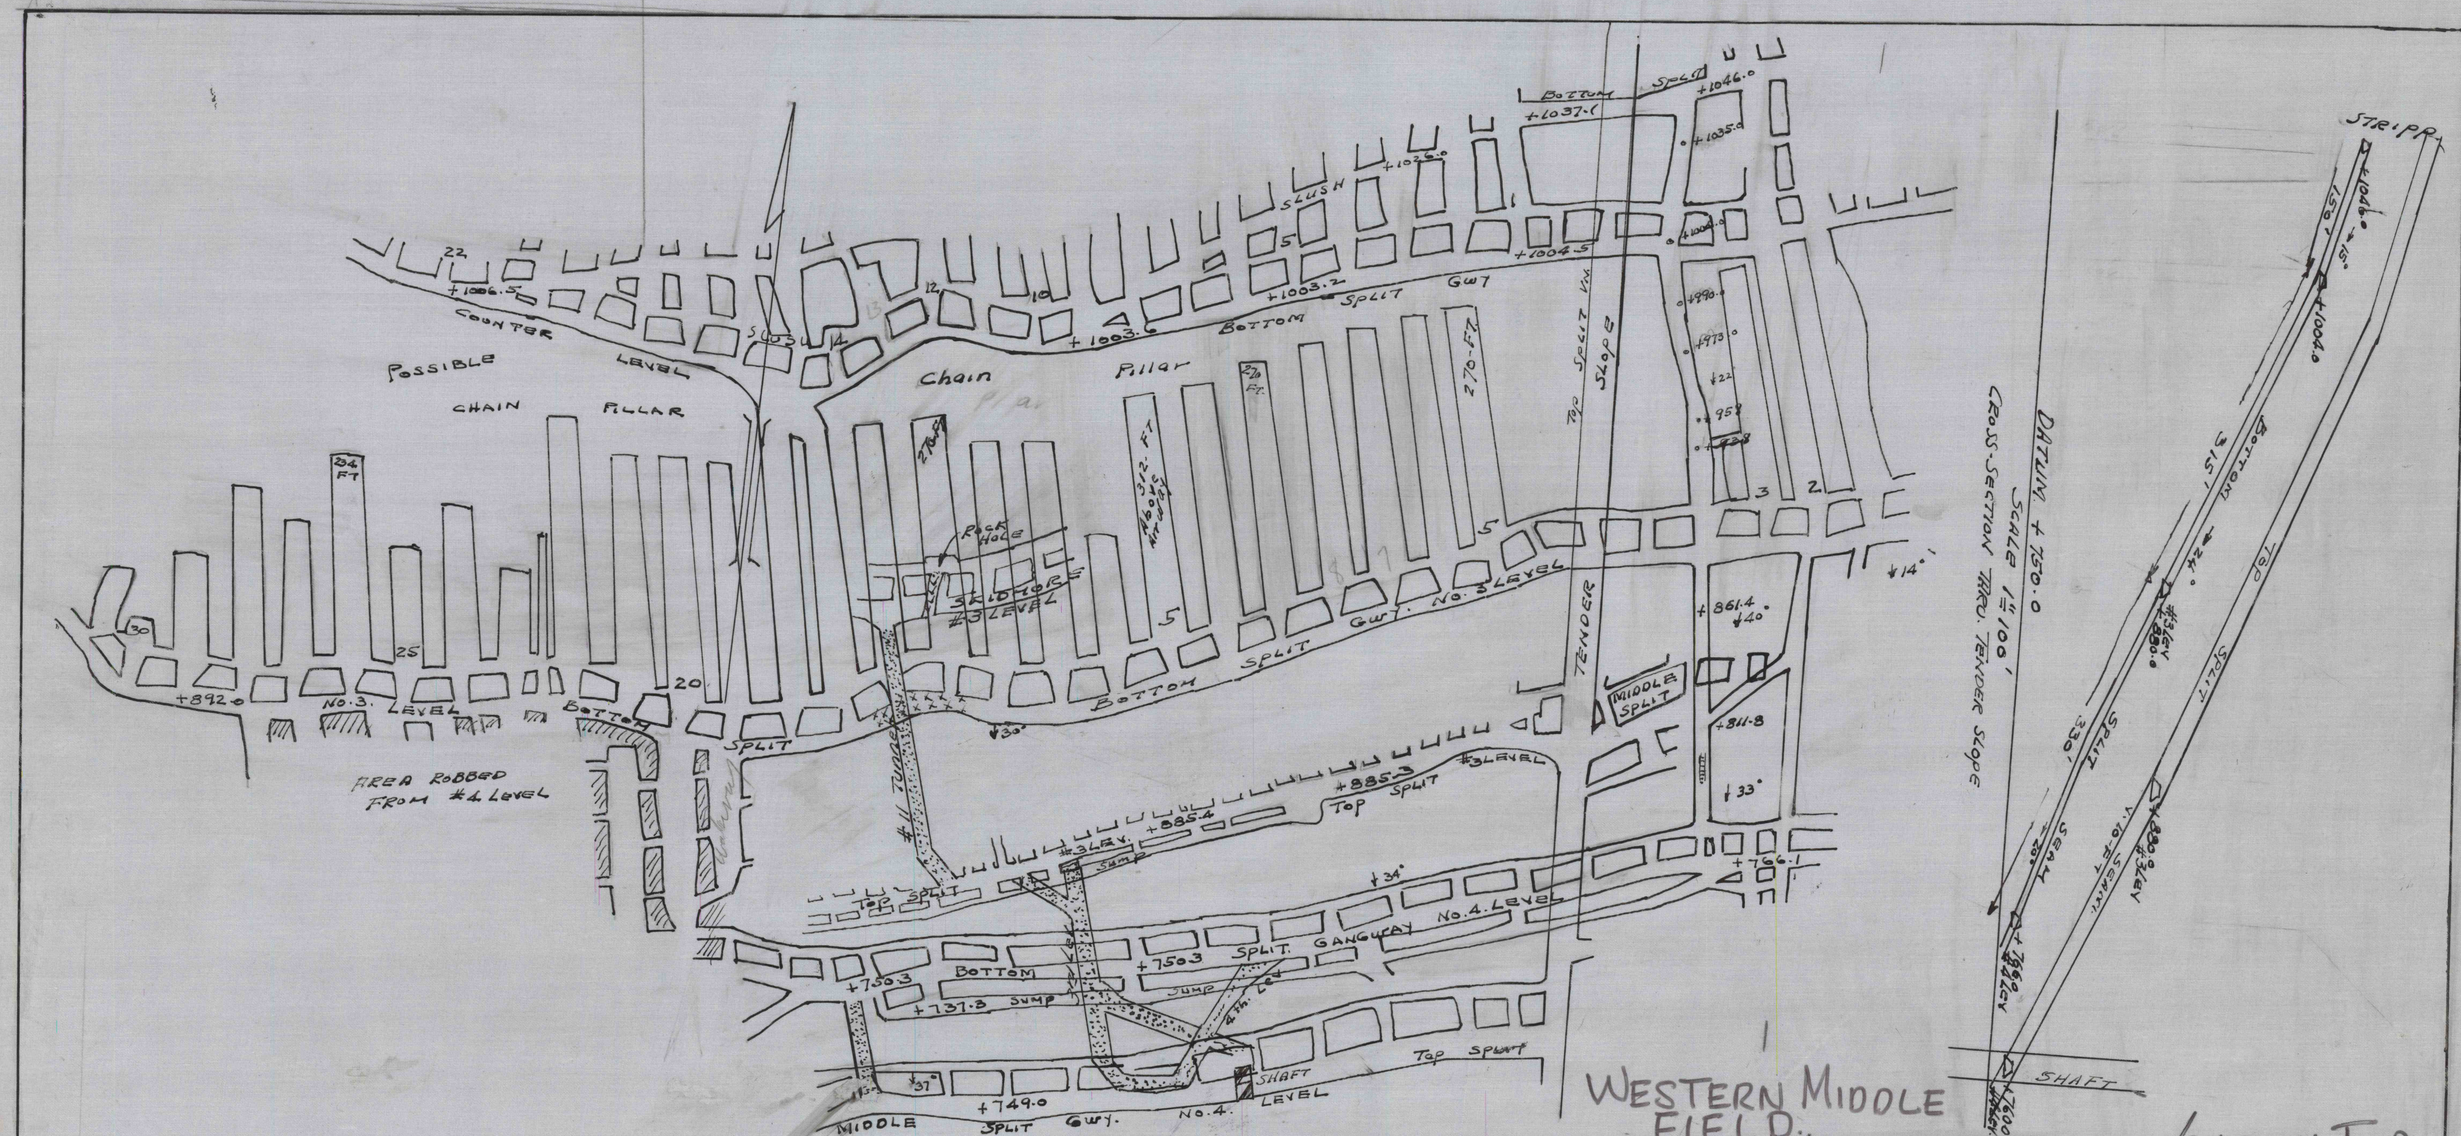

WESTERN MIDDLE FIELD.

BOTTOM SPLIT WORKINGS NEAR TENDER SLOPE LOCUST GAP COLLIERY, SCALE 1" = 100-FT.

CARMEL TWP., WEST MAHANOY DISTRICT. NORTHUMBERLAND COUNTY, PA.

FEB 28 1975 MF..

READING L-I-ANTHRACITE COAL'S