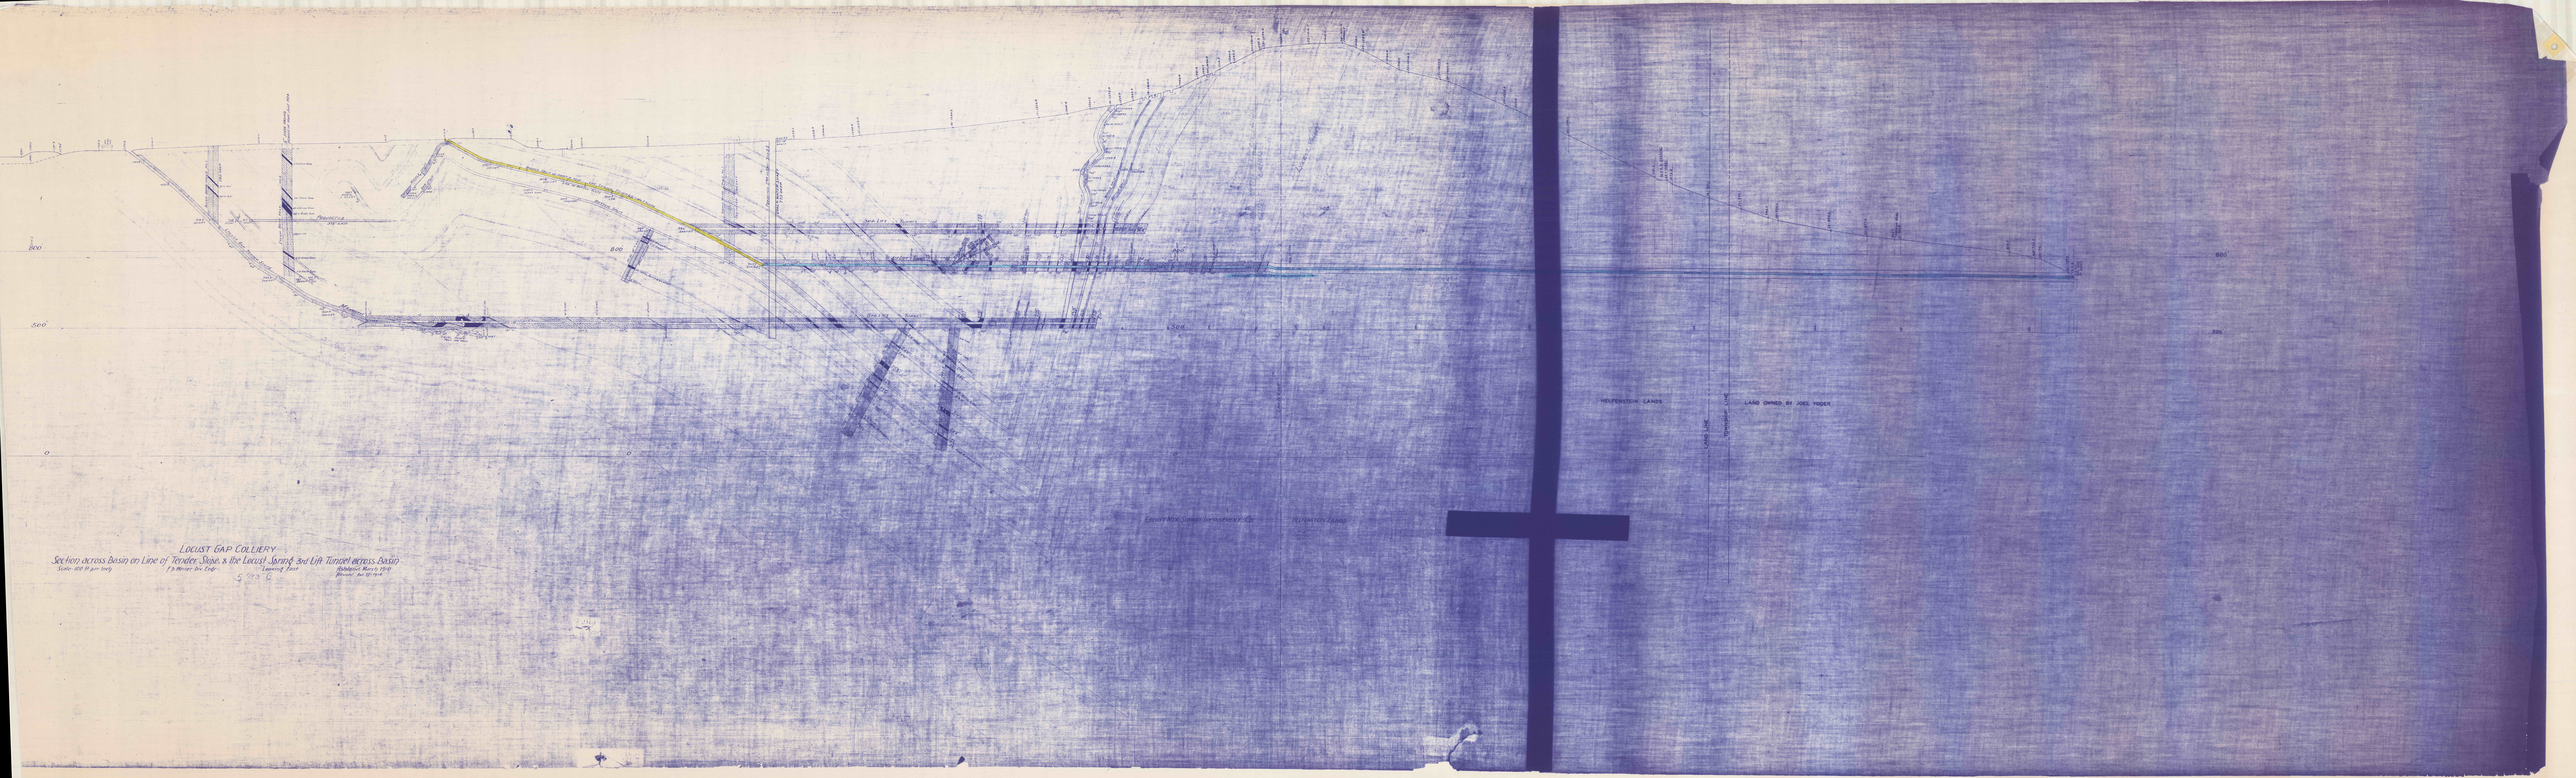

800
500
0
800
500
HESPERISTON LANDS
LAND OWNED BY JOEL YODER
LOCUST GAP COLLIERY
Section across Basin on Line of Tender Slope, & the Locust Spring 3rd Lift Tunnel across Basin
Scale: 100 ft. per Inch
P.B. Mercer, Civ. Engr.
January, 1908
Rehabilitated March, 1918
Revised, Jan 17, 1924