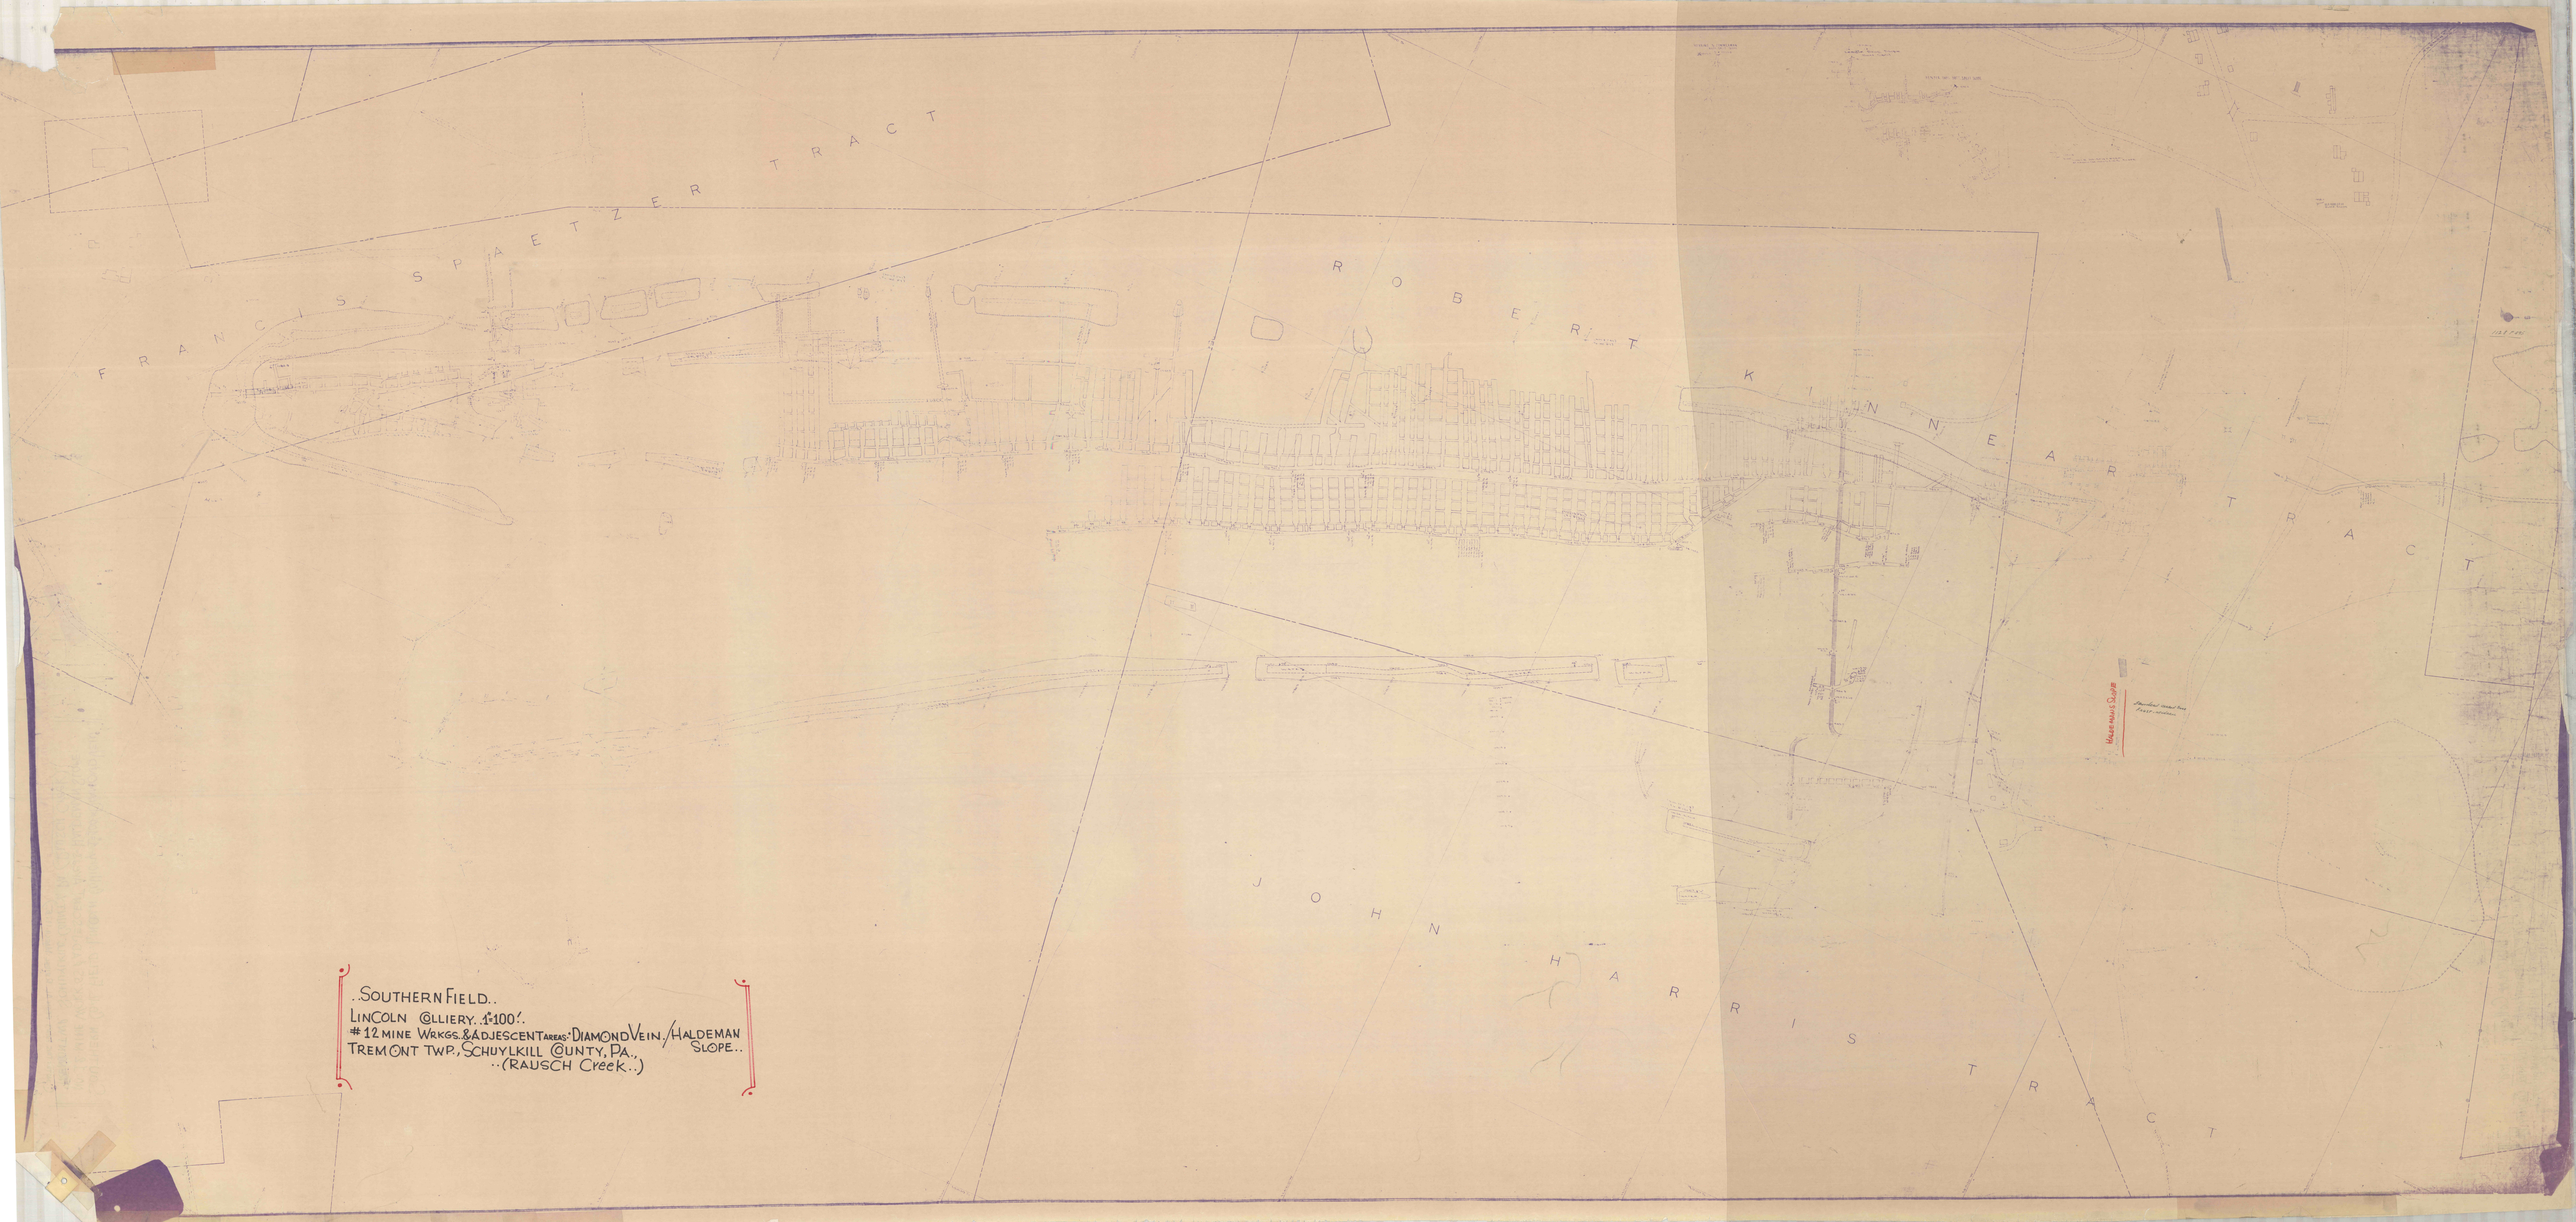
FRANCIS SPAETZER TRACT
ROBERT KINNEAR TRACT
JOHN HARRIS TRACT
HALDEMAN SLOPE
..SOUTHERN FIELD..
LINCOLN COLLIERY. 1"=100'.
#12 MINE WRKGS. & ADJESCENT AREAS: DIAMOND VEIN./HALDEMAN SLOPE..
TREMONT TWP., SCHUYLKILL COUNTY, PA.,
..(RAUSCH Creek..)