


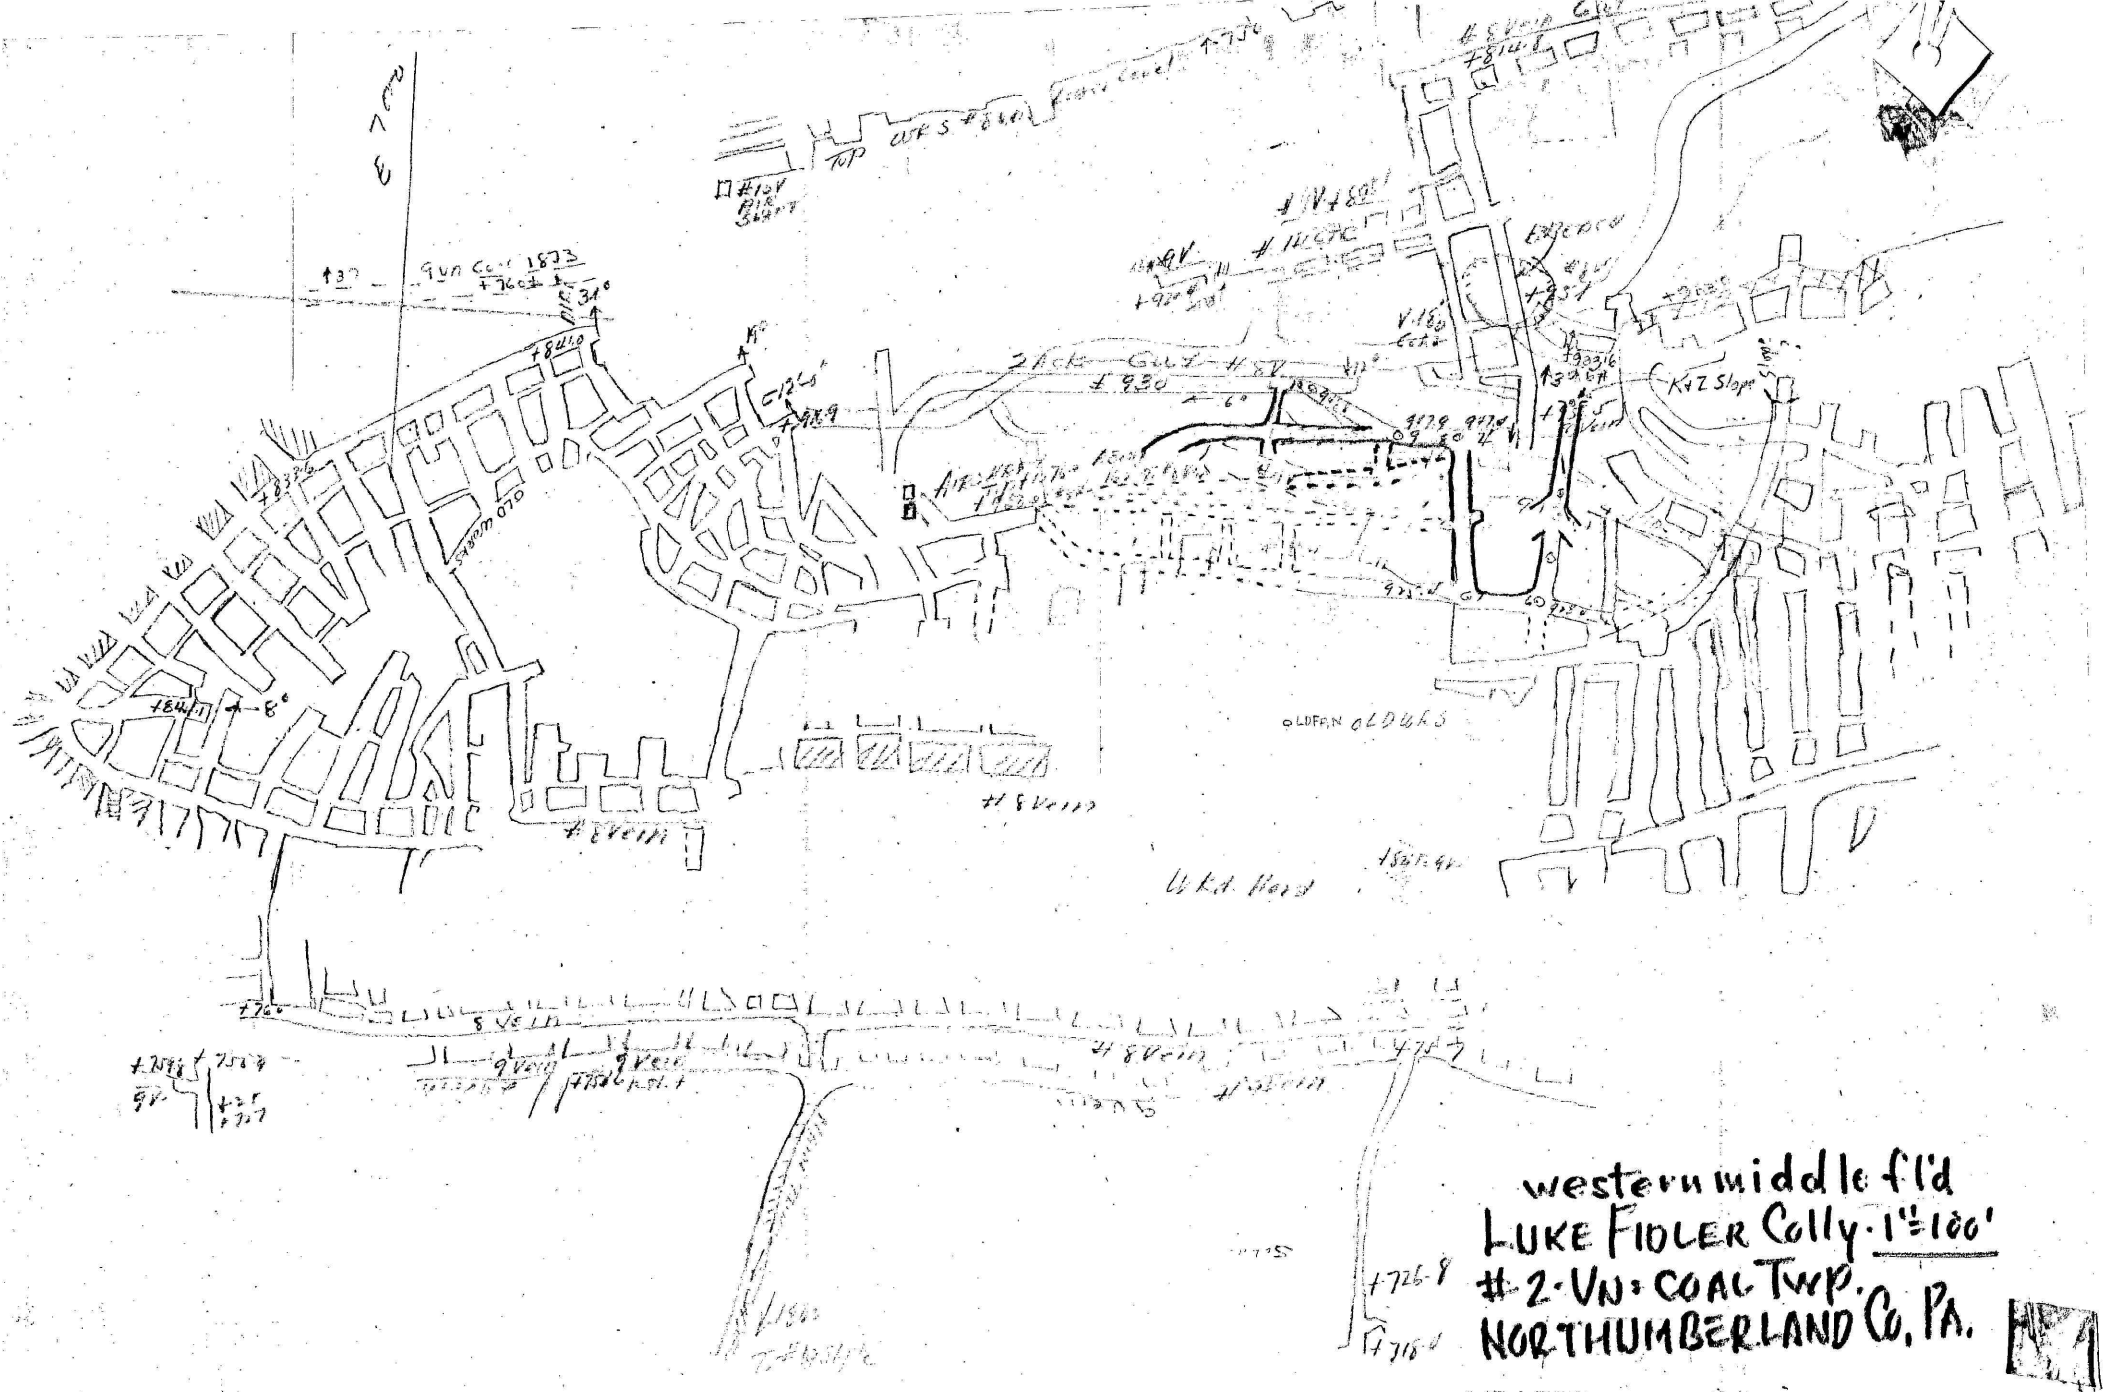

western middle fld
LUKE FIDLER Coll. 1"=100'
#2-VN: COAL Twp.
NORTHUMBERLAND Co. PA.