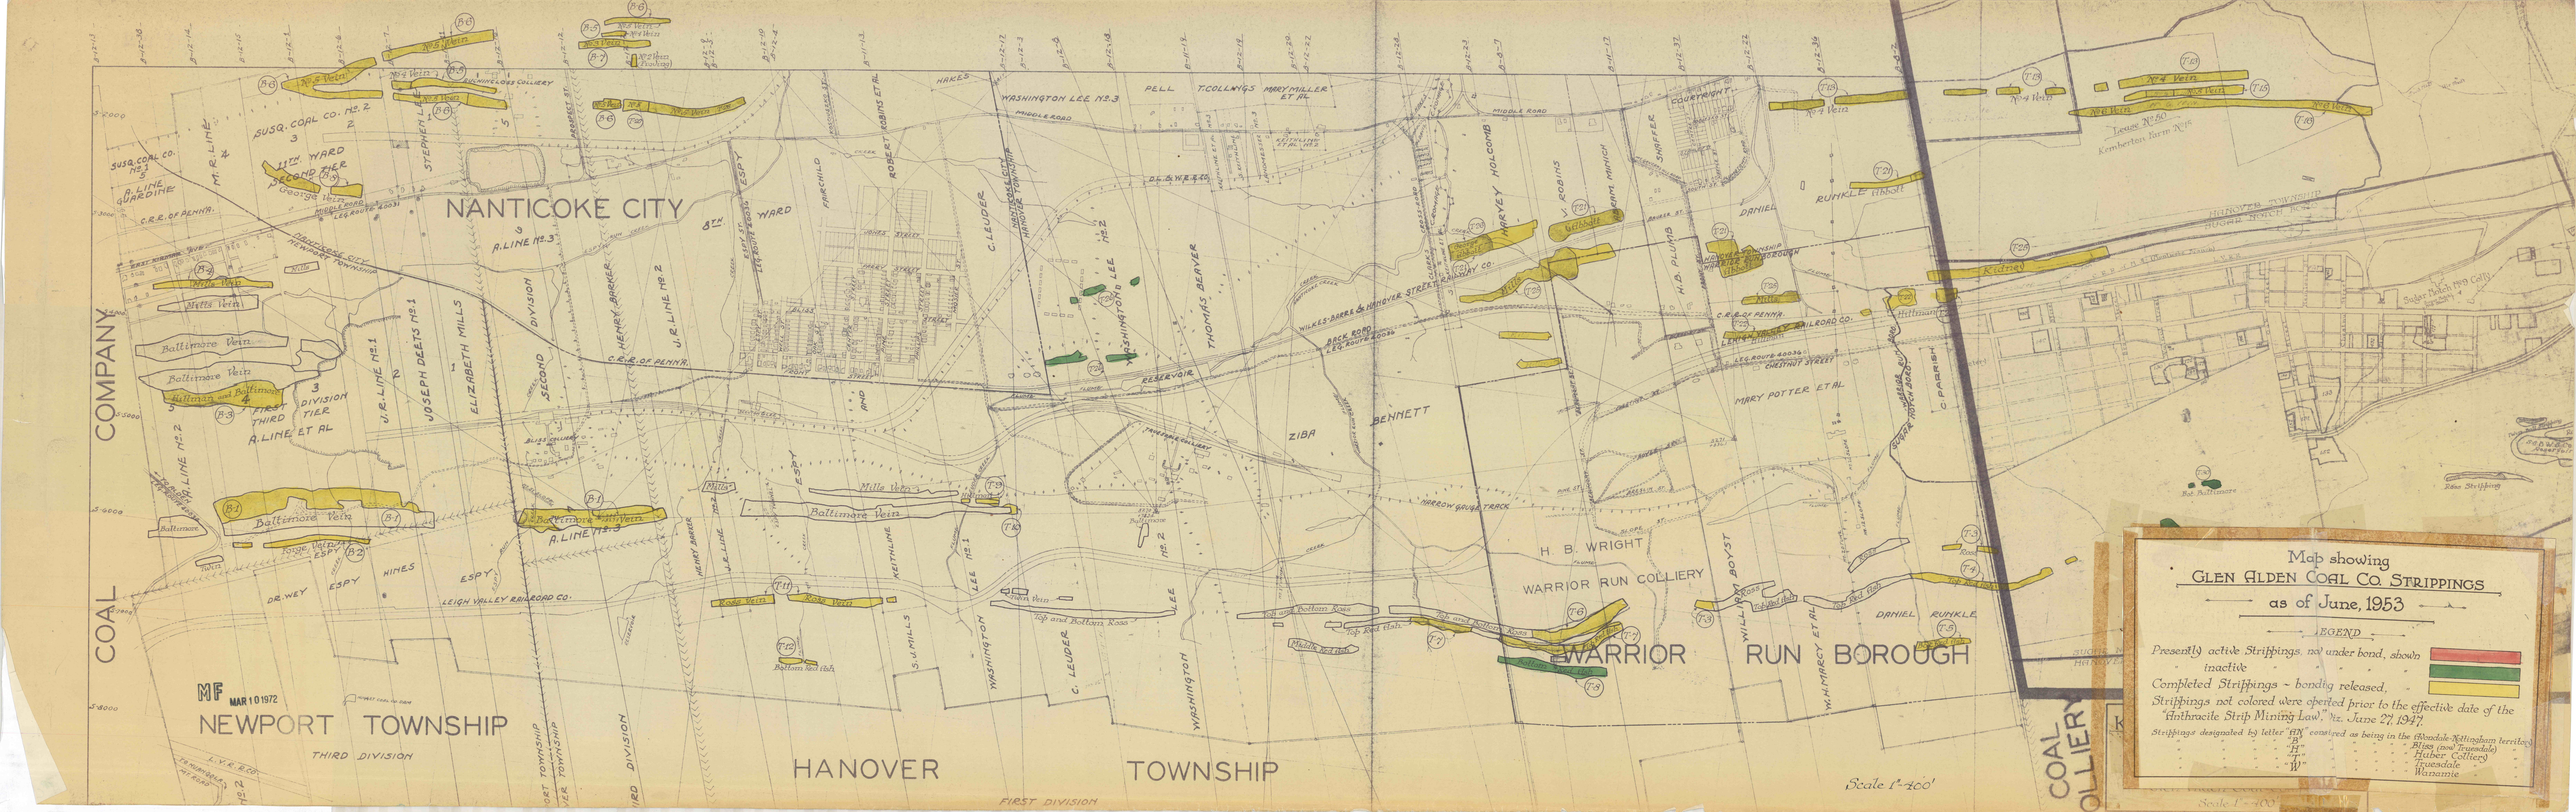
NANTICOKE CITY
NEWPORT TOWNSHIP
THIRD DIVISION
HANOVER TOWNSHIP
FIRST DIVISION
WARRIOR RUN BOROUGH
COAL COMPANY
Map showing
GLEN ALDEN COAL CO STRIPPINGS
as of June, 1953
LEGEND
Presently active Strippings, not under bond, shown
inactive
Completed Strippings - bonding released,
Strippings not colored were operted prior to the effective date of the
"Anthracite Strip Mining Law", viz. June 27, 1947
"B" Bliss (now Truesdale)
"H" Huber Colliers)
"T" Truesdale
"W" Waramie
Scale 1"=400'
MF MAR 10 1972