


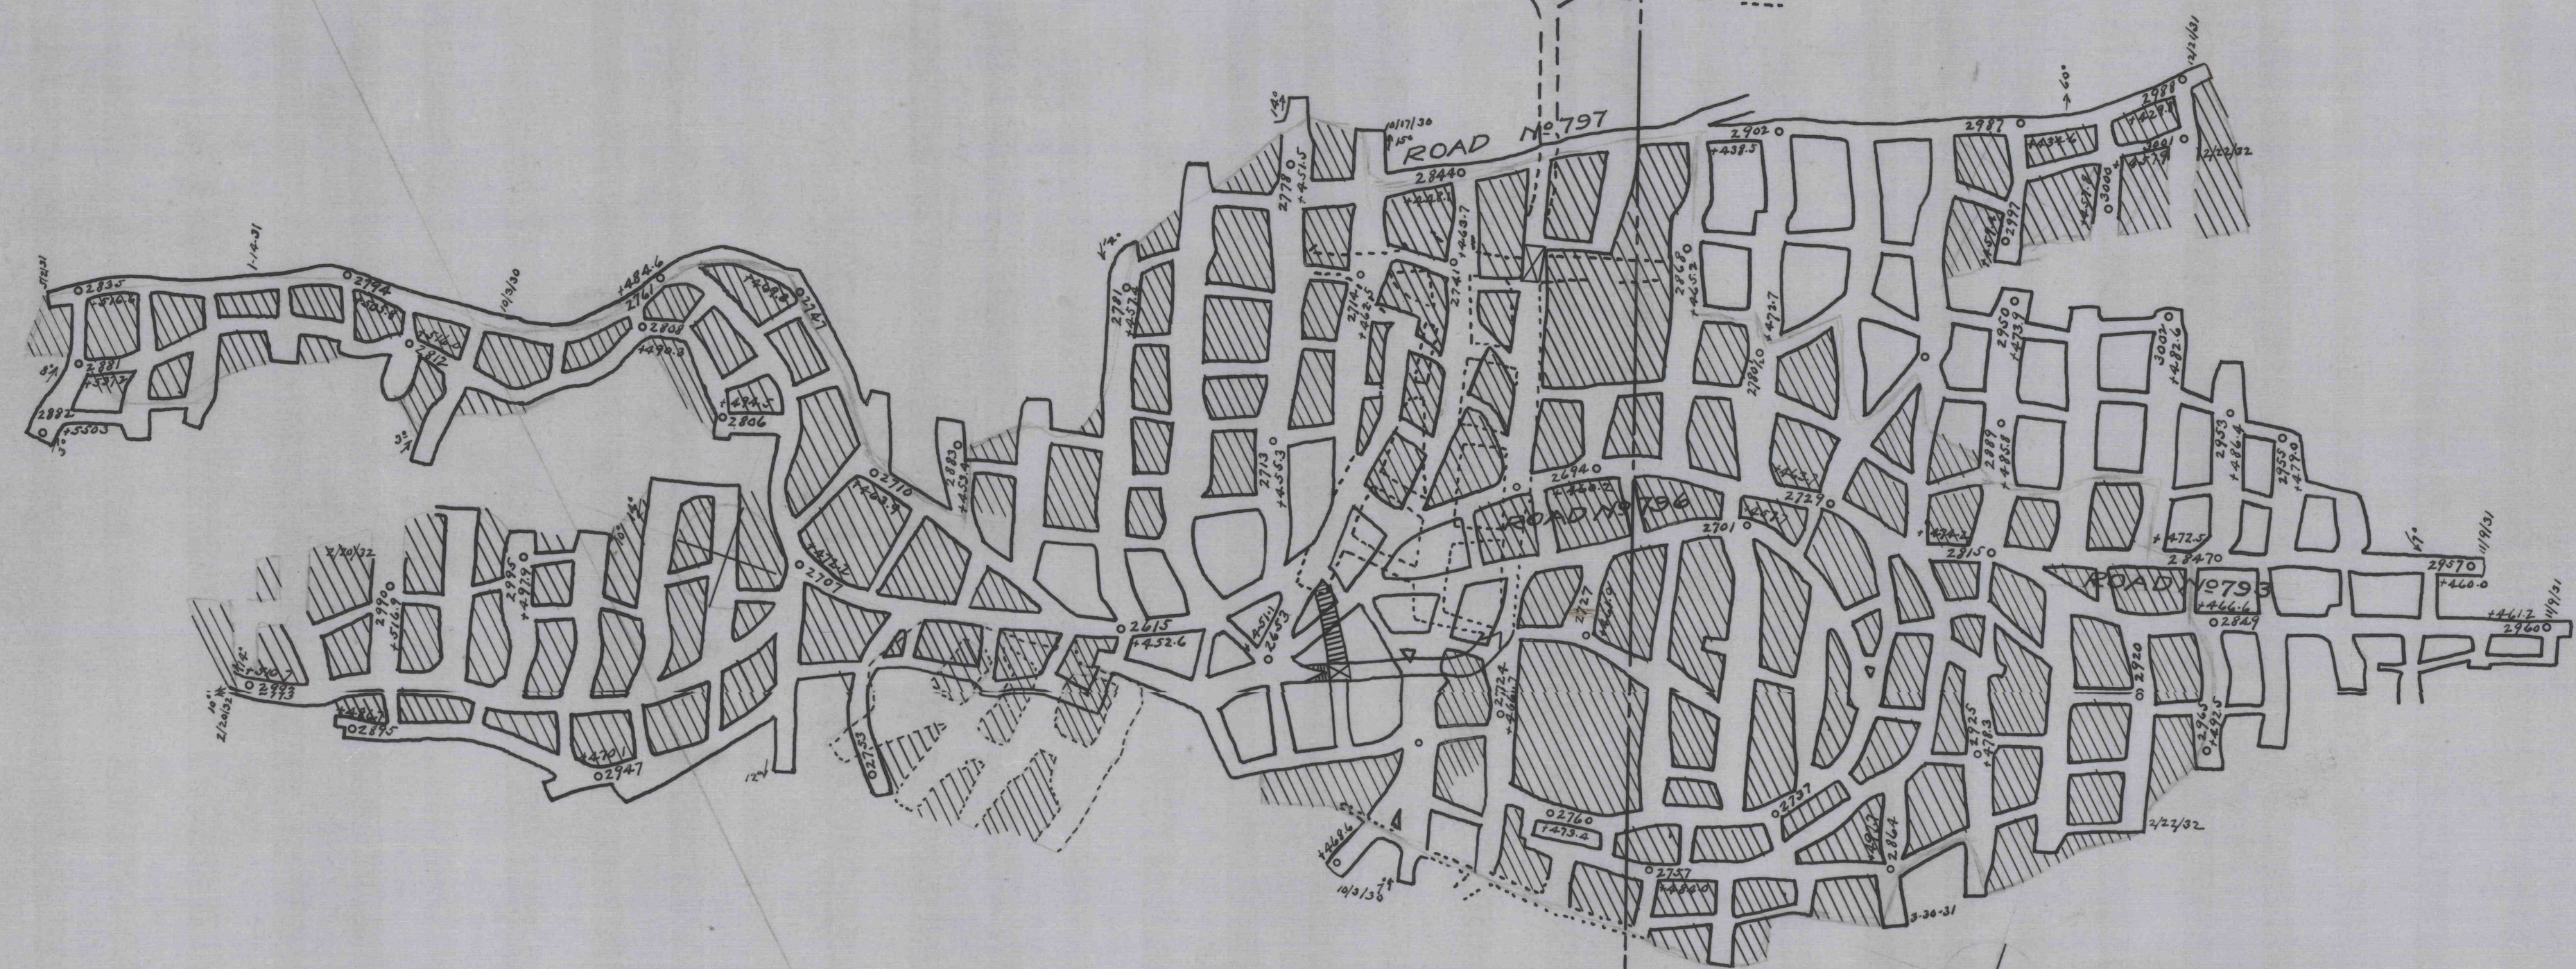

CHARLES GARRINGER

L. D. SHOENAKER NO. 1

10000'

10000'

3. LOOMIS COALIER 5 VEIN OVERLAP
HANOVER TWP. LUZERNE COUNTY, NANTICOK, PA.
EXTENDED: April, 1940 - B
- 1941 to 1943
- 1943 to 1944
- 1944 to 1947
Dec. 1943