


LOOMIS - BALTIMORE VEIN

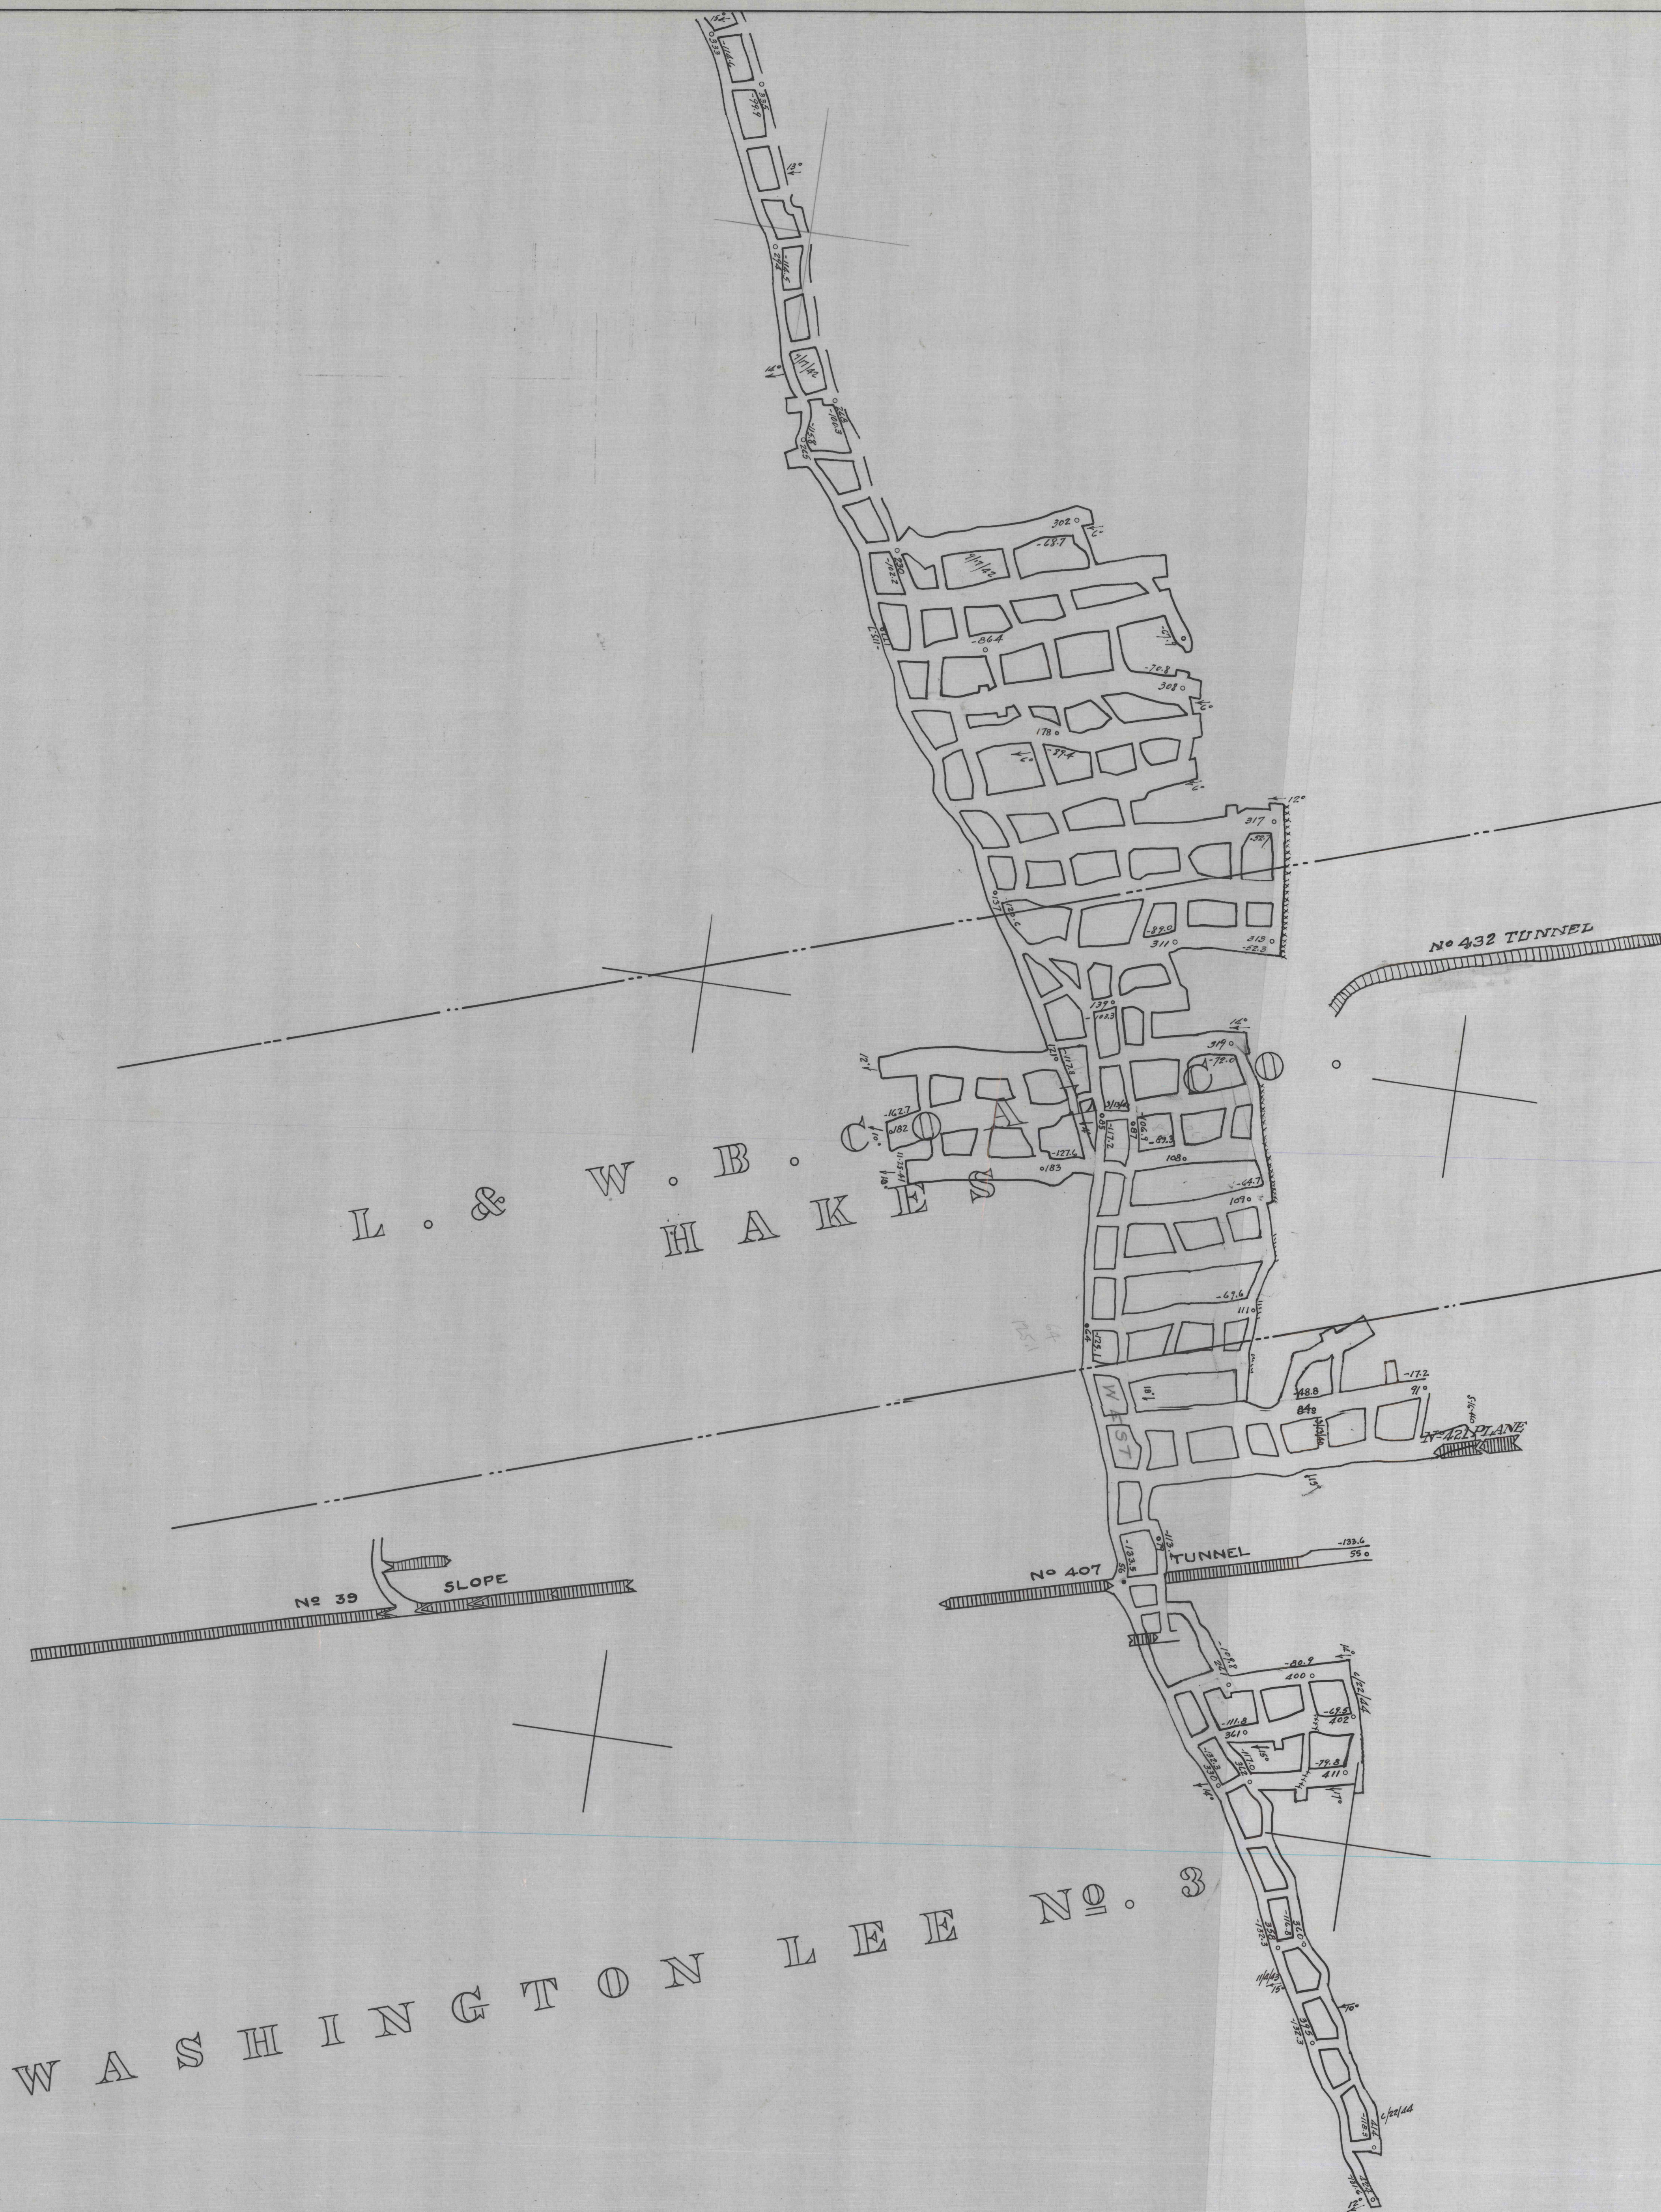

...NORTHERN COAL FIELD...
Loomis Colliery, Baltimore Vein, 1st 100'.
Hanover Twp., Luzerne County,
Nanticoke Pa., Glen Alden Coal Co.,

JAN 9 1975 MF 23 OF 26

EXTENDED	EXTENDED
April, 1940 - 28'	
January, 20, 1942	
June 1943 576'	
May, 1944 - 1945 576'	
Dec. 27, 1945 - 28'	
Feb. 6, 1947 R.	
Sept. 2, 1947 R.	
Oct. 3, 1950 - 576'	
DEC 15, 1953 28'	
Dec 15, 1954	
Checked Jan 1957	
Oct 2 1957	

Checked Oct 2, 1957 GMB

MF
JAN 9 1975