No. 11

LOOMIS RED ASH

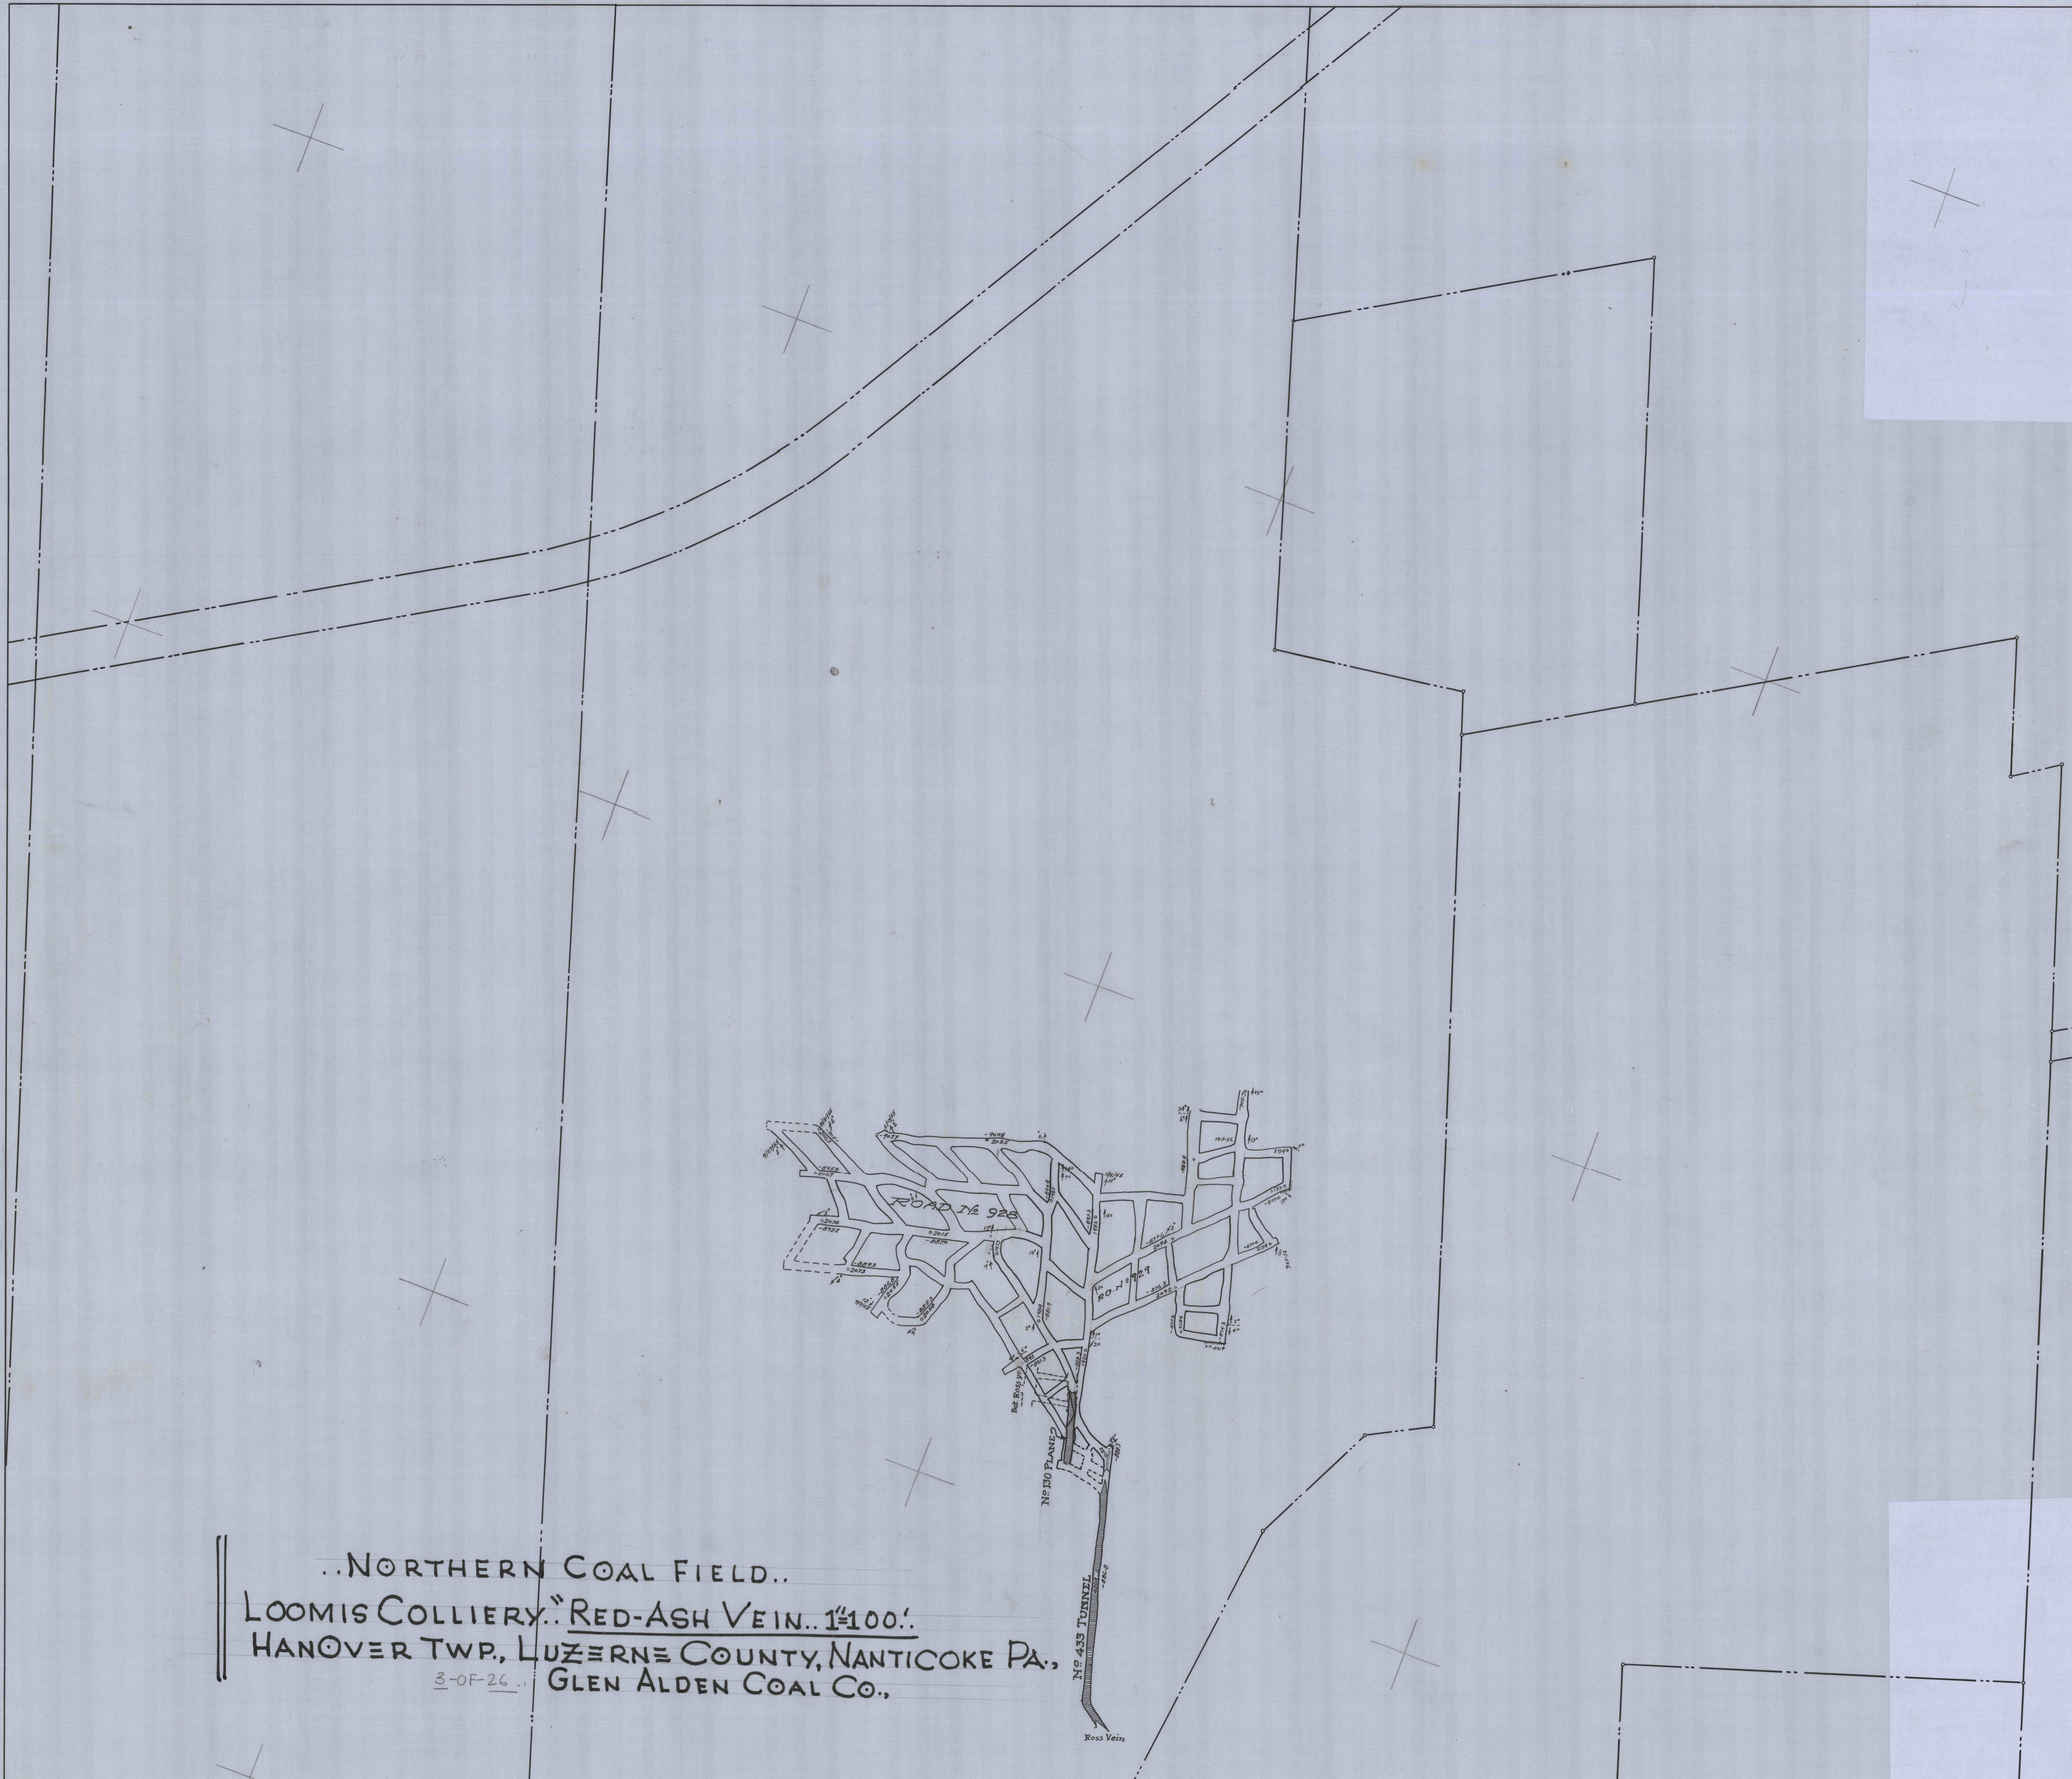
ROAD No 928
RD. No 929
No 130 PLANE
No 433 TUNNEL
Ross Vein
Bat. Ross vn
vn out
9/27/55
8/31/55
1/7/55
1/9/55
12-5-56
-905.1
2023
-907.9
-907.8
2035
-895.8
2069
2074
-892.2
-889.3
2073
2015
-887.0
-886.8
2055
-885.3
2054
1473
-894.8
1985
-891.3
1982
-888.8
-905.7
2174
2133
-877.0
-877.6
2094
-877.0
2134
-876.3
2092
-877.2
2186
-874.3
1984
-881.9
1895
-891.3
-883.3
1920
-885
-886.8
725-56

..NORTHERN COAL FIELD..

LOOMIS COLLIERY.."RED-ASH VEIN.. 1"=100'.

HANOVER TWP., LUZERNE COUNTY, NANTICOKE PA.,

3-OF-26.. GLEN ALDEN COAL CO.,

Extended Jan. 6-1956
Jan 9-1957 G.B.
Oct 1 1957 G.B.

JAN 9 1975
MF

No. 11

LOOMIS RED ASH

No. 11

LOOMIS RED ASH

No. 11