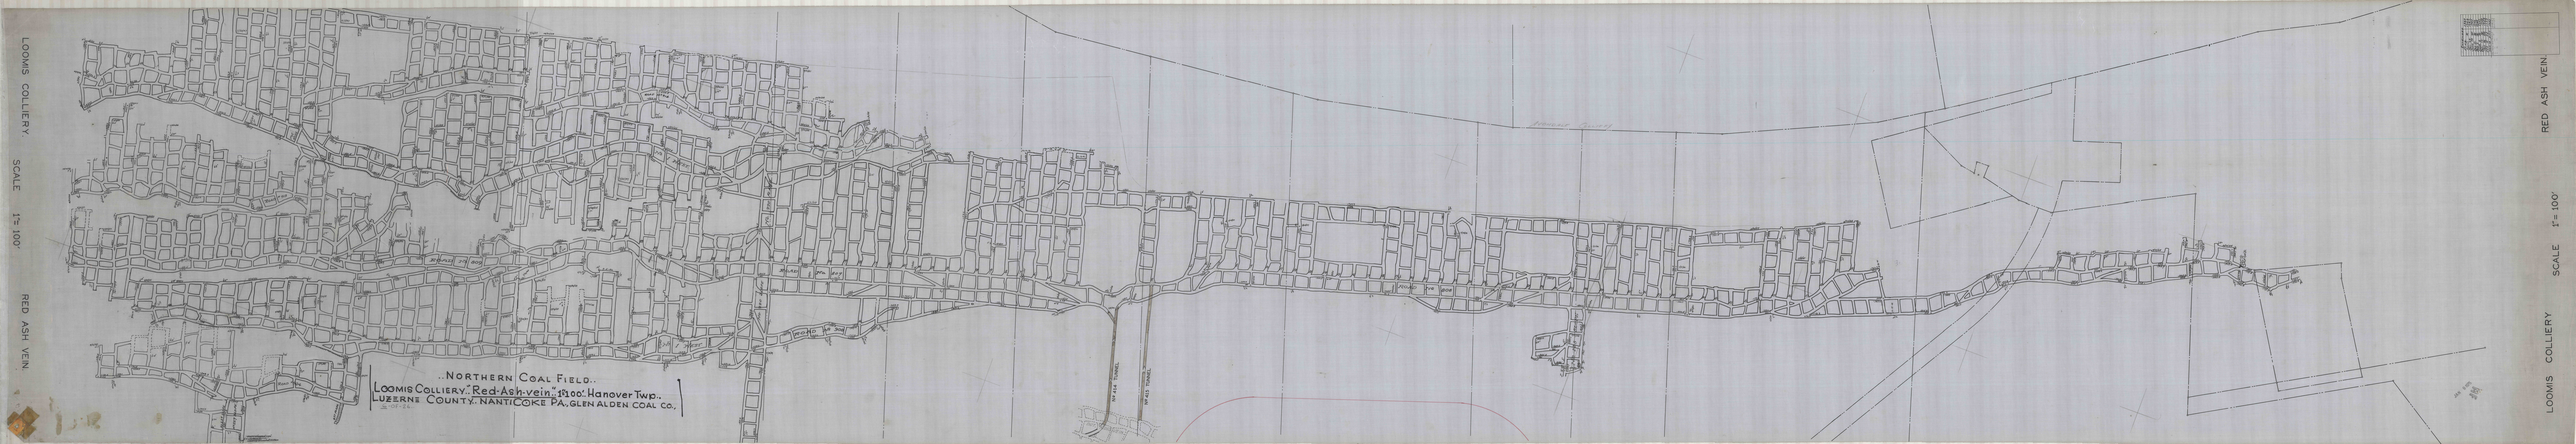
LOOMS COLLIERY SCALE 1"= 100' RED ASH VEIN
..NORTHERN COAL FIELD..
LOOMIS COLLIERY "RED ASH VEIN" 1"=100' HANOVER TWP.,
LUZERNE COUNTY, NANTICOKE PA. GLEN ALDEN COAL CO.
MAIN TUNNEL
MAIN TUNNEL
LOOMS COLLIERY SCALE 1"= 100' RED ASH VEIN