


7+83

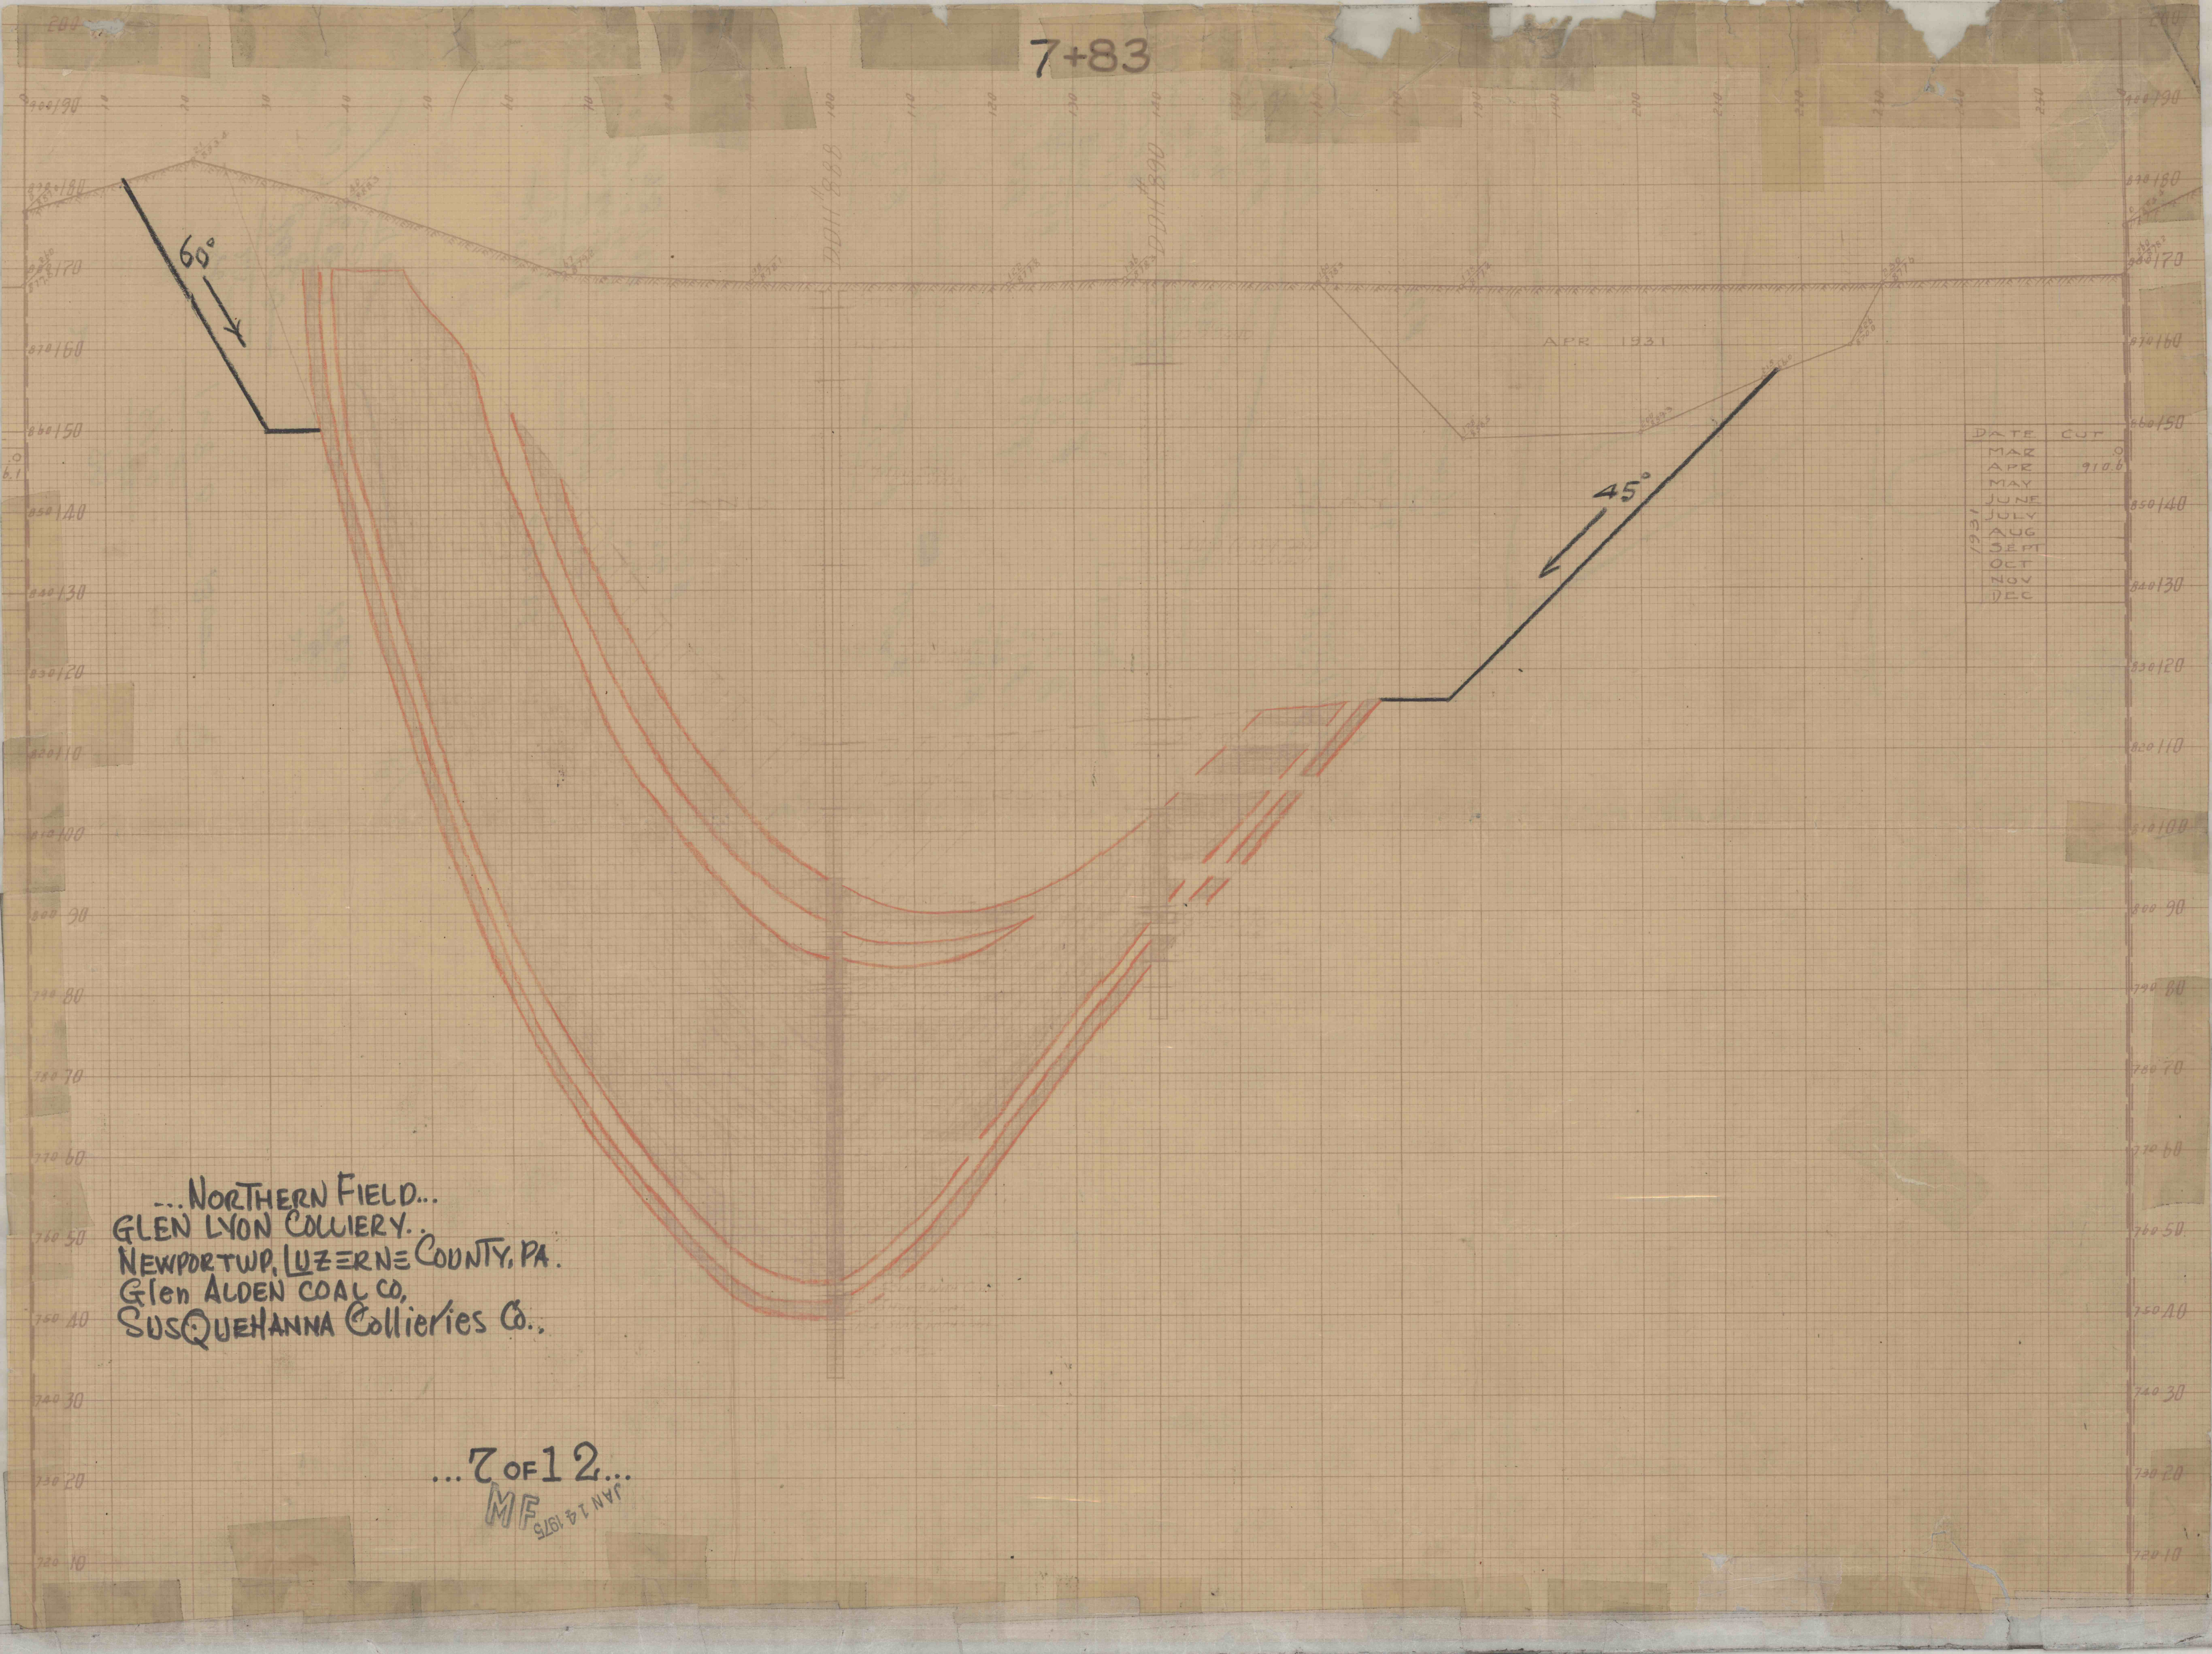

APR 1931

DATE	CUT
MAR	0
APR	910.6
MAY	
JUNE	
JULY	850.40
AUG	
SEPT	
OCT	
NOV	840.30
DEC	

...NORTHERN FIELD..
GLEN LYON COLLIERY..
NEWPORT TWP., LUZERNE COUNTY, PA..
Glen ALDEN COAL CO..
SUSQUEHANNA Collieries Co..

...7 of 12...
MF
JAN 24 1935