


20+52

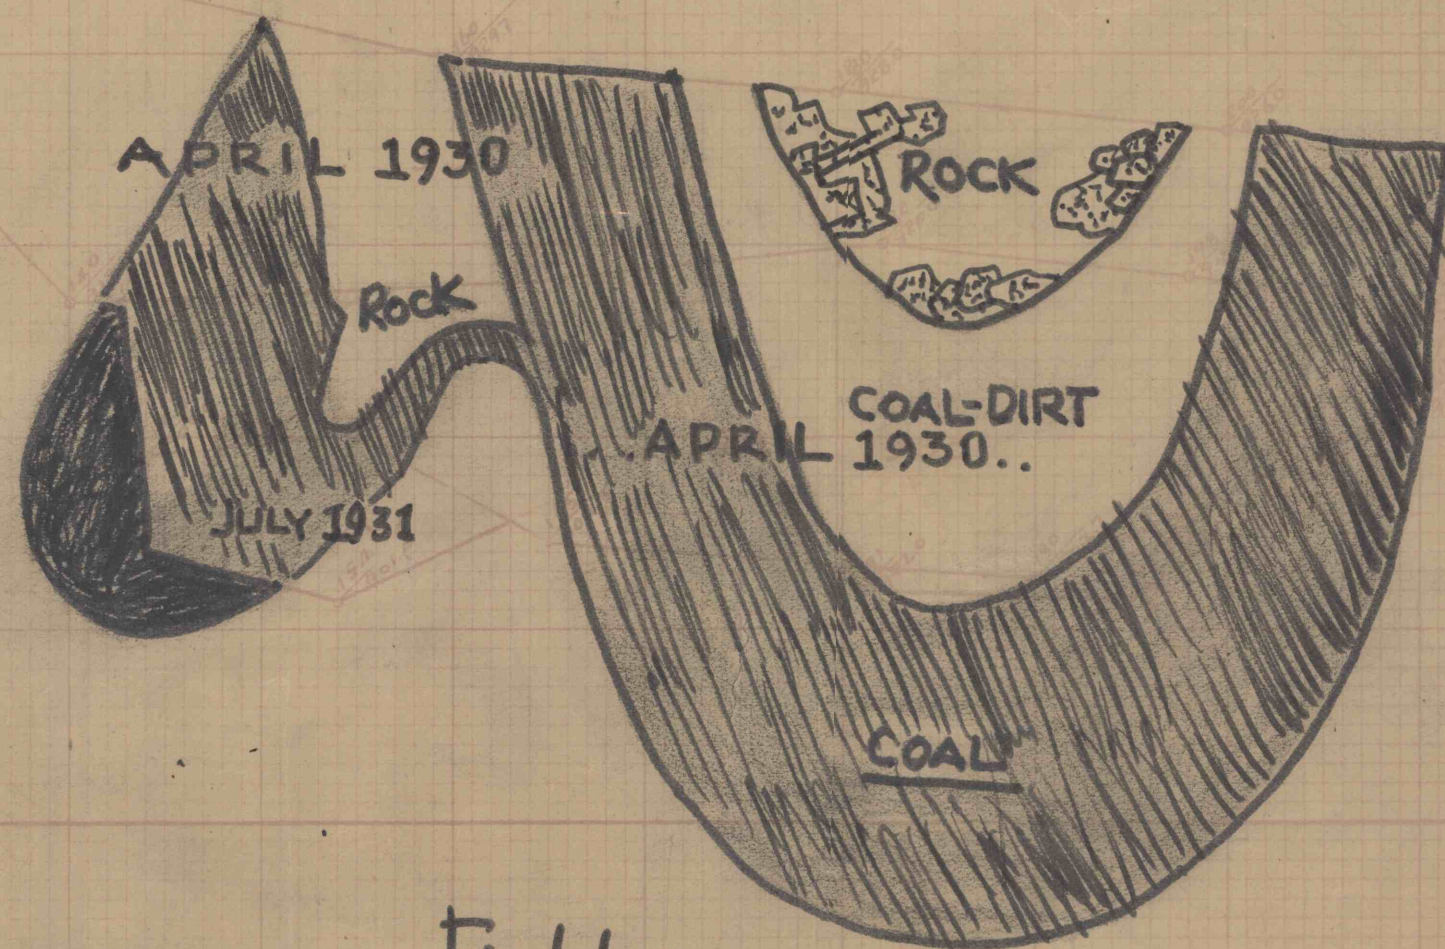

...NORTHERN Field...
GLEN LYON COLLIERY..
NEWPORT TWP. JUZERNE Co, PA.
WYOMING DIVISION.. GLEN ALDEN COAL Co..
SUSQUEHANNA Collieries Co..
GLEN LYON, PA.

JAN 14 1975

MF

6(A) OF 13