


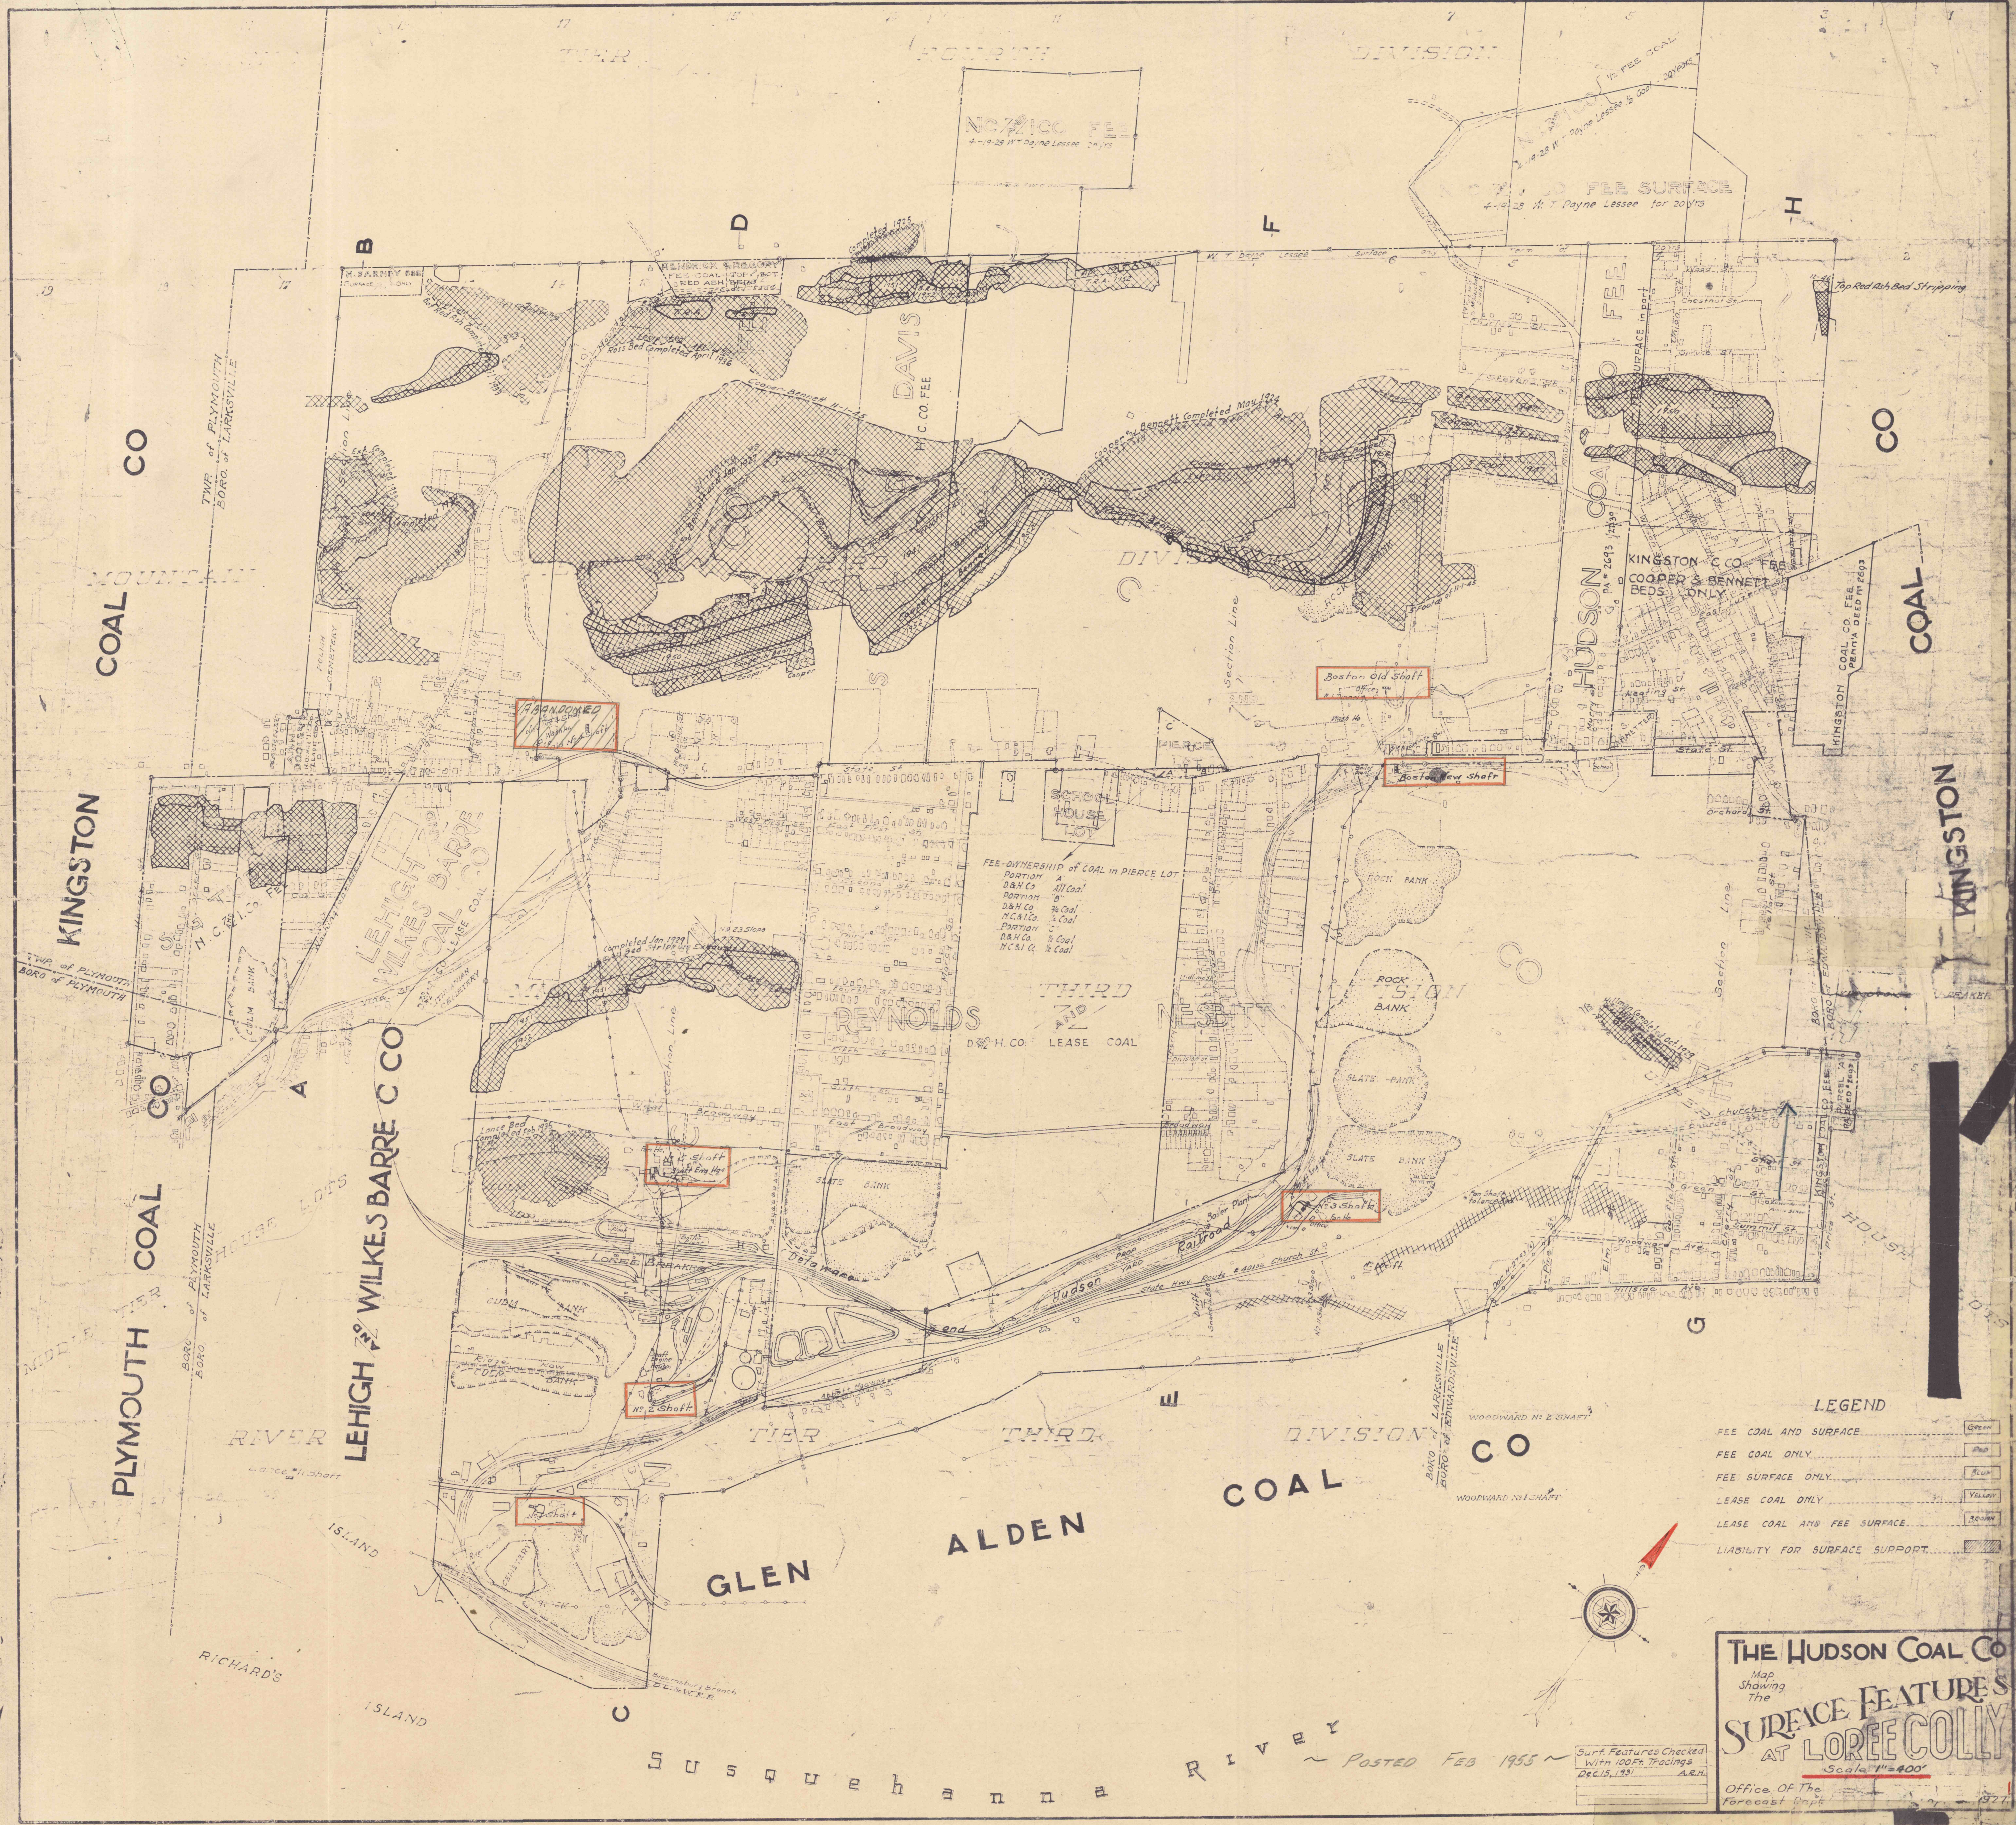

LEGEND

FEE COAL AND SURFACE	Green
FEE COAL ONLY	Blue
FEE SURFACE ONLY	Yellow
LEASE COAL ONLY	Orange
LEASE COAL AND FEE SURFACE	Red
LIABILITY FOR SURFACE SUPPORT	Diagonal Lines

THE HUDSON COAL CO.
Map Showing The
SURFACE FEATURES
AT LOREE COLLY
Scale 1"=400'
Office of The
Forecast Dept.

Surf. Features Checked
With 100 Ft. Readings
Dec. 15, 1931 A.M.

POSTED FEB 1955