


Date of Last Survey Posted	
No. 3 Shaft	
First Mining	
1st Mining	

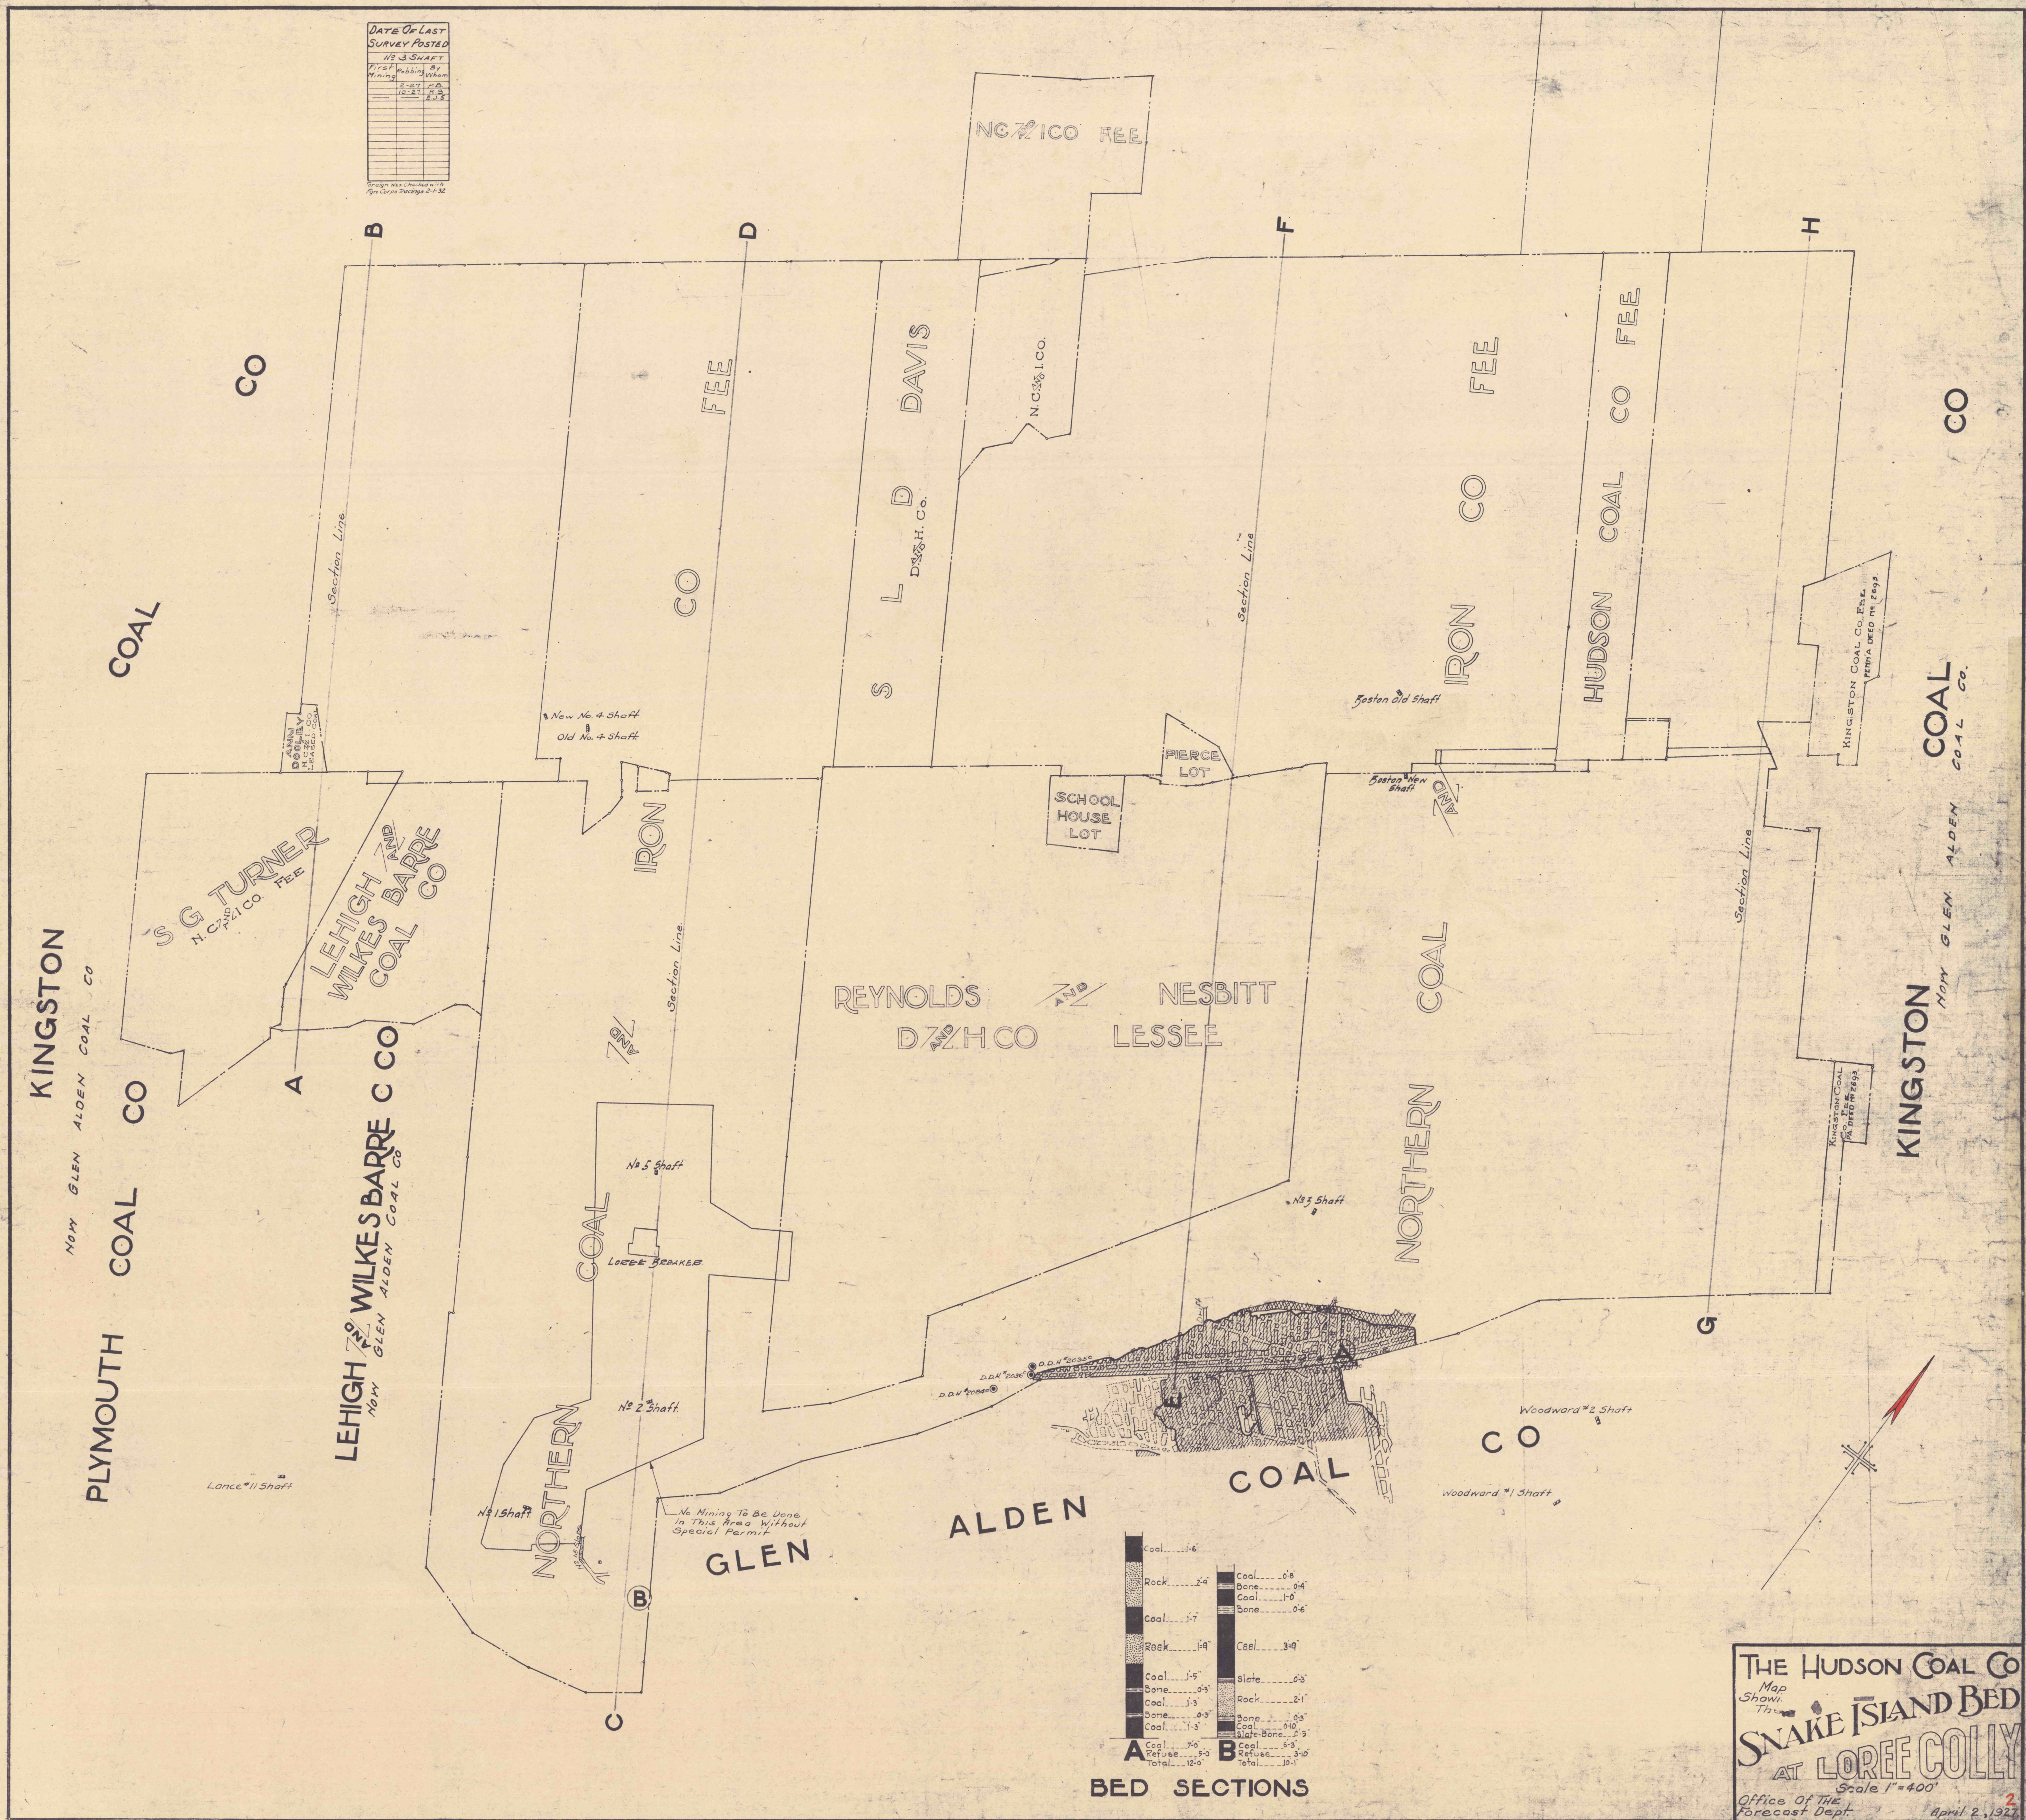

THE HUDSON COAL CO
Map
Snake Island Bed
AT LOREE COLLY
Scale 1"=400'
Office of the
Forecast Dept.
April 2, 1927