


DATE OF LAST SURVEY POSTED	
No. 2 Shaft	
By	
When	
By	
When	
By	
When	
By	
When	
By	
When	
By	
When	

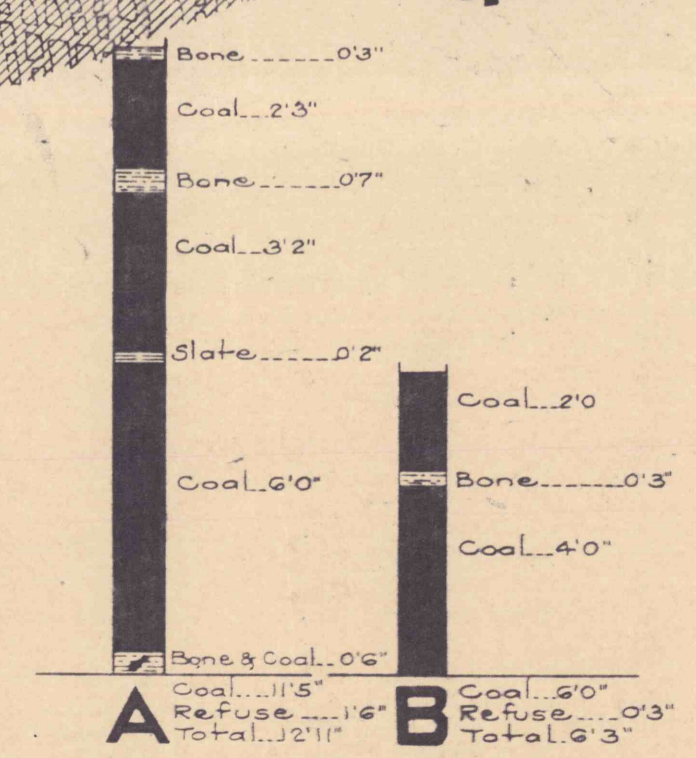

THE HUDSON COAL CO
 Map Showing The
ABBOTT BED
 AT LOREE COLLY
 Scale 1"=400'
 Office of The Forecast Dept.
 April 2, 1927