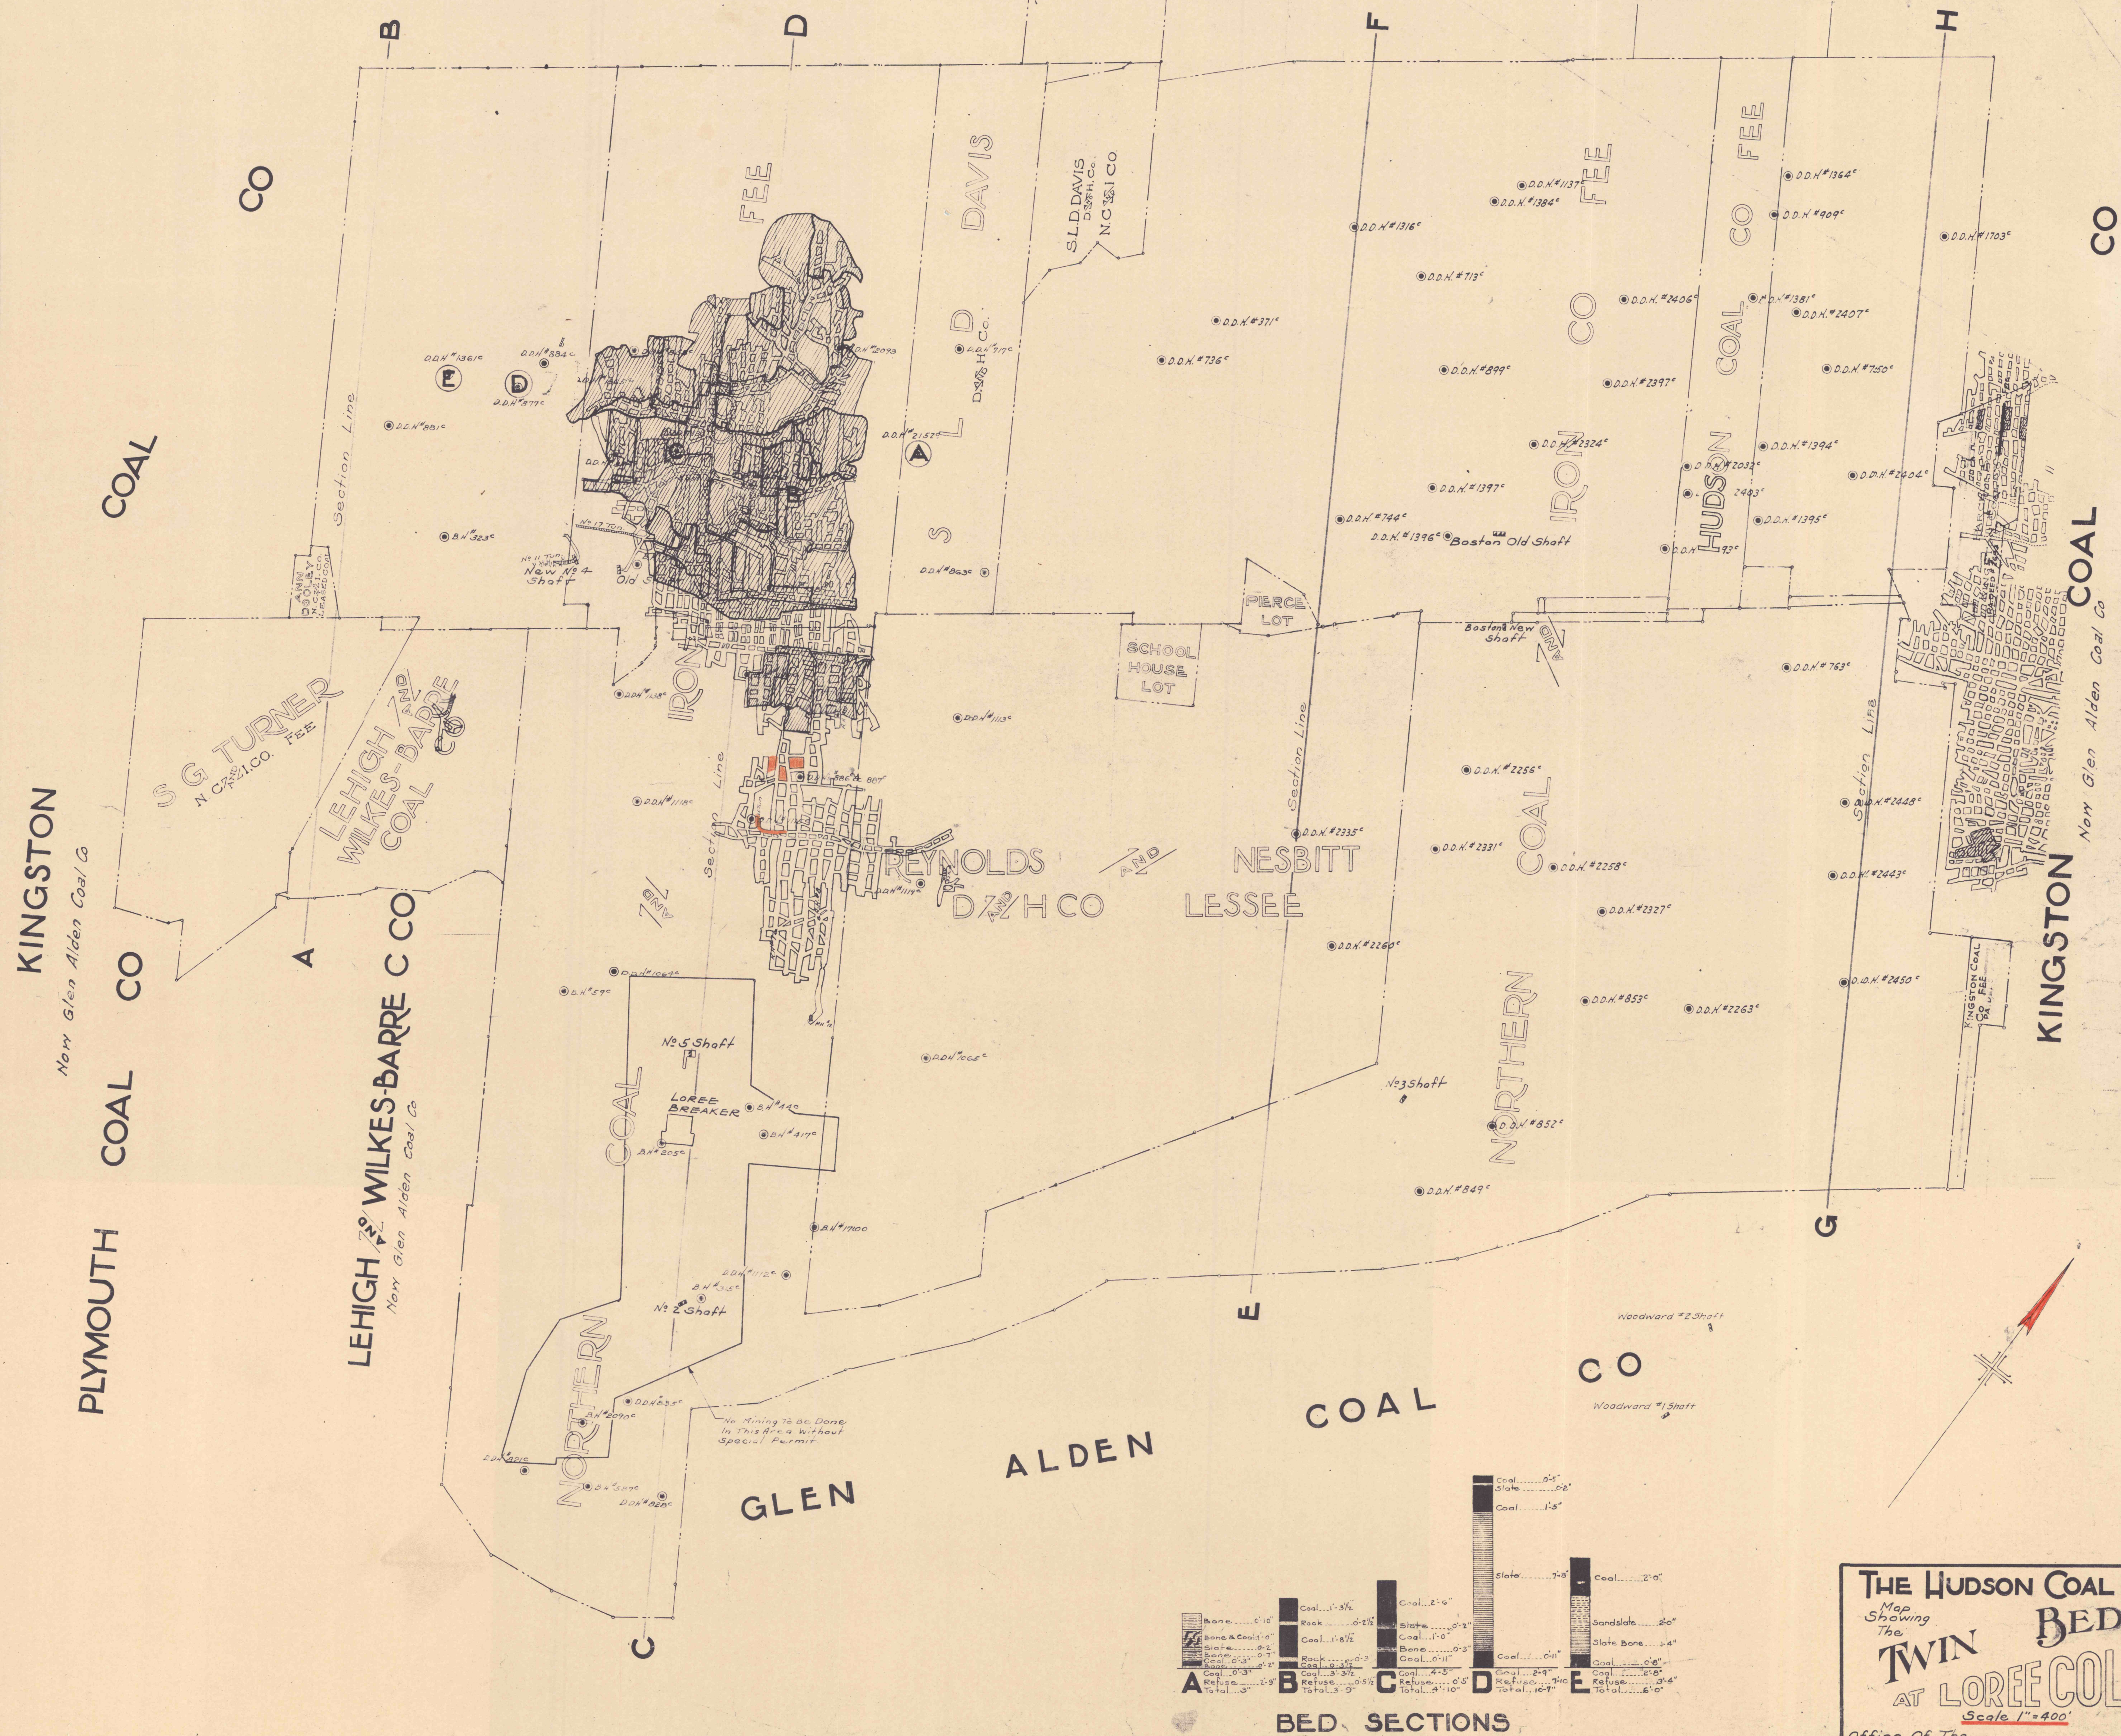


[illegible]

THE HUDSON COAL CO
Map
Showing
The
TWIN
BED
AT LOREE COLLY
Scale 1"=400'
Office of The
Forecast Dept
April 2, 1927.