DATE OF LAST SURVEY POSTED

No 2 Shaft			No 3 Shaft			No 4 Shaft			No 5 Shaft			Boston		
First Mining	Robbing	By Whom	First Mining	Robbing	By Whom	First Mining	Robbing	By Whom	First Mining	Robbing	By Whom	First Mining	Robbing	By Whom
1-20-27		H.B.	1-10-26	10-1-44	F.S.	9-17-27	12-27-26	H.B.	10-1-26		H.B.			
5-12-28		H.G.	1-22-32	—	E.C.	4-25-27		E.F.S.	2-23-27		H.K.			
10-1-31		H.B.				12-23-27	12-27	H.G.	9-28-28		B.F.S.			
9-5-44	9-5-44	F.S.				1-10-28	7-28	F.S.	9-1-28		H.G.			
10-16-44	10-16-44	K.M.				3-10-31	1-29	W.G.	1-18-30		H.G.			
10-6-44	—	F.S.					2-30	H.G.	11-1940		H.G.			
1-7-48	—	F.S.					8-31	W.G.	11-5-31		H.B.			
9-11-44		K.M.				4-18-32	4-32	H.B.	8-21-44	8-21-44	F.S.			
12-50		A.M.				8-14-34	8-14-44	F.S.	9-14-45	9-14-45	K.M.			
11-51	—	J.J.O.				9-14-45	9-14-45	K.M.	11-28-51	11-28-51	J.J.O.			
						9-27-47	12-31-46	E.C.	11-22-32	12-12	E.C.			
							1-48	K.M.						
							12-48	J.J.O.						
						9-29-49	10-49	K.M.						
						12-50	12-50	A.M.						
						11-21-51	11-21-51	J.J.O.						
						10-10-52	10-52	E.C.						

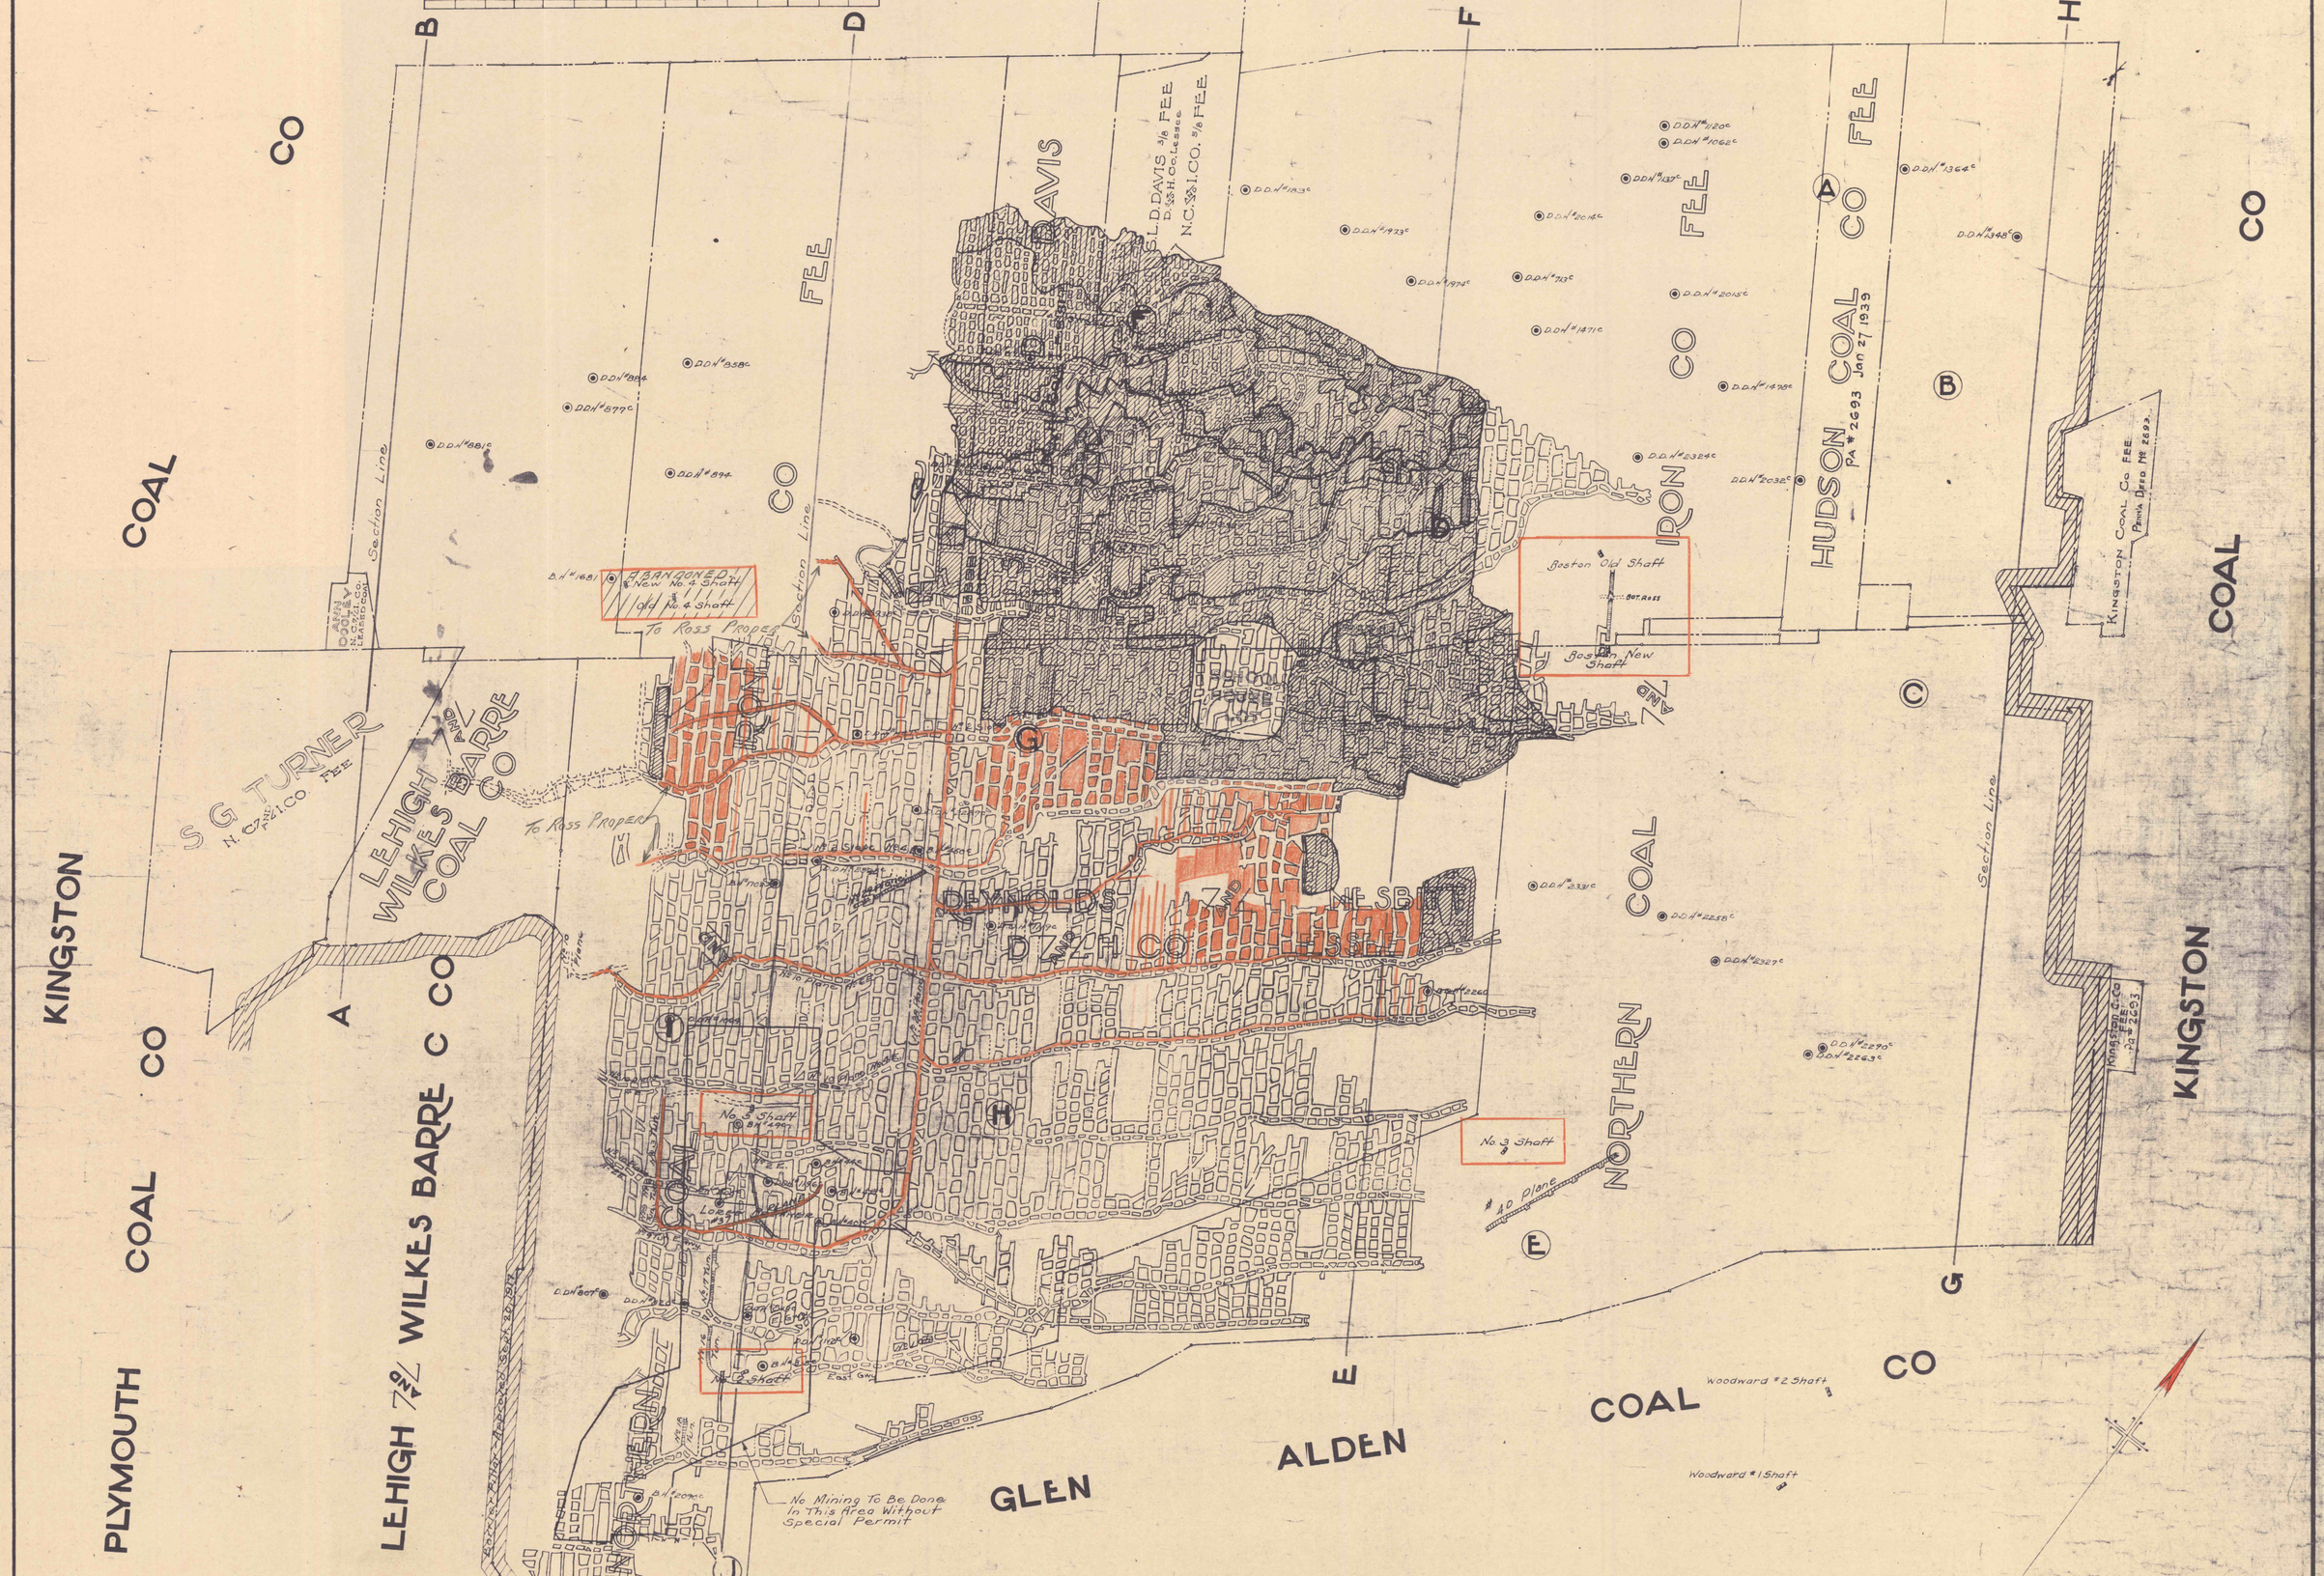

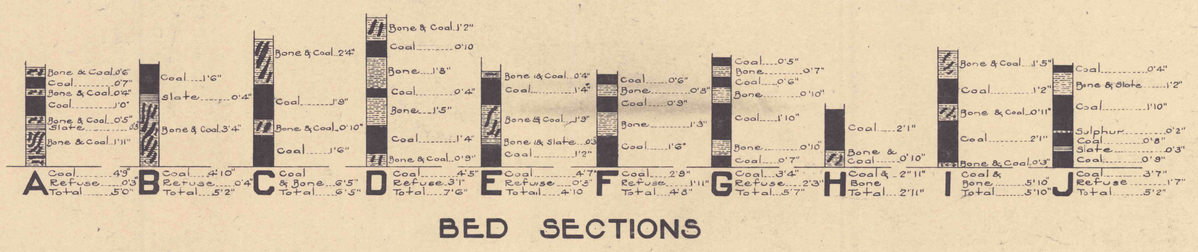

BED SECTIONS

THE HUDSON COAL CO

Map Showing The

TOP ROSS BED AT LOREE COLLY

Scale 1" = 400'

Office Of The Forecast Dept.

April 2, 1927.