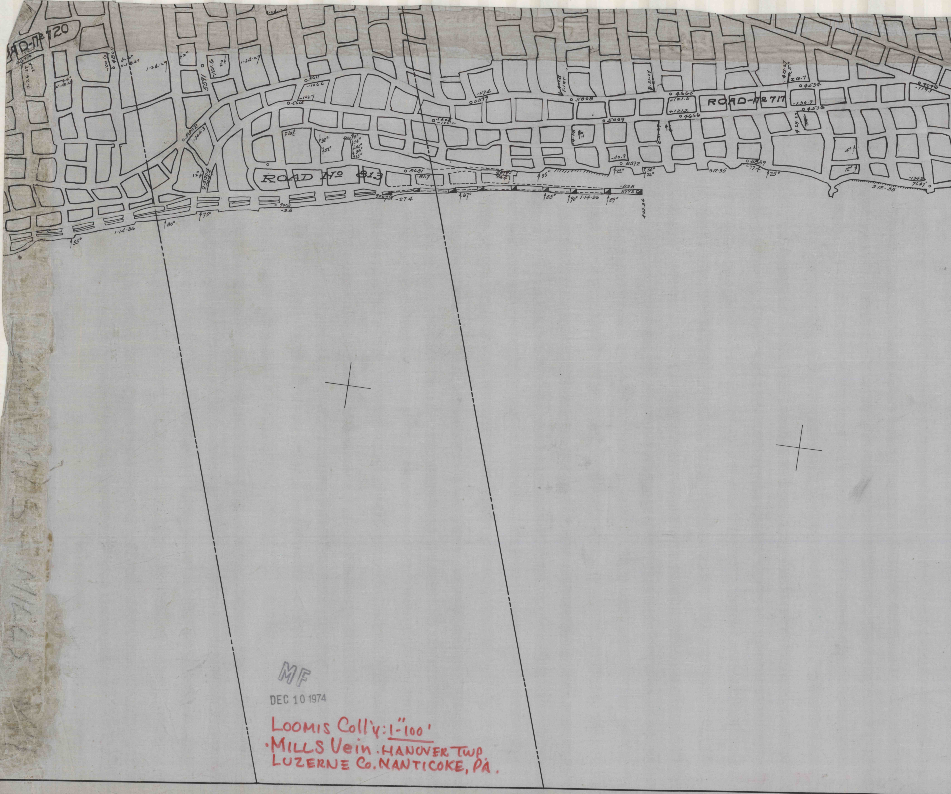
ROAD-No 720
ROAD No 813
ROAD-No 717
Flat
1-14-36
1-14-36
3-12-35
3-12-35
5002
5611
5615
5399
5008
5009
4665
4666
4534
4536
8592
8589
8681
9003
-3.8
-27.4
-81.7
-77.4
-40.9
80°
75°
55°
87°
85°
90°
89°
25°
22°
35°
12°
4°

MF
DEC 10 1974

LOOMIS Coll'y: 1"=100'
·MILLS Vein. HANOVER TWP
LUZERNE Co. NANTICOKE, PA.

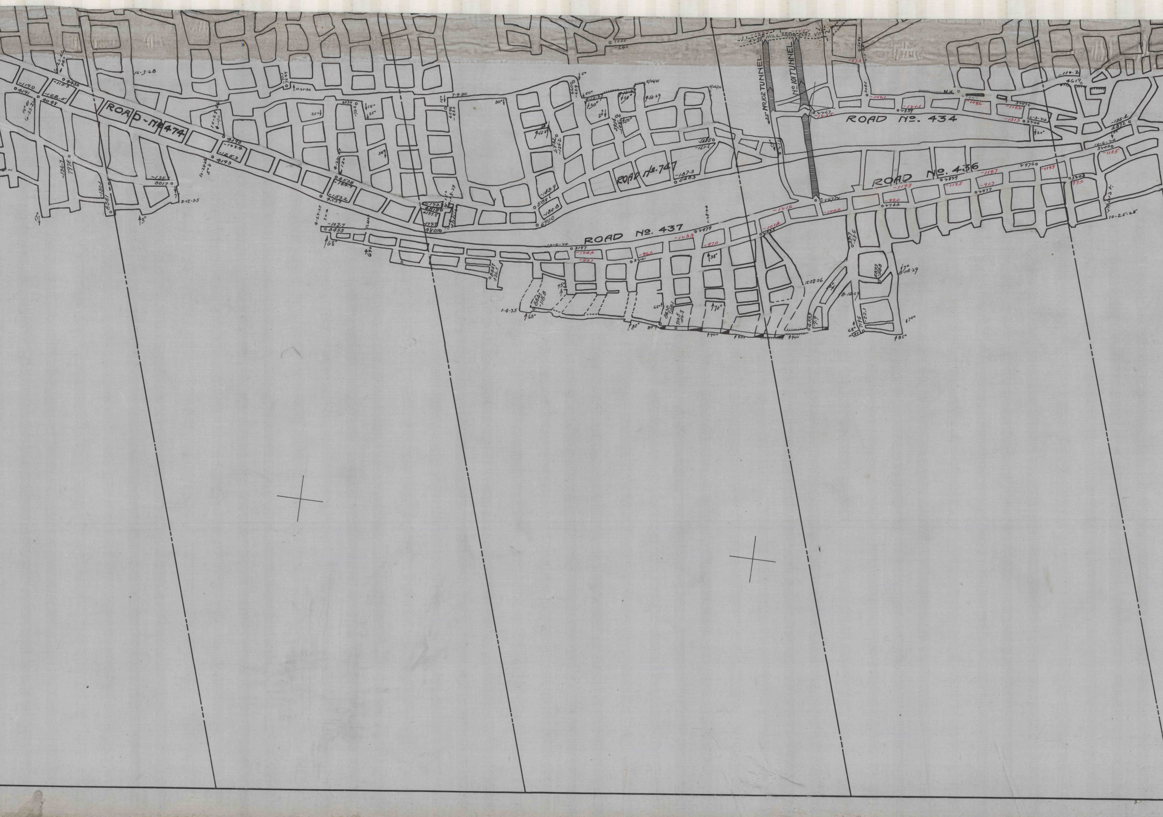
ROAD-No 474
ROAD No 747
ROAD No. 434
ROAD No. 436
ROAD No. 437
No 102 TUNNEL
No 101 TUNNEL
HILLMAN No 4297 VEIN
4298
-126.6
-125.2
-57.3
-102.1
2267
-123.5
3090
3085
S2850
-161.5
8/26/31
32°
15°

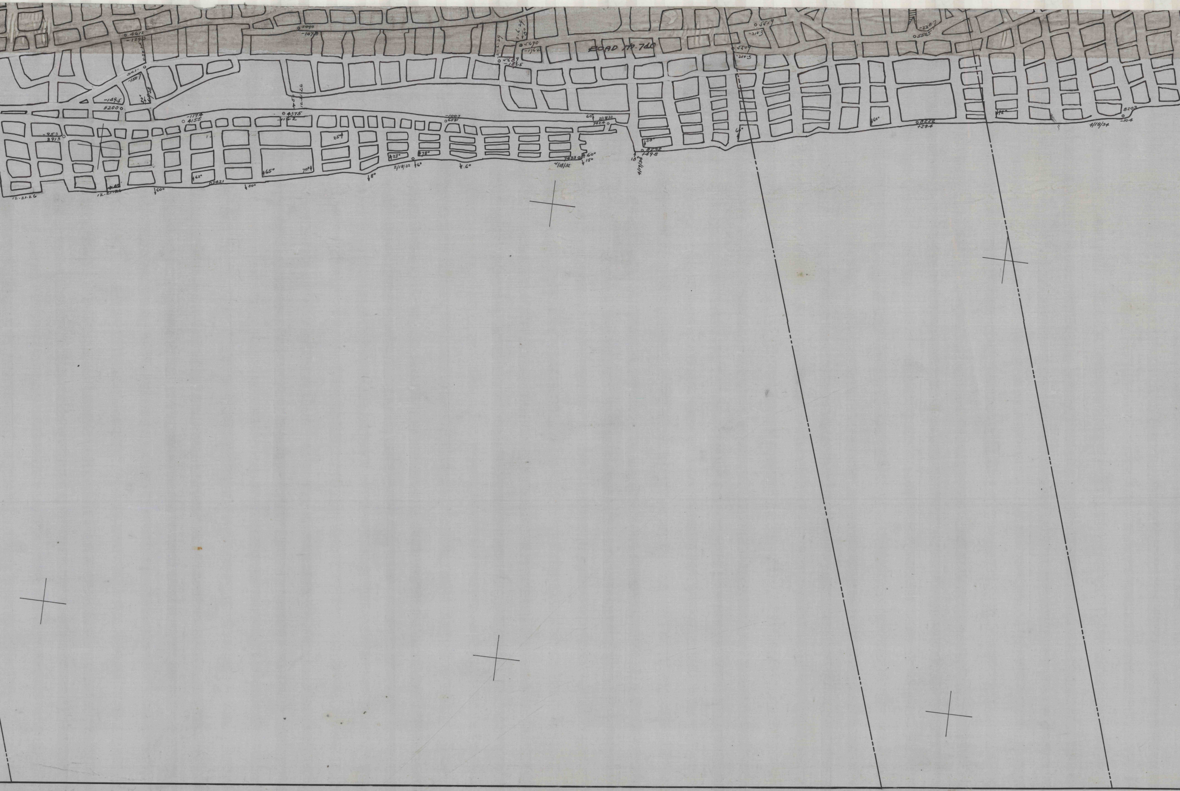
4612
-129.3
11-20-26
5090
-147.3
5689
-183.5
5690
-176.2
2-6-29
2-6-29
80°
ROAD 17-740
5519
-210.3
5509
-210.5
-228.7
5505
5611
-150.7
20°
6-9-28
-149.5
5200
12-21-26
50°
-117.4
4155
4375
-116.2
-100.7
6581
60°
2/18/32
7424
-95.3
3913
25°
23°
78°
65°
70°
63°
7421
50°
60°
45°
12-21-26
12-21-26
8°
2/18/32
6°
6°
7433
60°
15°
2/18/32
58°
8232
+49.8
18°
4/19/34
6°
60°
8222
+28.4
72°
8203
-10.4
4/18/34

OOMIS MILLS VEIN

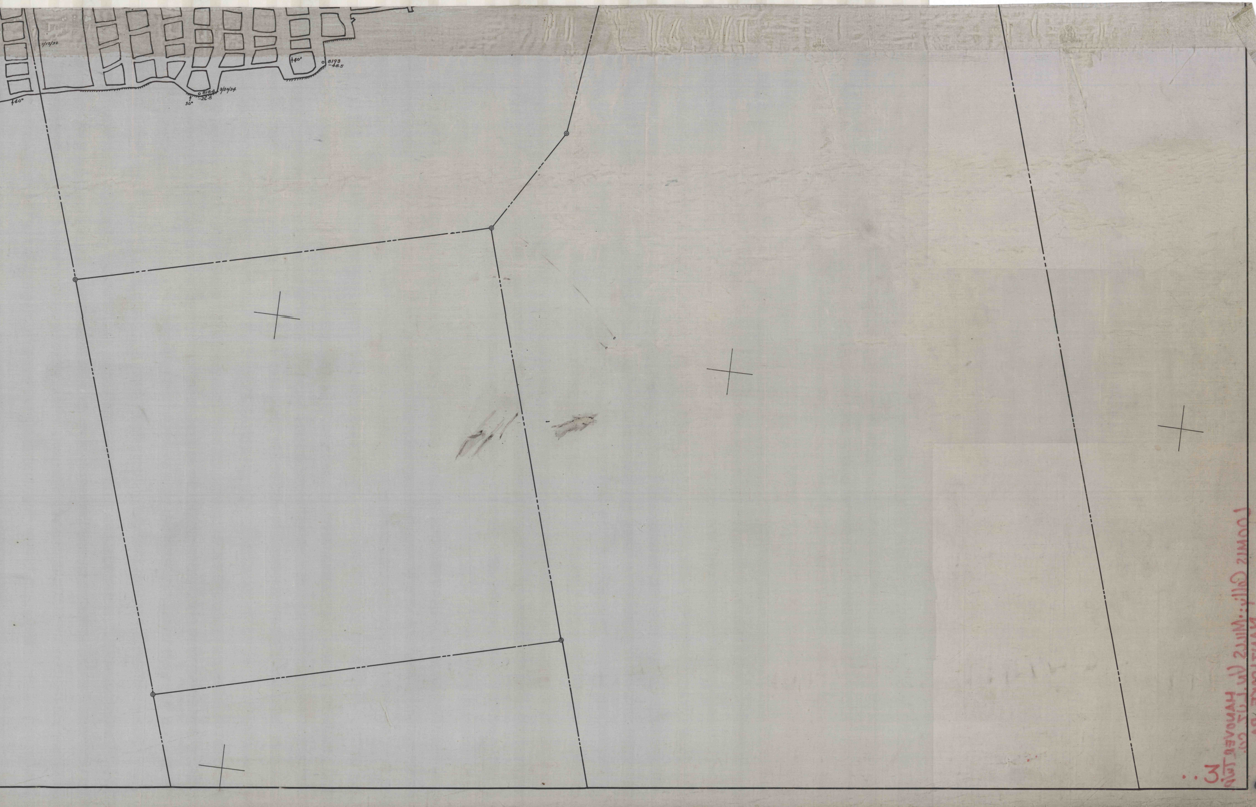
1/12/32
+40°
3/30/34
8184
-26.8
30°
+40°
8193
-48.5

LOOMIS - MILLS V-Y