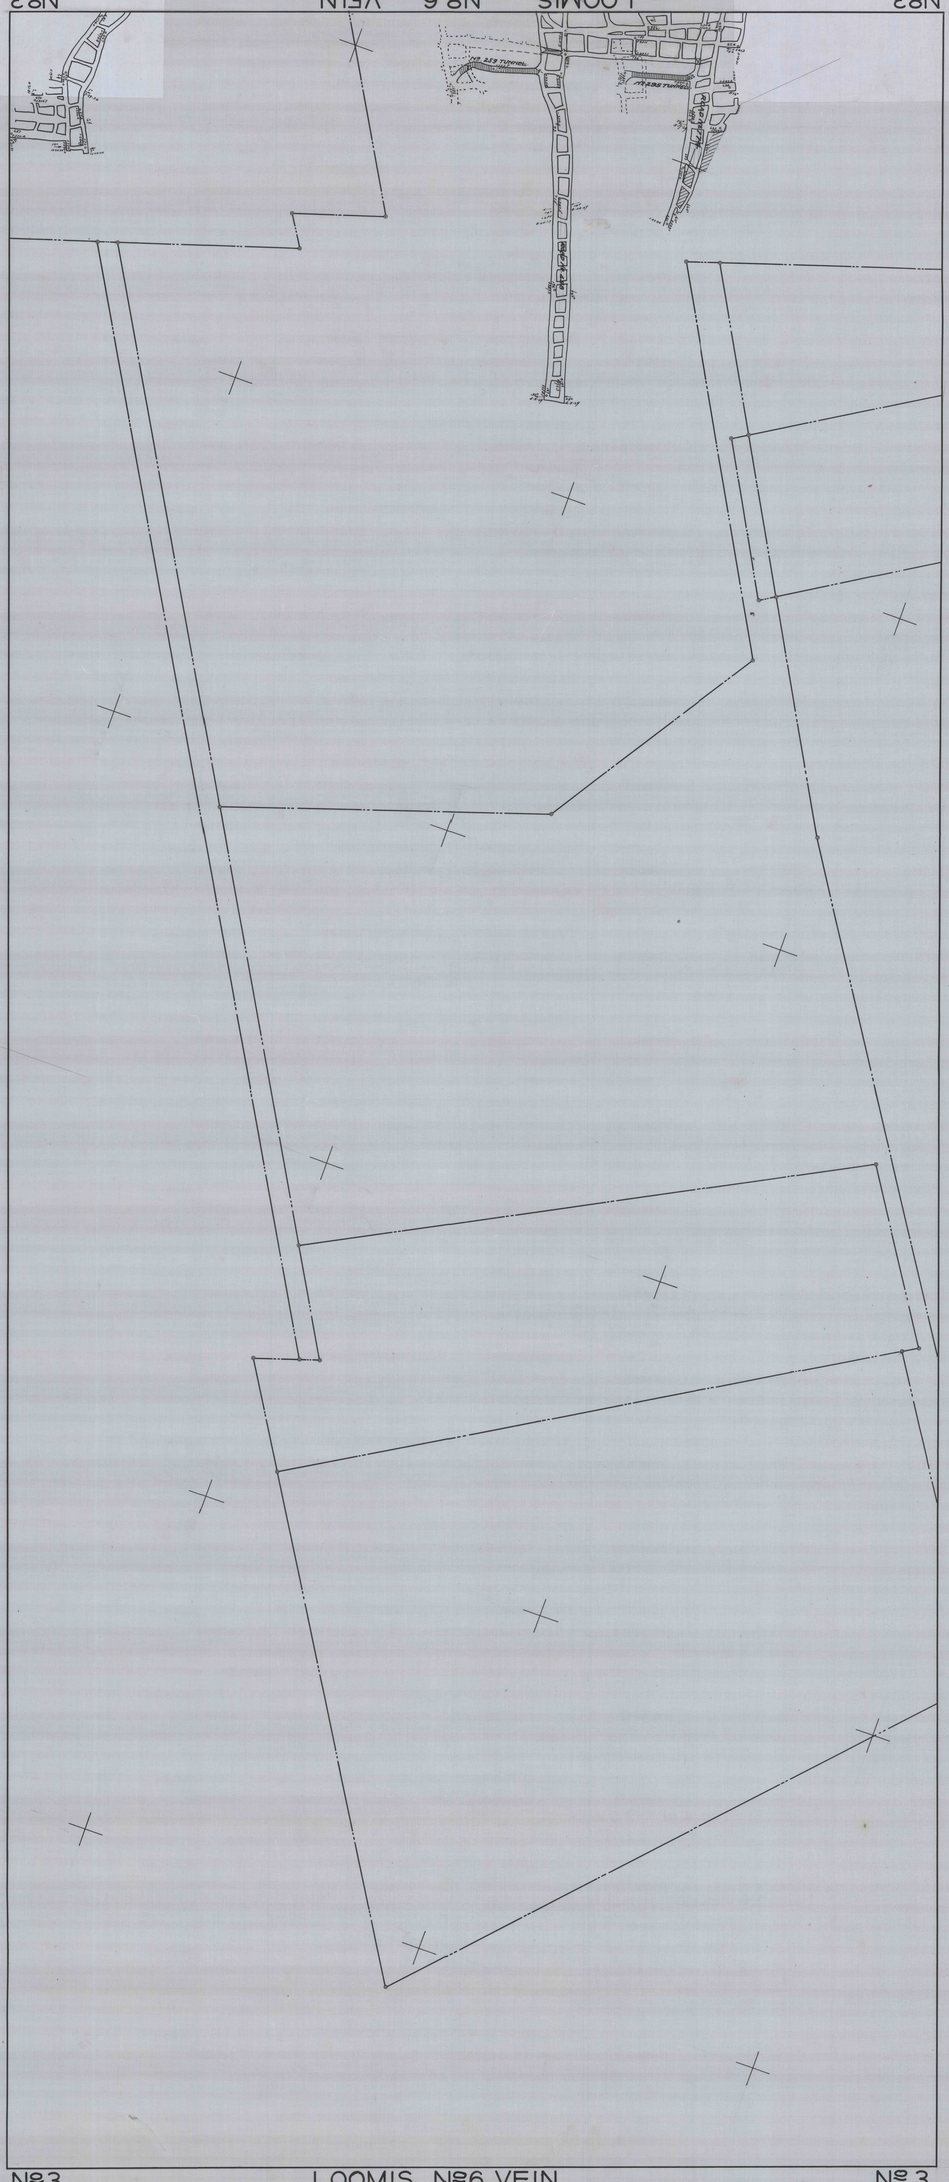

LOOMIS No 6 VEIN
COLL'Y; 1"-100'.. HANOVER TWP. LUZERNE COUNTY. NANTICOKE, PA..